


RETTET DEN 23 MARS 1935
 RETTET DEN 11 MARS 1935.
 RETTET DEN 7. MARS 1935
 RETTET DEN 5 FEBRUAR.
 RETTET DEN 4 DECEMBER 1934
 RETTET DEN 3 JULI 1934.
 RETTET DEN 16 JUNI 1934.
 RETTET DEN 2. JUNI 1934.
 % NAKSTOV - SKIBSVARER
 4 MARS 1934.

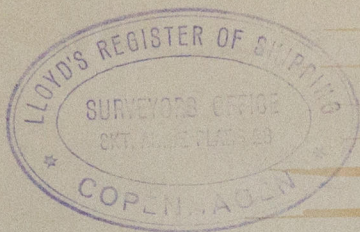


M/V "Canada"

Nakskov. Yard. N° 62.

General Arrangement.

Profile. ✓

RETAIN

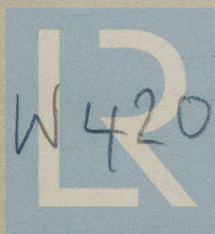

© 2019

— 00576

Lloyd's Register
Foundation