

11.3.29  
25/4/28


# DECK PLANS . N° 291. 295.

SCALE  $\frac{1}{8}$ " = ONE FOOT.


NOTE:- HATCH CORNER PLATES THICKENED (EXCEPT AT ENDS)  
IN LIEU OF DOUBLINGS.

## COMPLETE SUPERSTRUCTURE DECK.

## FORECASTLE DECK.

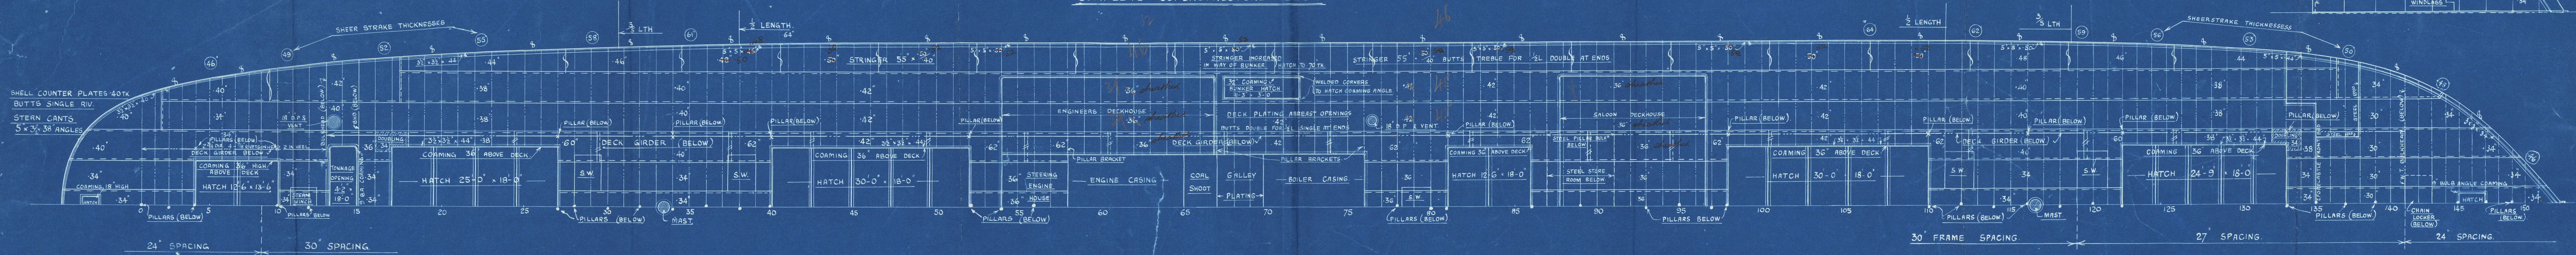

## SECOND DECK.

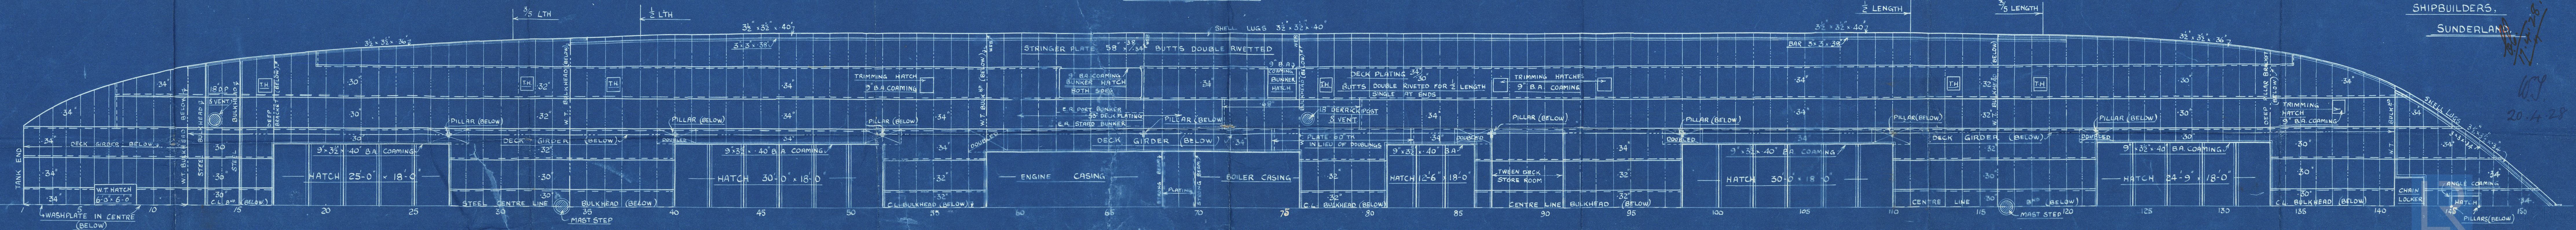

SIR JOHN PRIESTMAN & CO.  
SHIPBUILDERS,  
SUNDERLAND.

W421-0026



(3)

SUNDERLAND

SIR JOHN PRIESTMAN & CO.


S. S. No. 291

DECKS.

S/S ASHLEA

SUNDERLAND RPT. NO. 29949

RETAIN

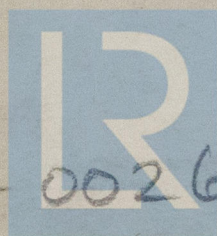

© 2019

Lloyd's Register  
Foundation

W421-0026