
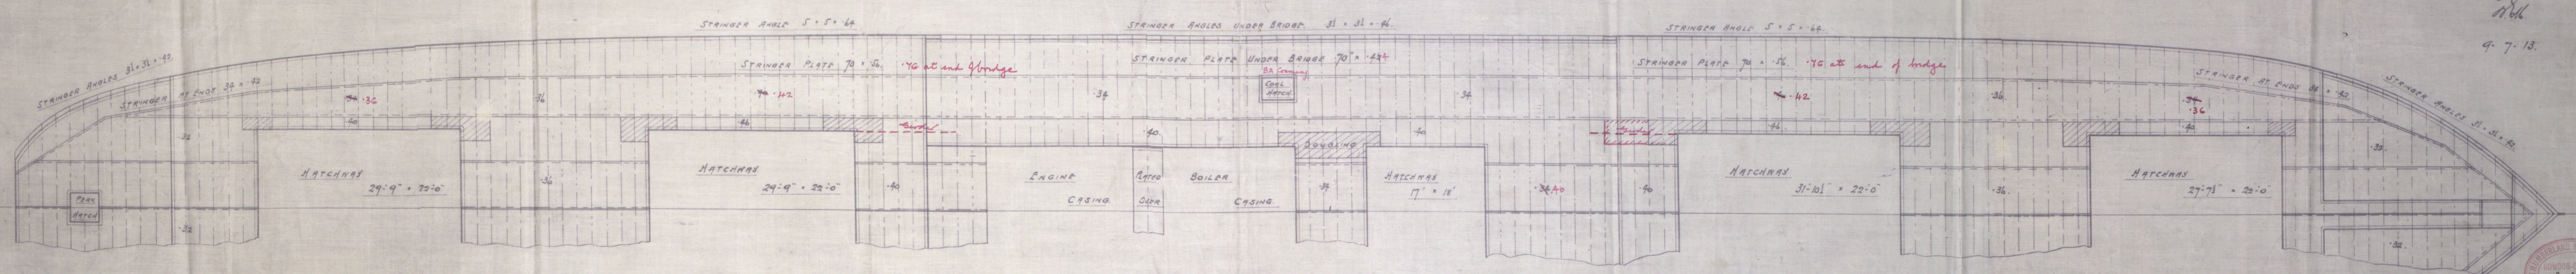
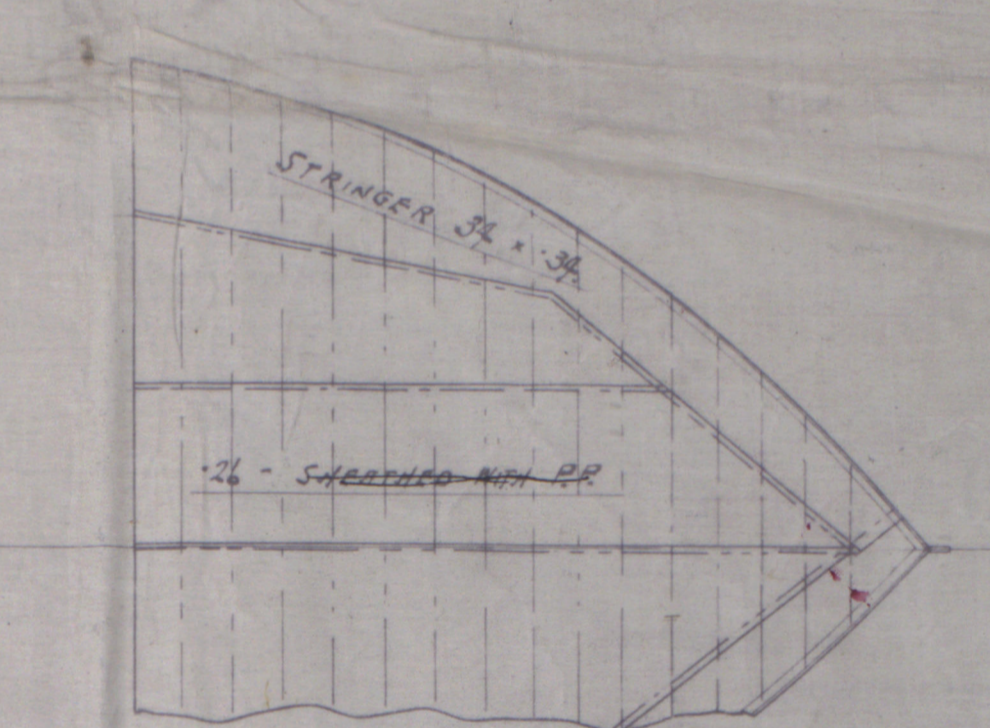
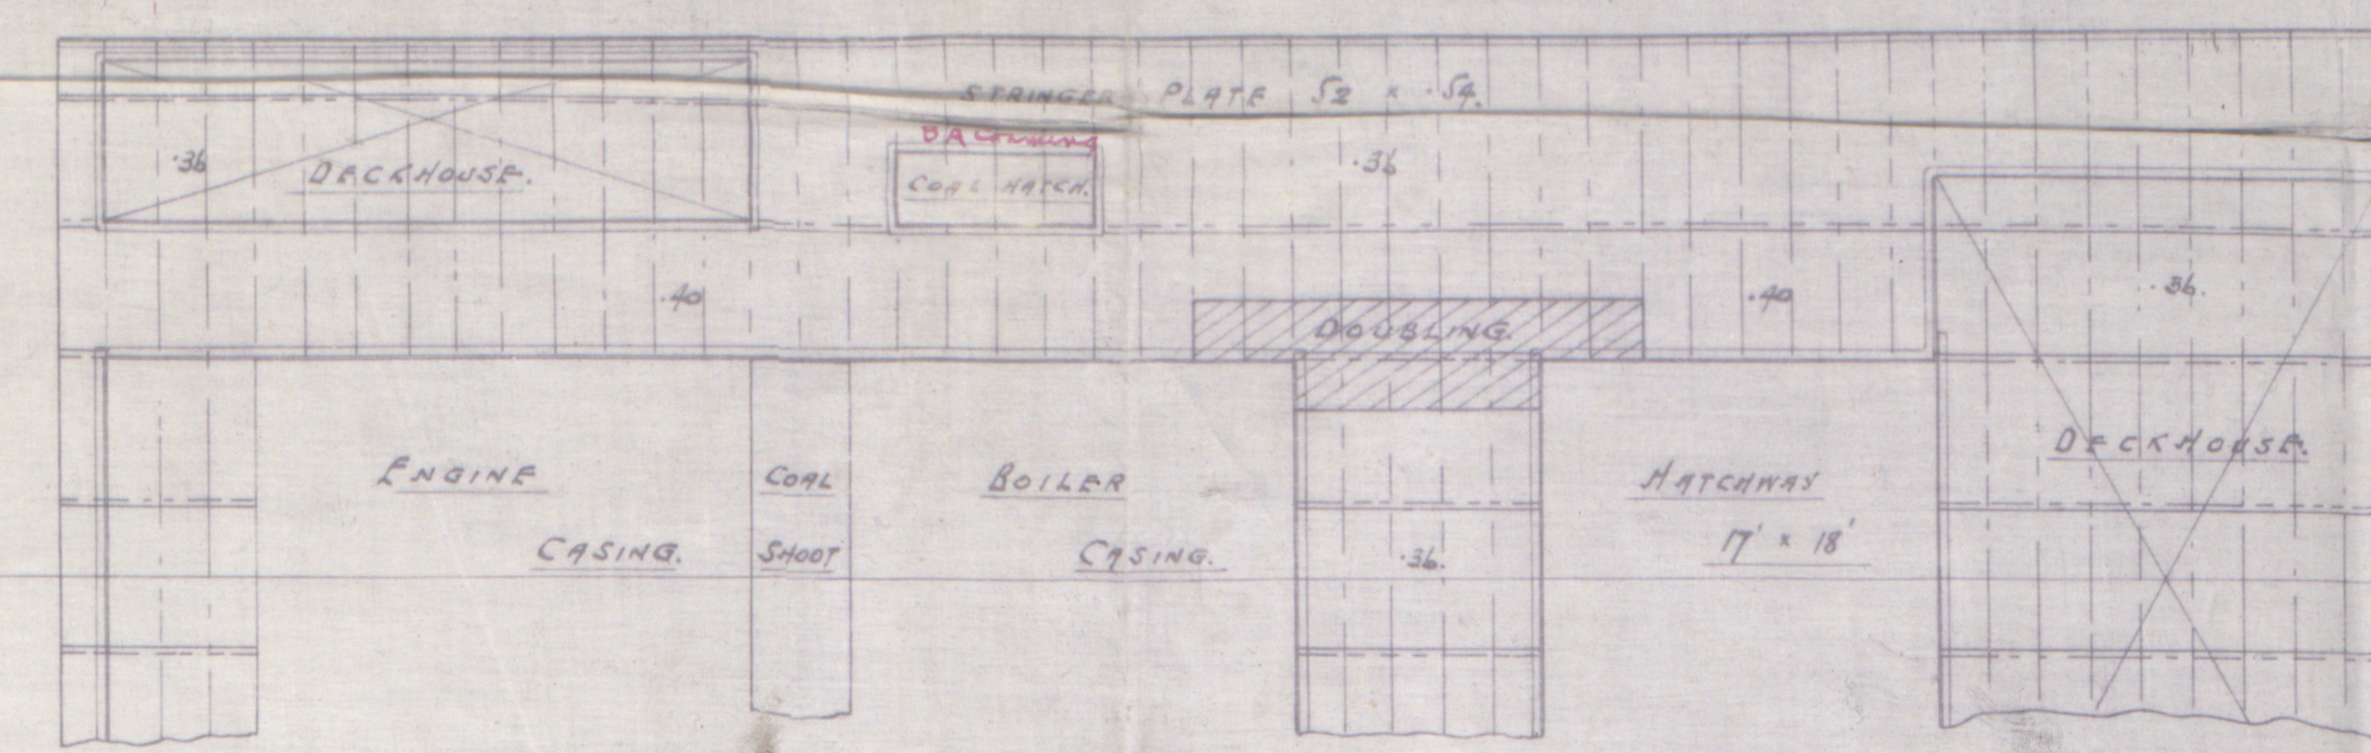
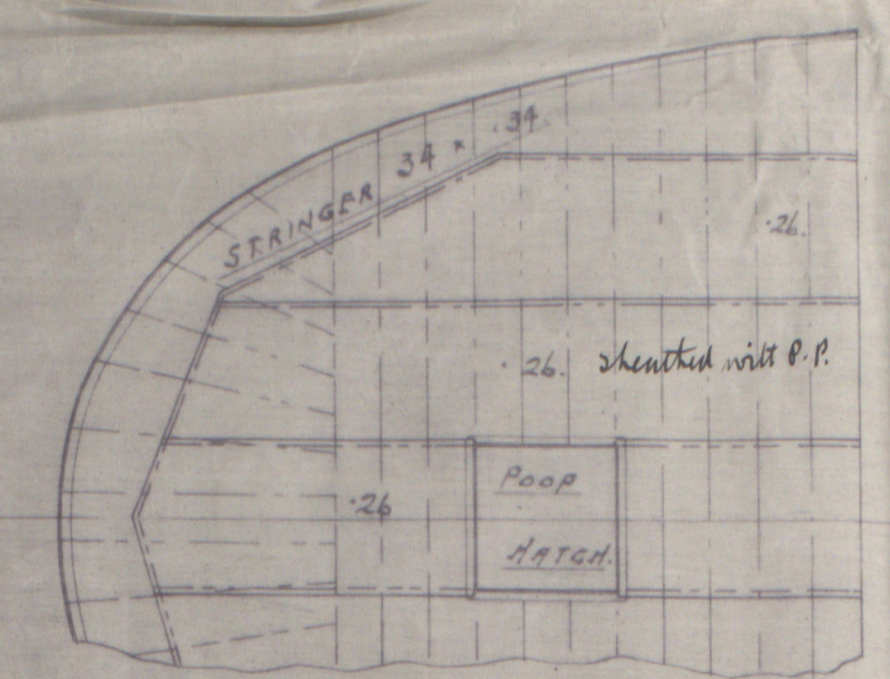


15.7.13
14.8.13
21.8.13
2.9.13
17.9.13

PROFILE & DECK PLANS - S.S. 218.
370' B.P. x 51' B x 28'-9" M.D. SCALE 1/8" = 1 FT.

21 JUL 1913


BELVIN

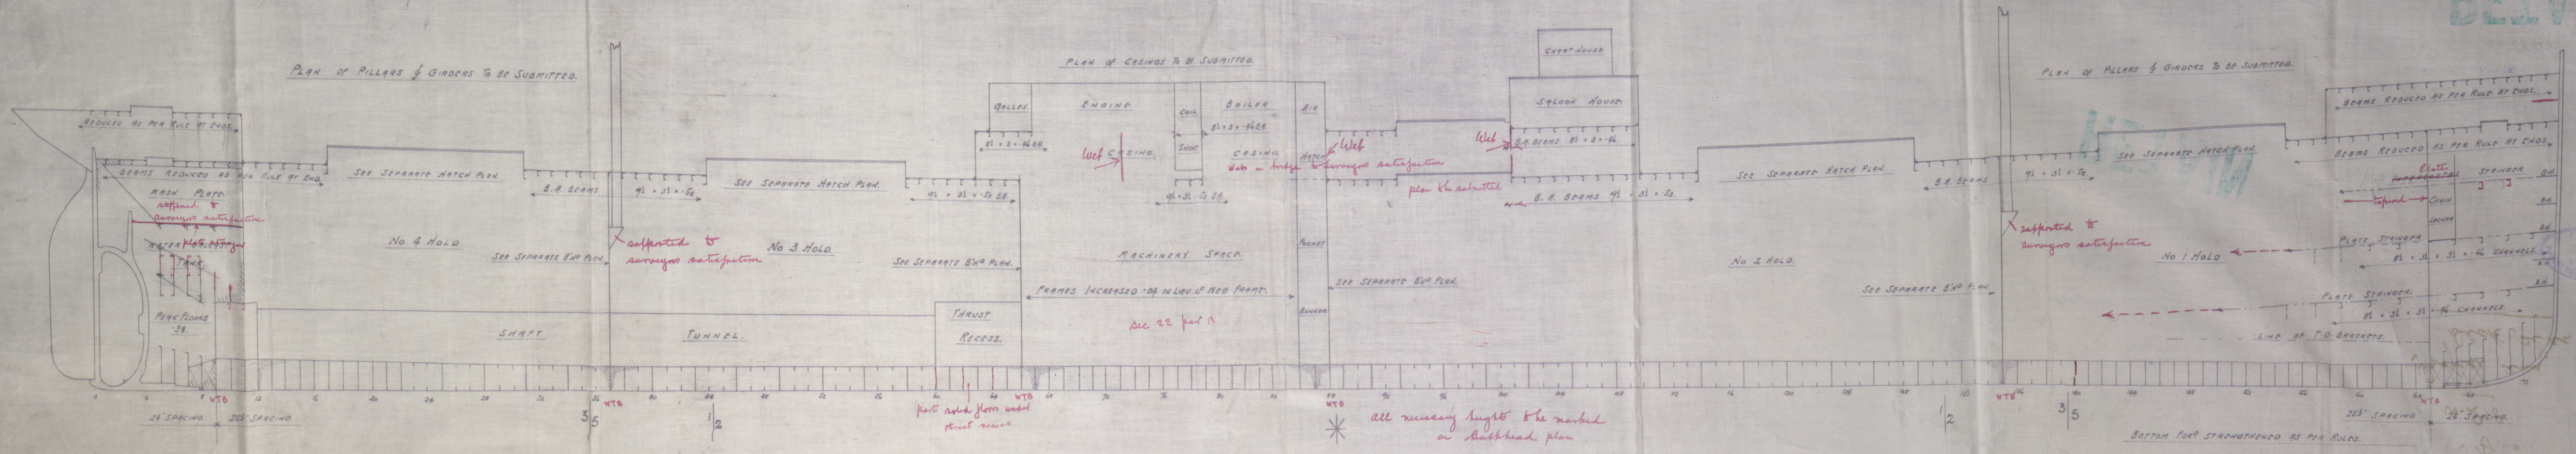

PLAN OF HATCHWAYS & CASINGS TO BE SUBMITTED.

586
9.7.13


15 JUL 1913

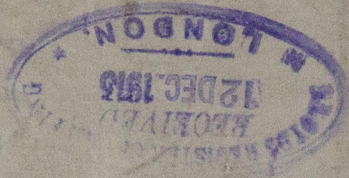

Northumberland
S. & Co.

to 218

Profile and
Deck plan

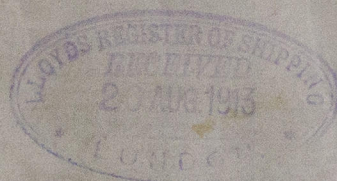

Ynton





S.S. "ELFLAND"

NEWCASTLE-ON-TYNE.


Report no. 66055.

RETAIN

RETAIN

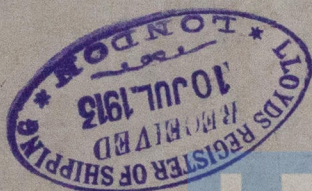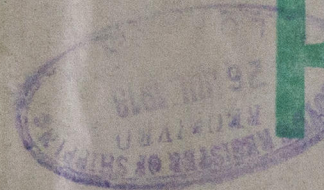

W421-0094

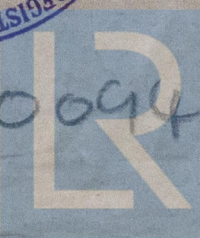

© 2019

Lloyd's Register
Foundation