

Do all the Frames extend to the top height in the Poop? Long? Raised Quarter Deck? Bridge House? Yes. Forecastle?
 To what height do the Reverse Frames extend? Bulk single frames
 Has the Poop or Raised Quarter Deck an efficient Iron Bulkhead at the fore end? yes
 Give particulars of the means for closing the openings in Bulkhead. Storm boards full height in
 Is the Poop or Raised Quarter Deck connected with the Bridge House? 16 Has the Bridge House an efficient Bulkhead at the fore end?
 Give particulars of the means for closing the openings in Bulkhead. Steel hinged door.
 What is the thickness of the Bridge Front plating? 42 and Coaming plate?
 Give scantlings and spacing of the Stiffeners. 8/2 x 3 x .50 R.a. spaced 30 apart: brac
 Are bracket plates fitted at each end of the Stiffeners? yes Are hor'l. brackets fitted connecting Bridge Bulk'd. with Bulwarks? yes
 Has the Bridge House an efficient Iron Bulkhead at the after end? yes
 How are the openings closed? Steel hinged doors
 Is the Forecastle at least as high as the main or top-gallant rail? yes Has the Forecastle an efficient Iron or Wood Bulk'd. at after end?
 Are the Engine and Boiler openings covered by a Bridge, Poop, Raised Quarter Deck, or enclosed by a Strong Iron or Steel Deckhouse? yes, prop.
 If the openings are not so protected are the exposed parts of the Casings efficiently constructed? yes
 Give thickness of plating; scantlings and spacing of Stiffeners
 What is the height of the exposed Casings? ✓ Are suitable means provided for closing all openings in them in bad weather?
 Are the Weather Deck Hatchways efficiently constructed and at least equal to the requirements of Section 28 of the Rules for 1904-5? Give particulars below:— Sill hatchets.

Position and Size.		Fwd. 5.0 x 10.0 (under side of deck)								
Item.		Ship.	Rule.	Ship.	Rule.	Ship.	Rule.	Ship.	Rule.	Ship.
COAMING.	Height above top of DECK	2.1								
Thickness	{ Sides..... Ends.....	.44								
SHIFTING BEAMS OR WEB PLATES.	{ Number Section and Scanlings Material	NONE								
* FORE AND AFTERS.	{ Number Section and Scanlings Material									
HATCHES	Thickness	Hinged etc not closed								
	Remarks.....									

* The depth of Fore and Afters should be stated from the underside of the hatches in all cases.

(If the sill of the lowest side scuttle will be less than 6 inches above the Indian Summer Load Line if assigned under the tables, state vertical distance from top of deck at side amidships to lower edge of lowest side scuttle.)

The following information is to be given in all Cases of vessels dealt with under Paras. 11, 12 (under 15 feet Moulded depth) and under Shelter Deck
What is the thickness of the Bridge Sheerstrake? Strake between Main and Bridge Sheerstrakes?

Delete the words { The Crew are berthed in the bridge house.
that do not apply { The arrangements to enable them to get backwards and forwards from their quarters are, are not satisfactory.

Length of Bulwarks in well 53 ft + 142 aft ✓

Area of Freeing Ports required by Para. 11 (e) each side of vessel =

Ft. Tenths. Ft. Tenths. No.

Fore well 3' x 1.58 x 3 ✓ Freeing Ports
aft 3.45 x 1.62 x 5 ✓ (each side of vessel) =


Sq. ft. 10.75 } 3.47 each

14.225 Sq. ft.

28.07 Sq. ft.

28.05 Sq. ft.

Total deficiency or excess = Sq. ft.

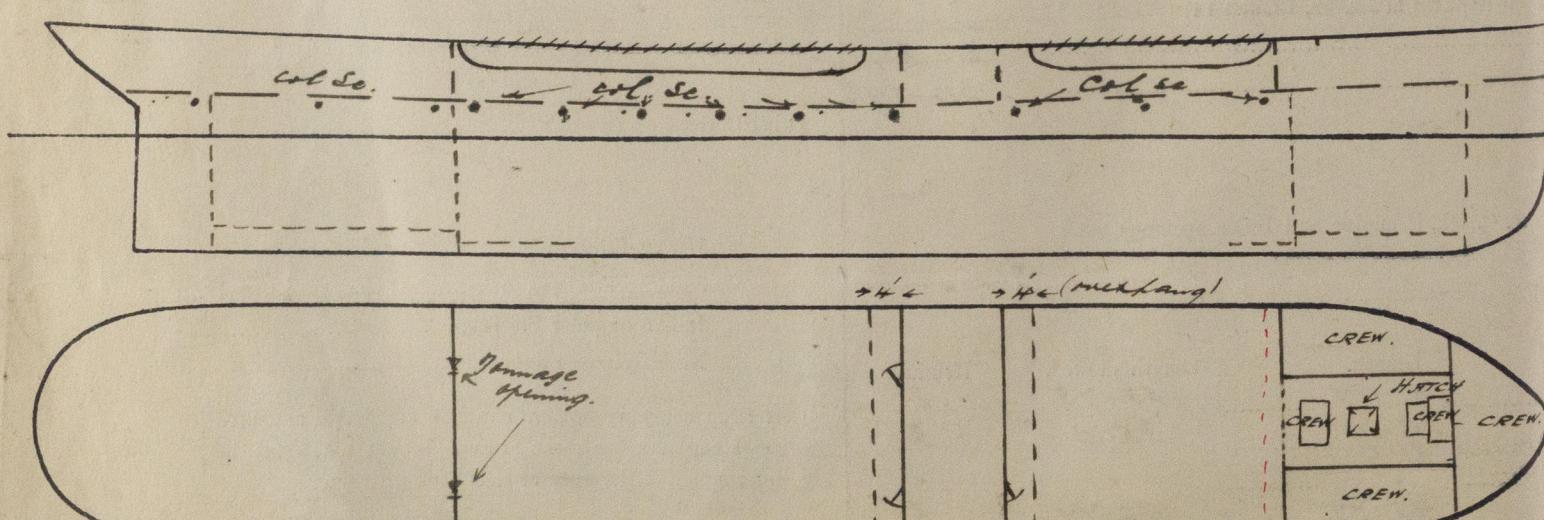

Show hereon line of Floors or Tank Top with position of any Breaks in same; also height of Peak Tank tops, &c., &c.

State any special features in the construction of the Vessel

Tankers. Approved plans in

Builder's name and yard number

Sir W.G. Armstrong, Whitworth & Co. Ltd

Names of sister vessels ✓

Owners British Tankers Limited.

, Address

Fee £ 10 apiece:-

Received by me

See H.R. Report

© 2019

Lloyd's Register Foundation