


STATIONARY BUCKET DREDGER
 DIM^s 165'-0" BP x 34'-0" x 14'-0" MLD
 CLASS LLOYDS 100 A1/DREDGER

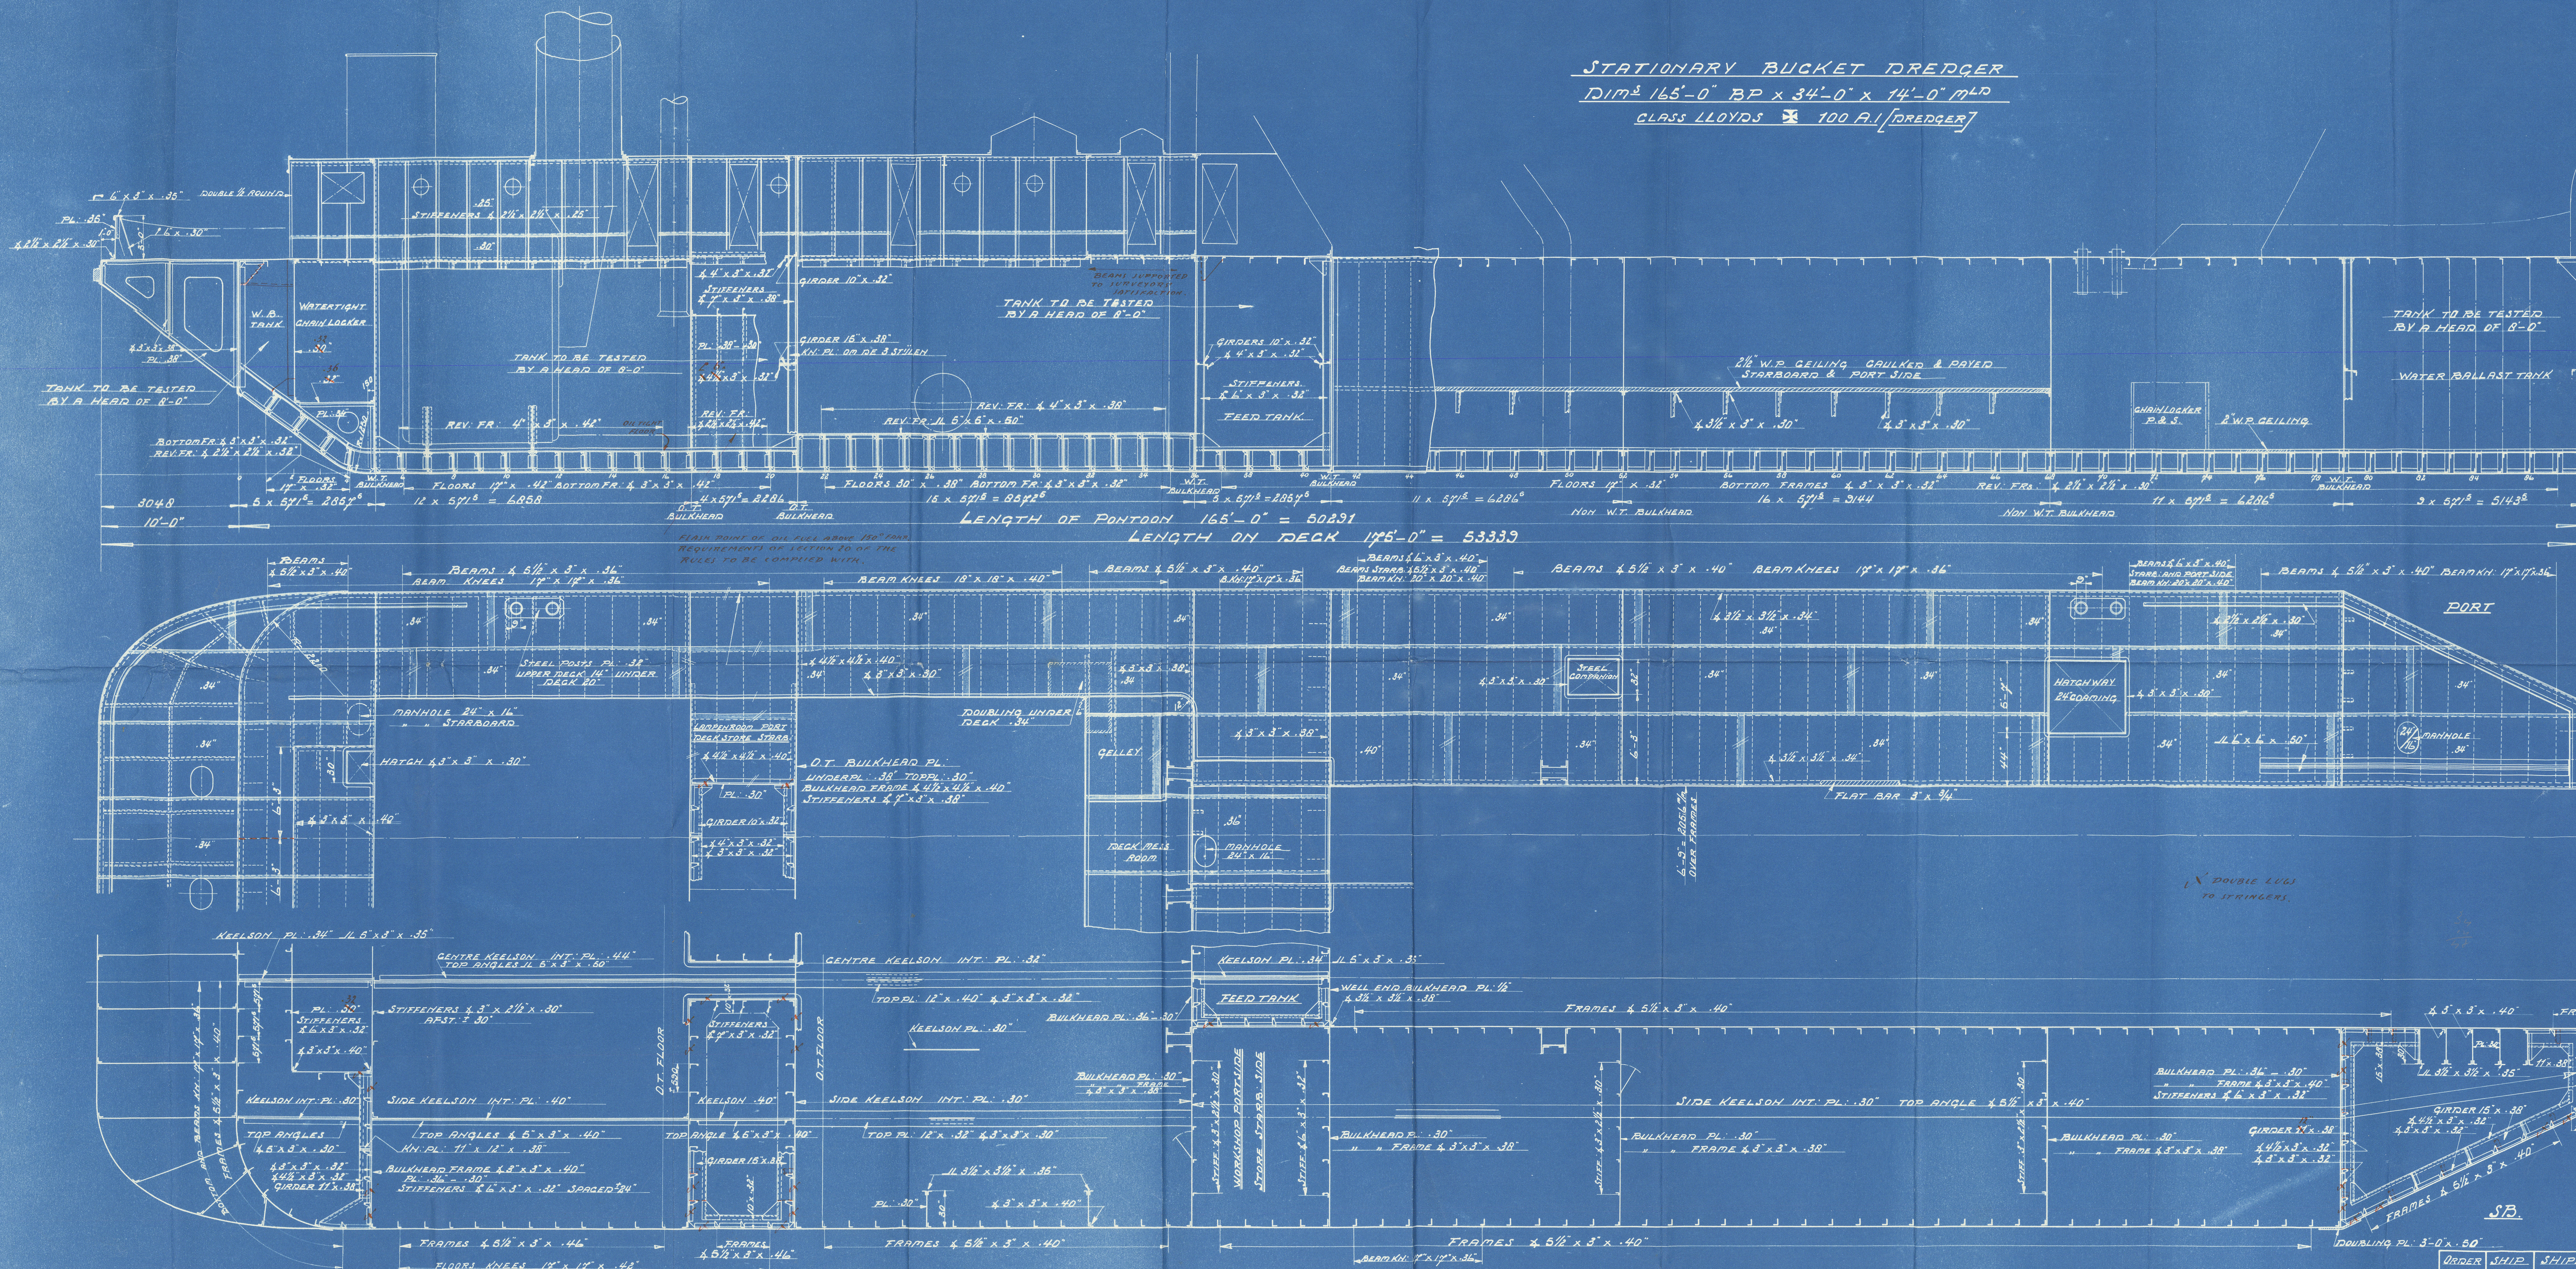

ORDER NO.	SHIP NAME	SHIPBUILDING AND ENGINEERING WORKS
6005	B20	SHEDRECHT DE KLOP ^{LD} HOLLAND
		LONGITUDINAL SECTION
		SCALE 1:1000
		DRAWN BY
		CHECKED
		DATE

738

N.V. SCHEEPSBOUW WERK &
MACHINEFABRIEK

"DE KLOP."

Ludger N° 520.

PROFILE & DECK.

Foremost Gunder

4

RETAIN



W425-02210

Lloyd's Register
Foundation