

PROFILE & DECK PLAN.

STEEL SCREW TRAWLER.



No 686

DIM^s 138'-4" BP x 23'-9" EX x 13'-6" MLD

SCALE 1/4" = 1 FOOT.

PLAN No. 4121
FOR ENCLOSURE TO
MESSRS LLOYD'S SURVEYORS
HULL FROM
COCHRANE & SONS, LTD.
SHIPBUILDERS, SELBY.
DATE 27/2/20

"Steam Trawler."
TO CLASS 100A1. FOR FISHING PURPOSES.

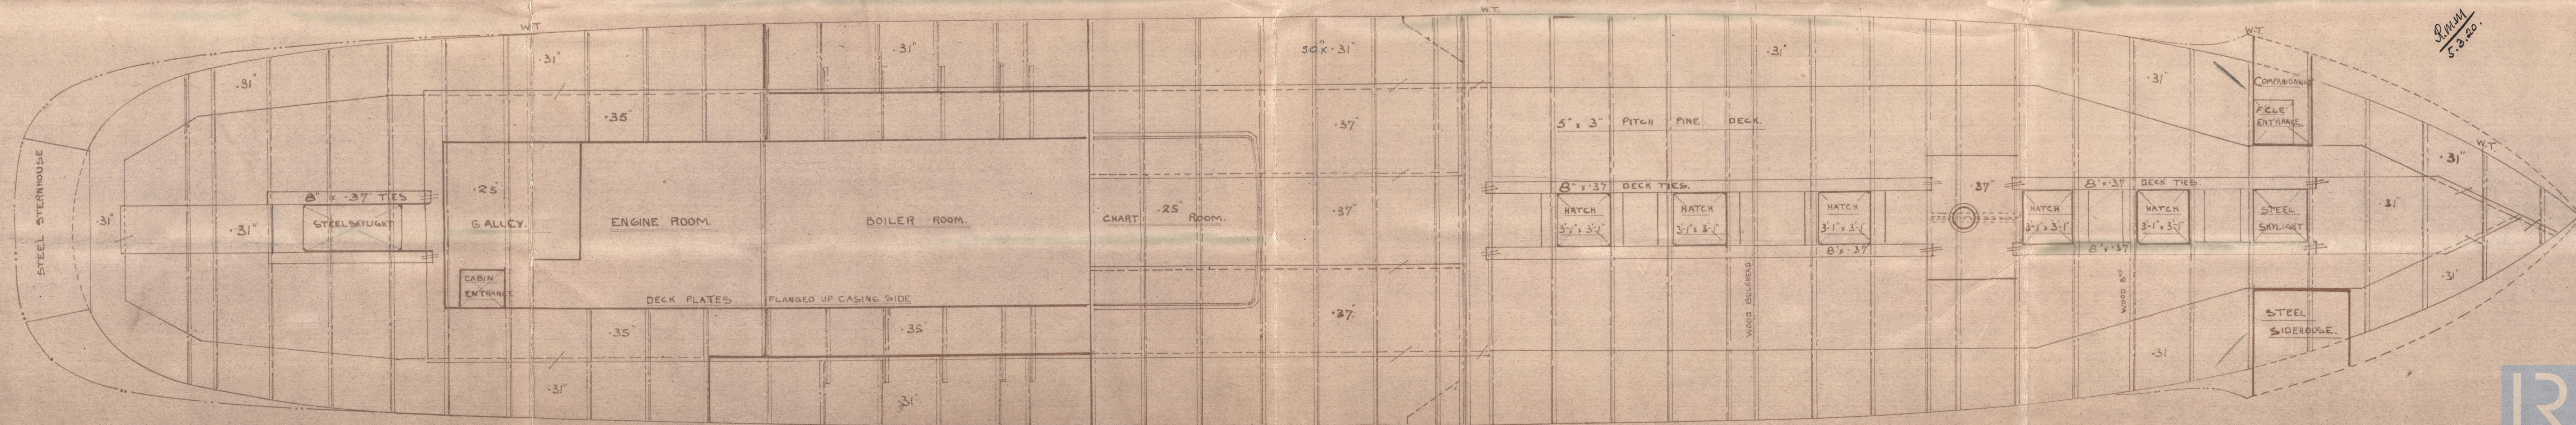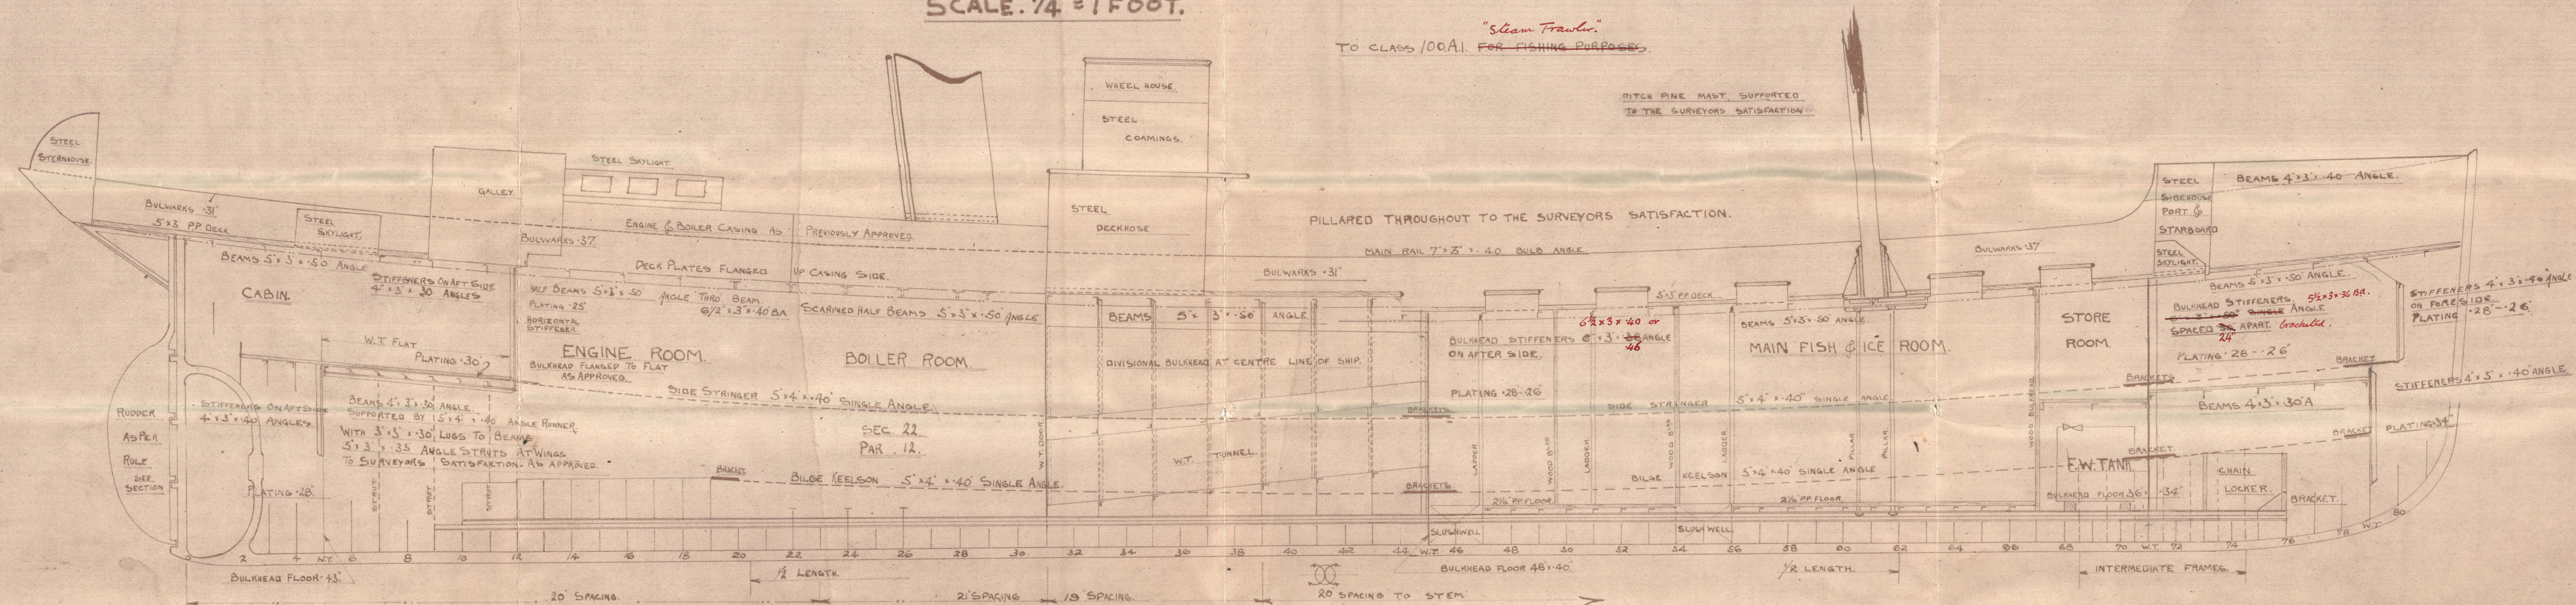

AMENDED

PROFILE & DECK PLAN.

COCHRANE & SONS LTD

No 686

S.S. "Rudyard Kipling"

Hull report No 32449.

RETAIN



© 2020

Lloyd's Register
Foundation

W428-0016