

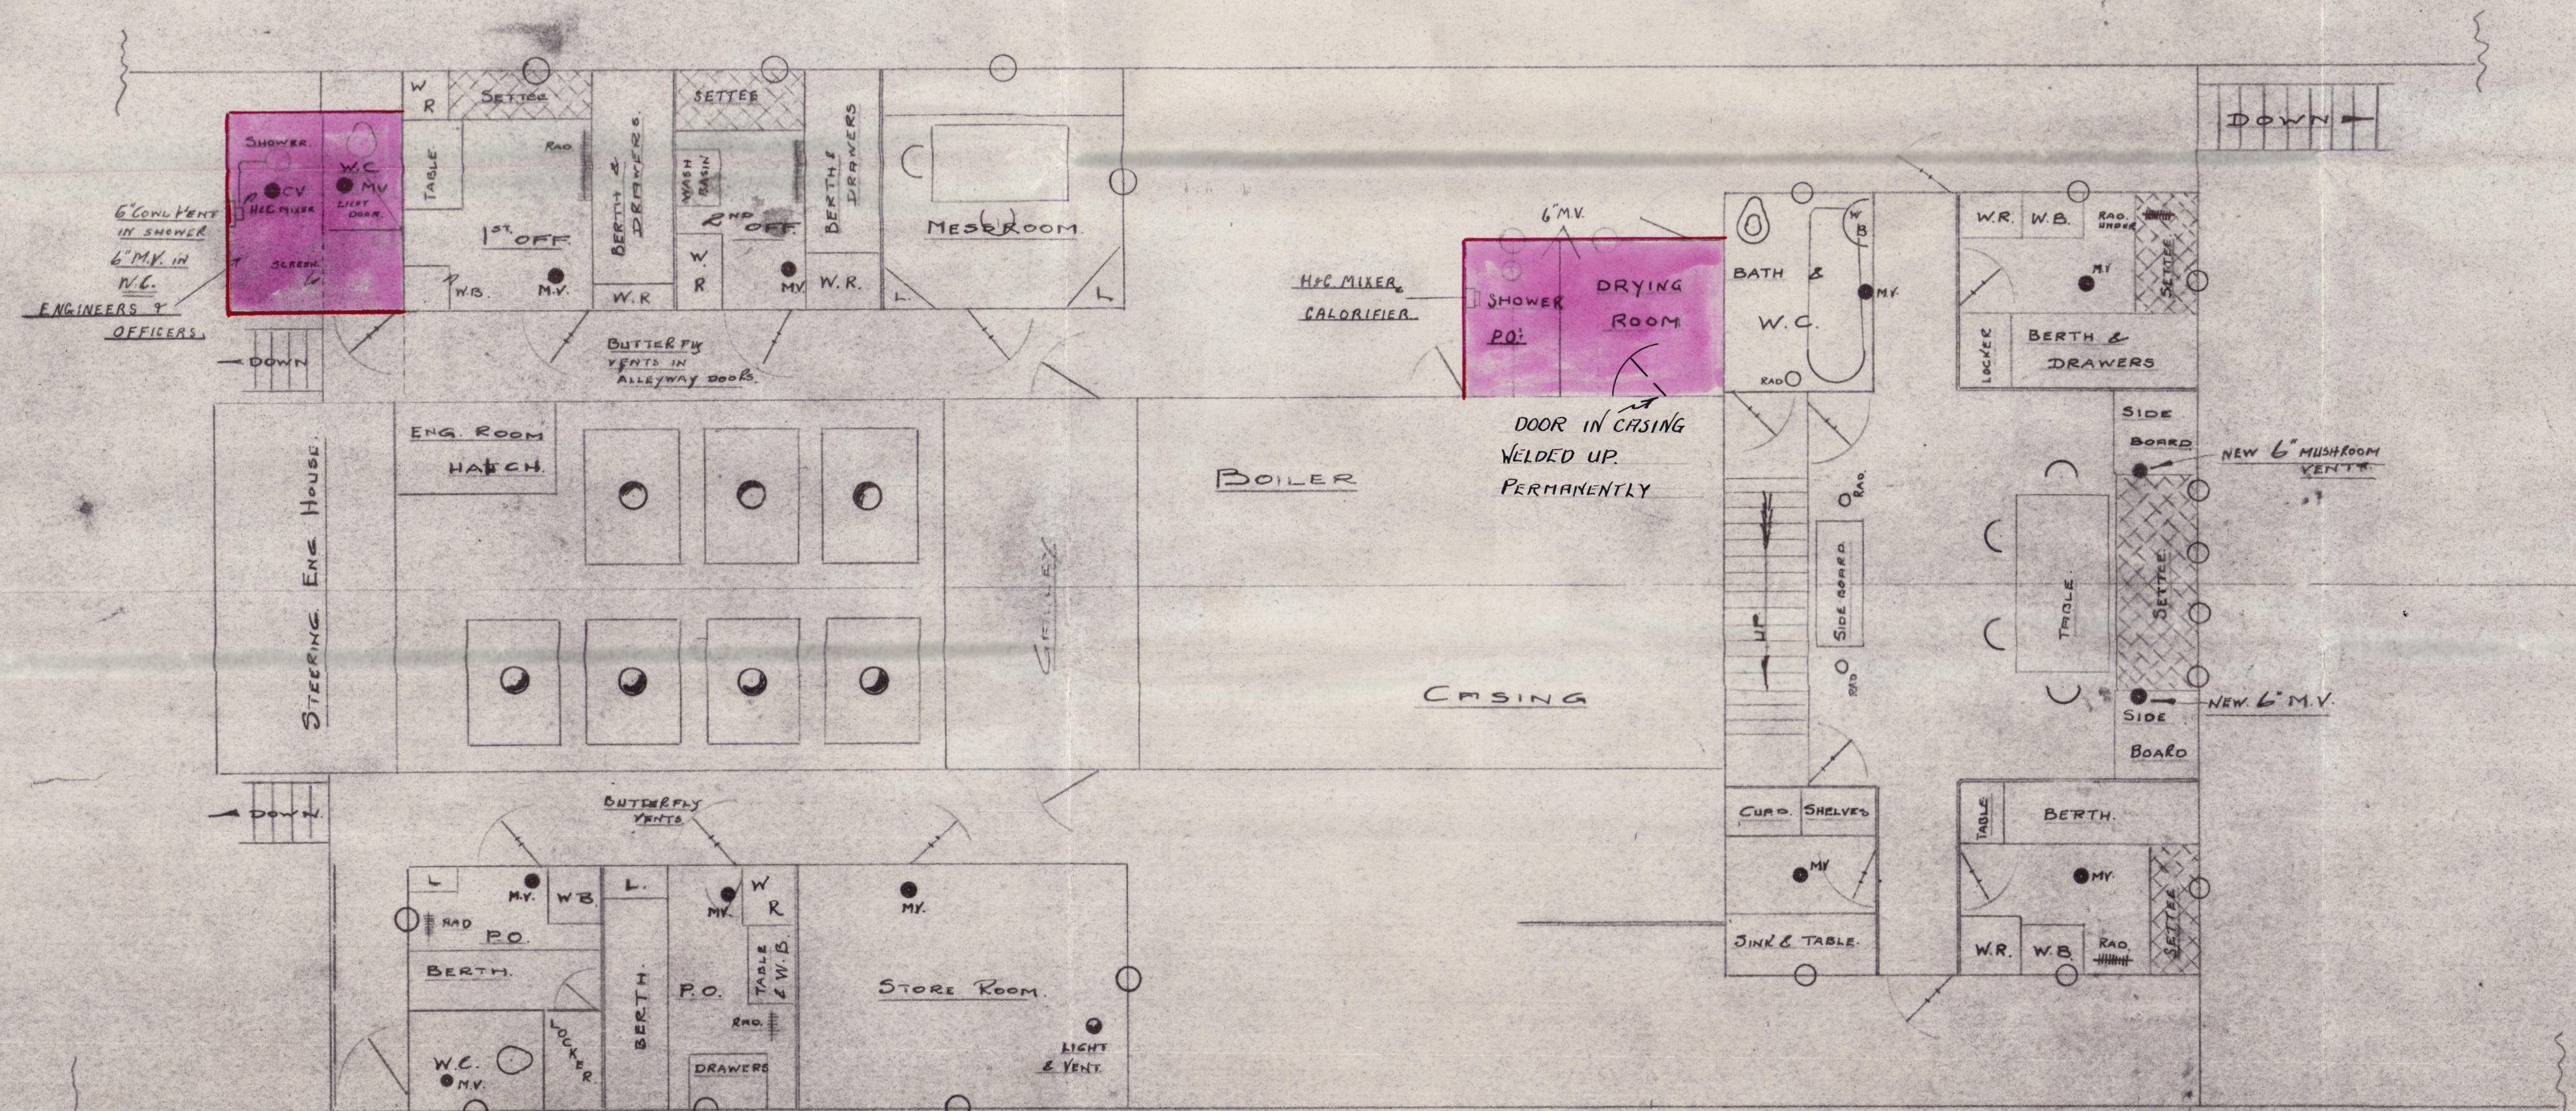



SS LUCKY
PROPOSED AMENDMENTS TO
CREWS ACCOMMODATION
SCALE 1/4" = 1"

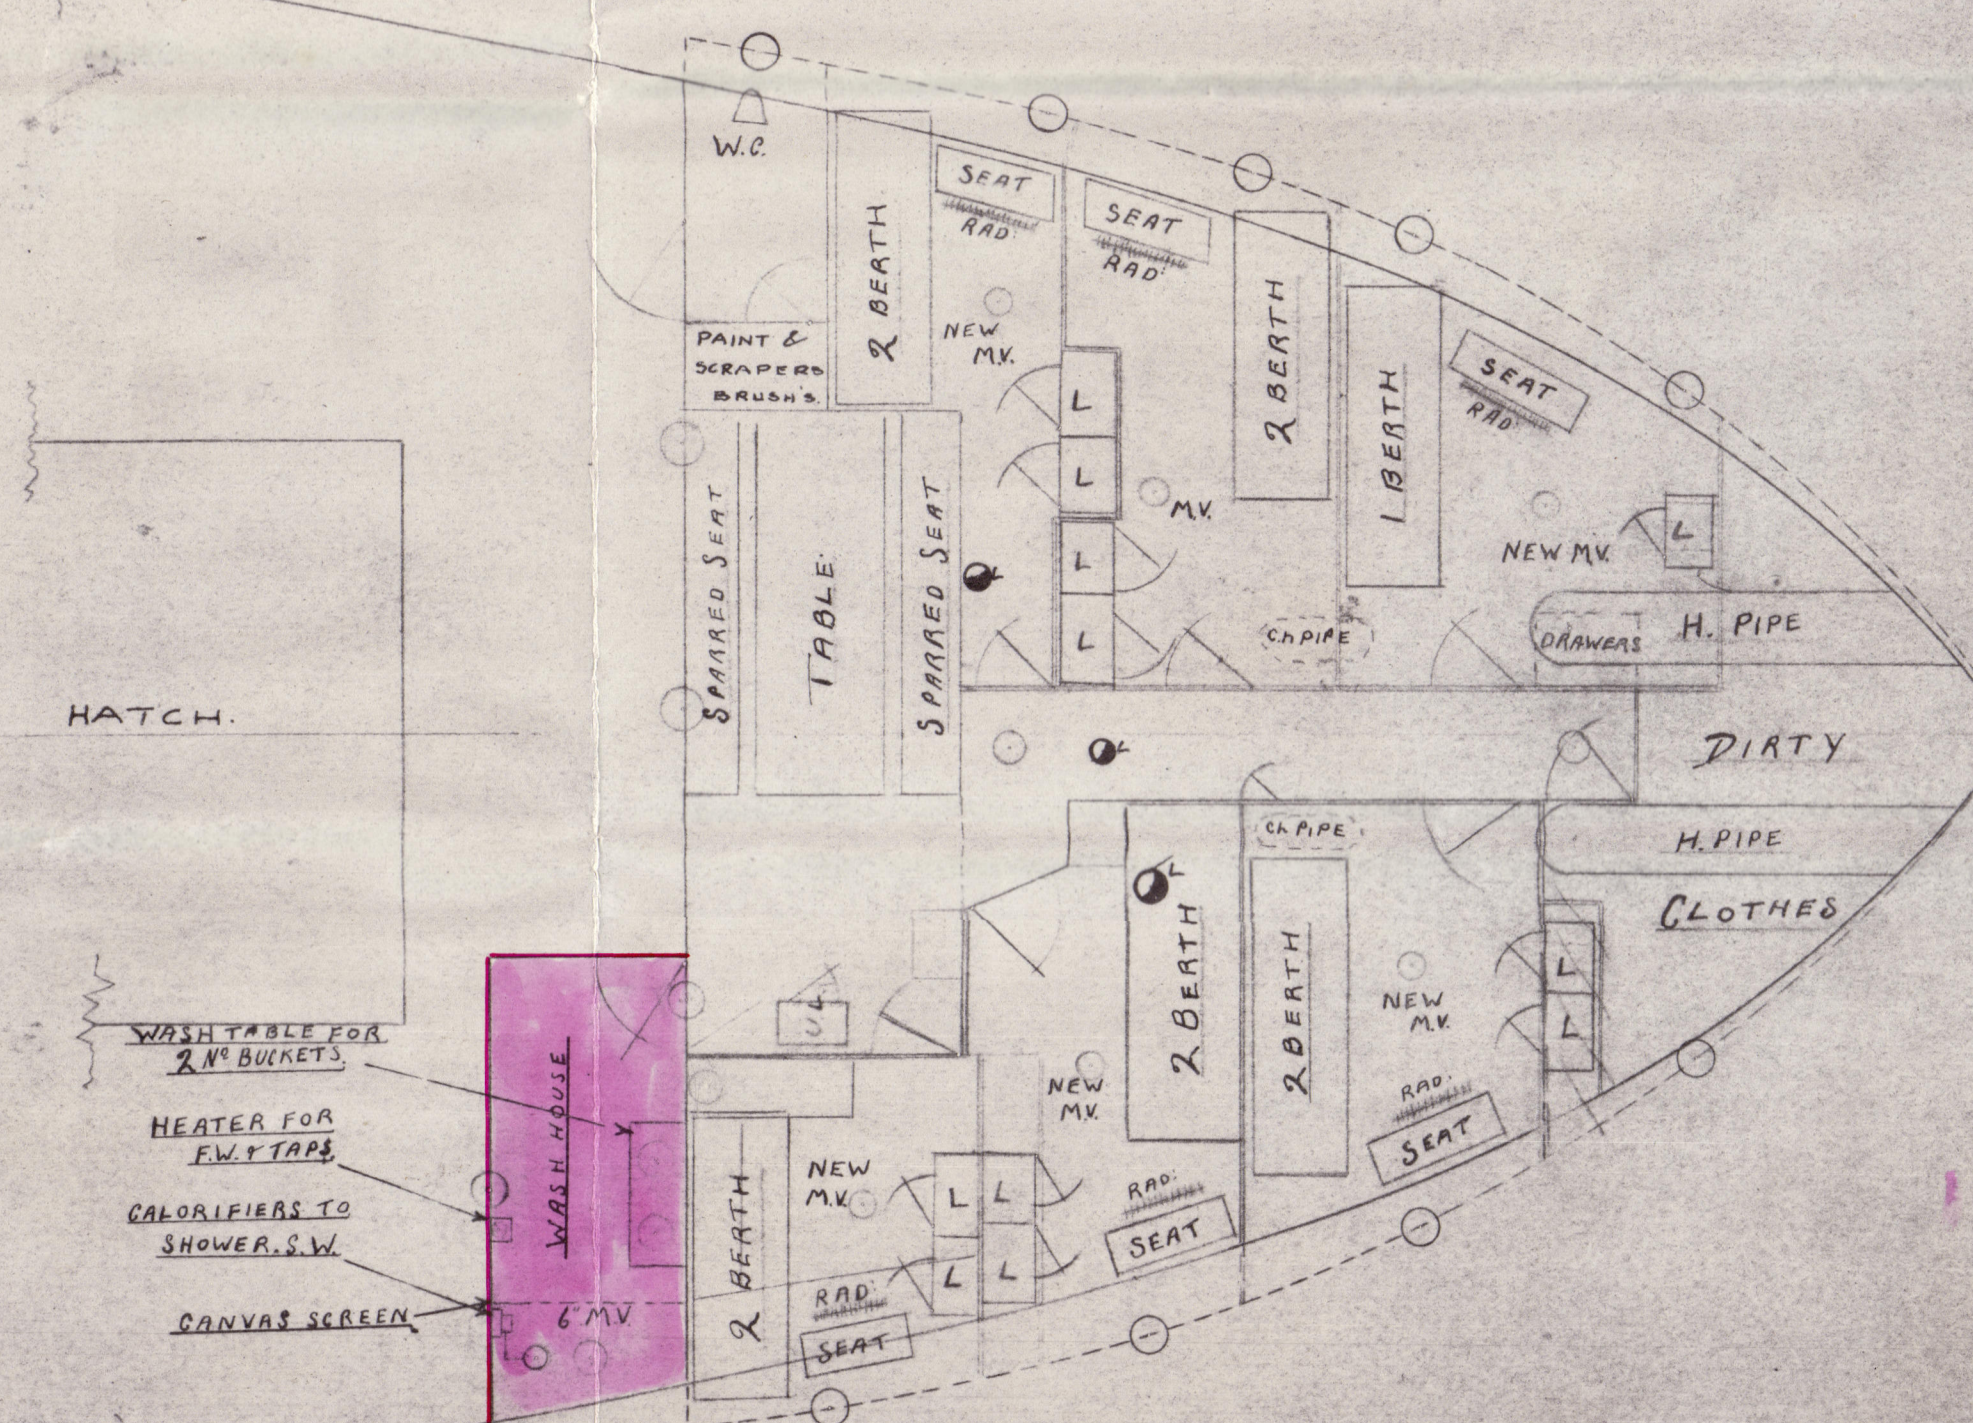

BRIDGE DECK ACCOMMODATION

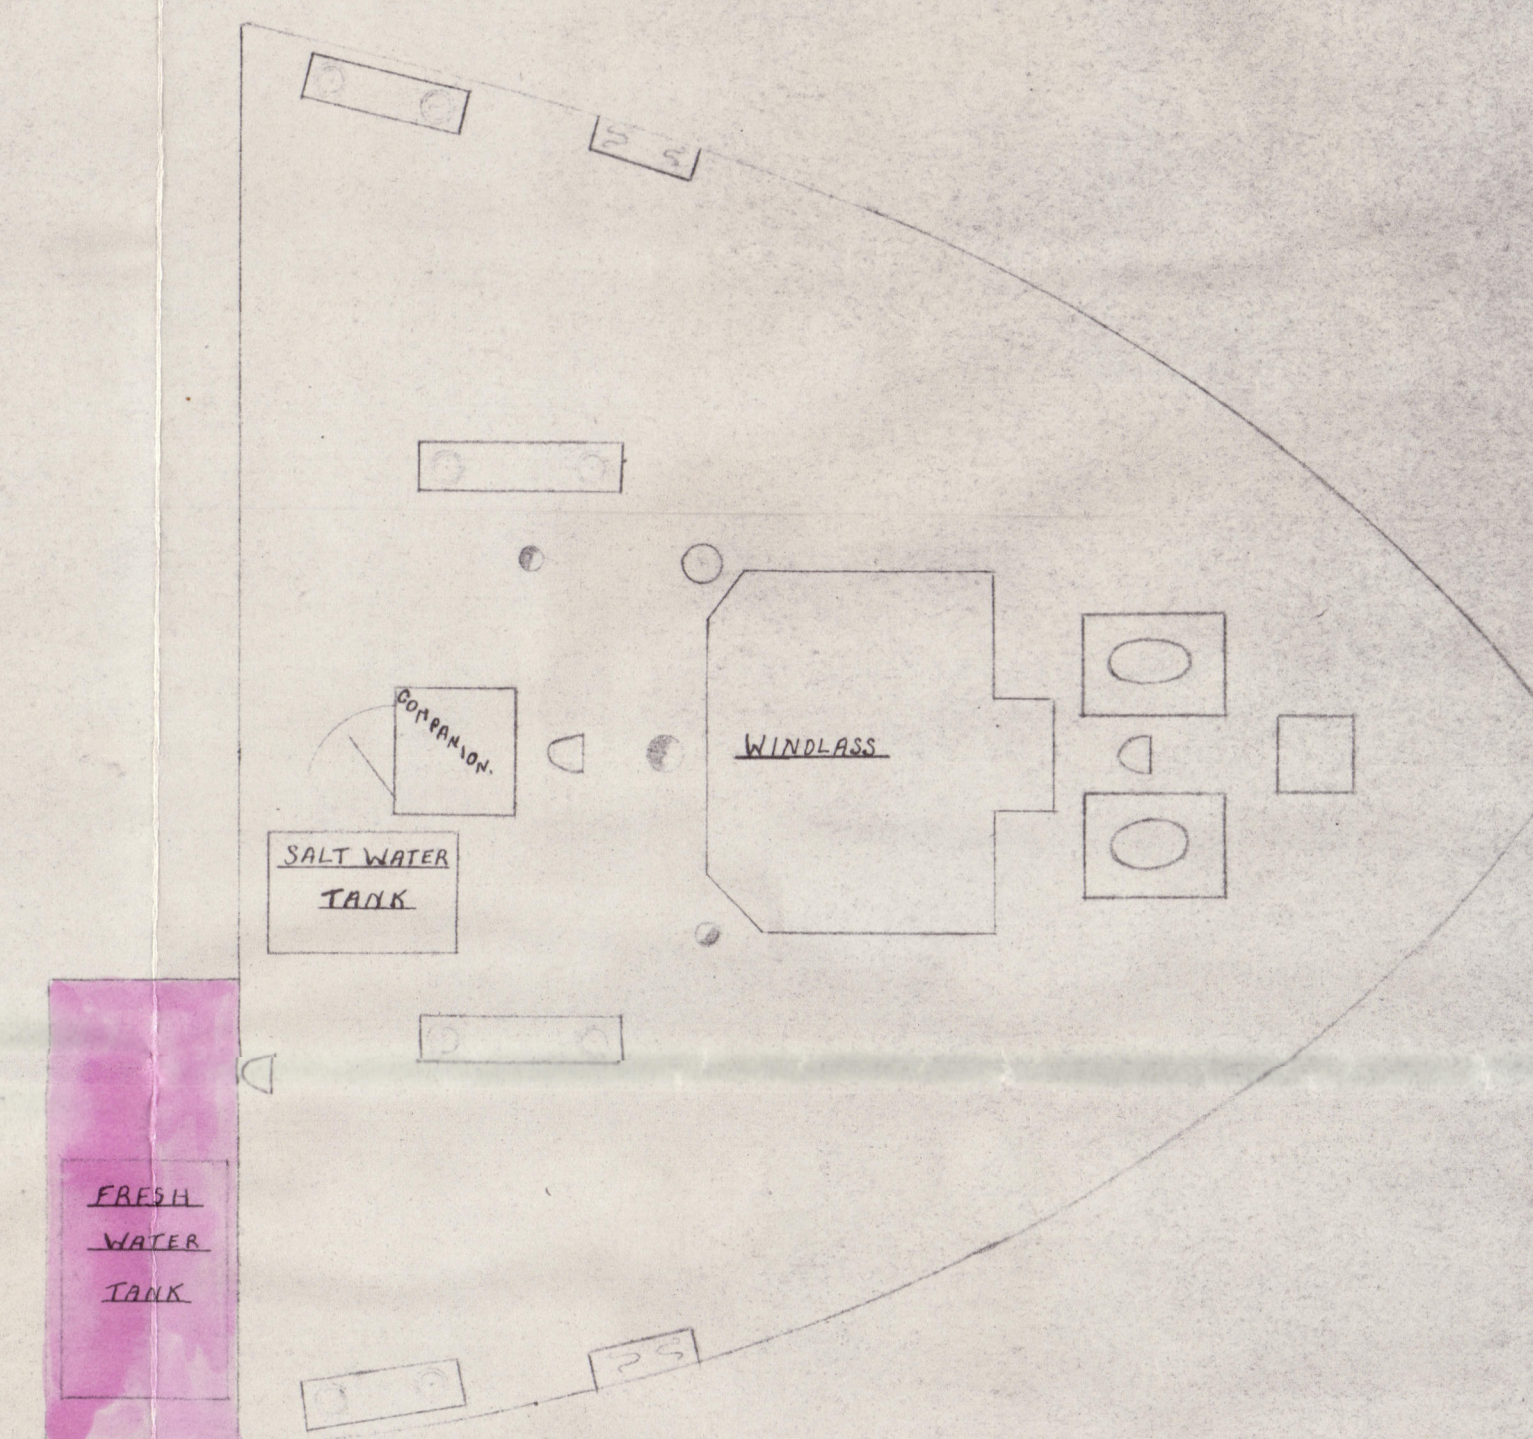

FORECASTLE ACCOMMODATION

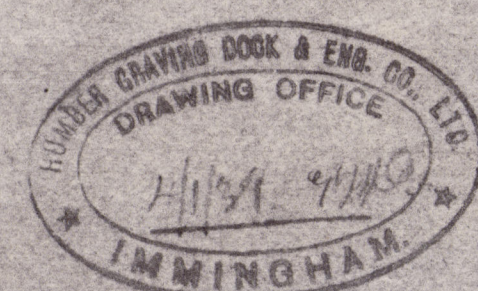

RETA

RETA



© 2020

Lloyd's Register
Foundation

W429-0172.