
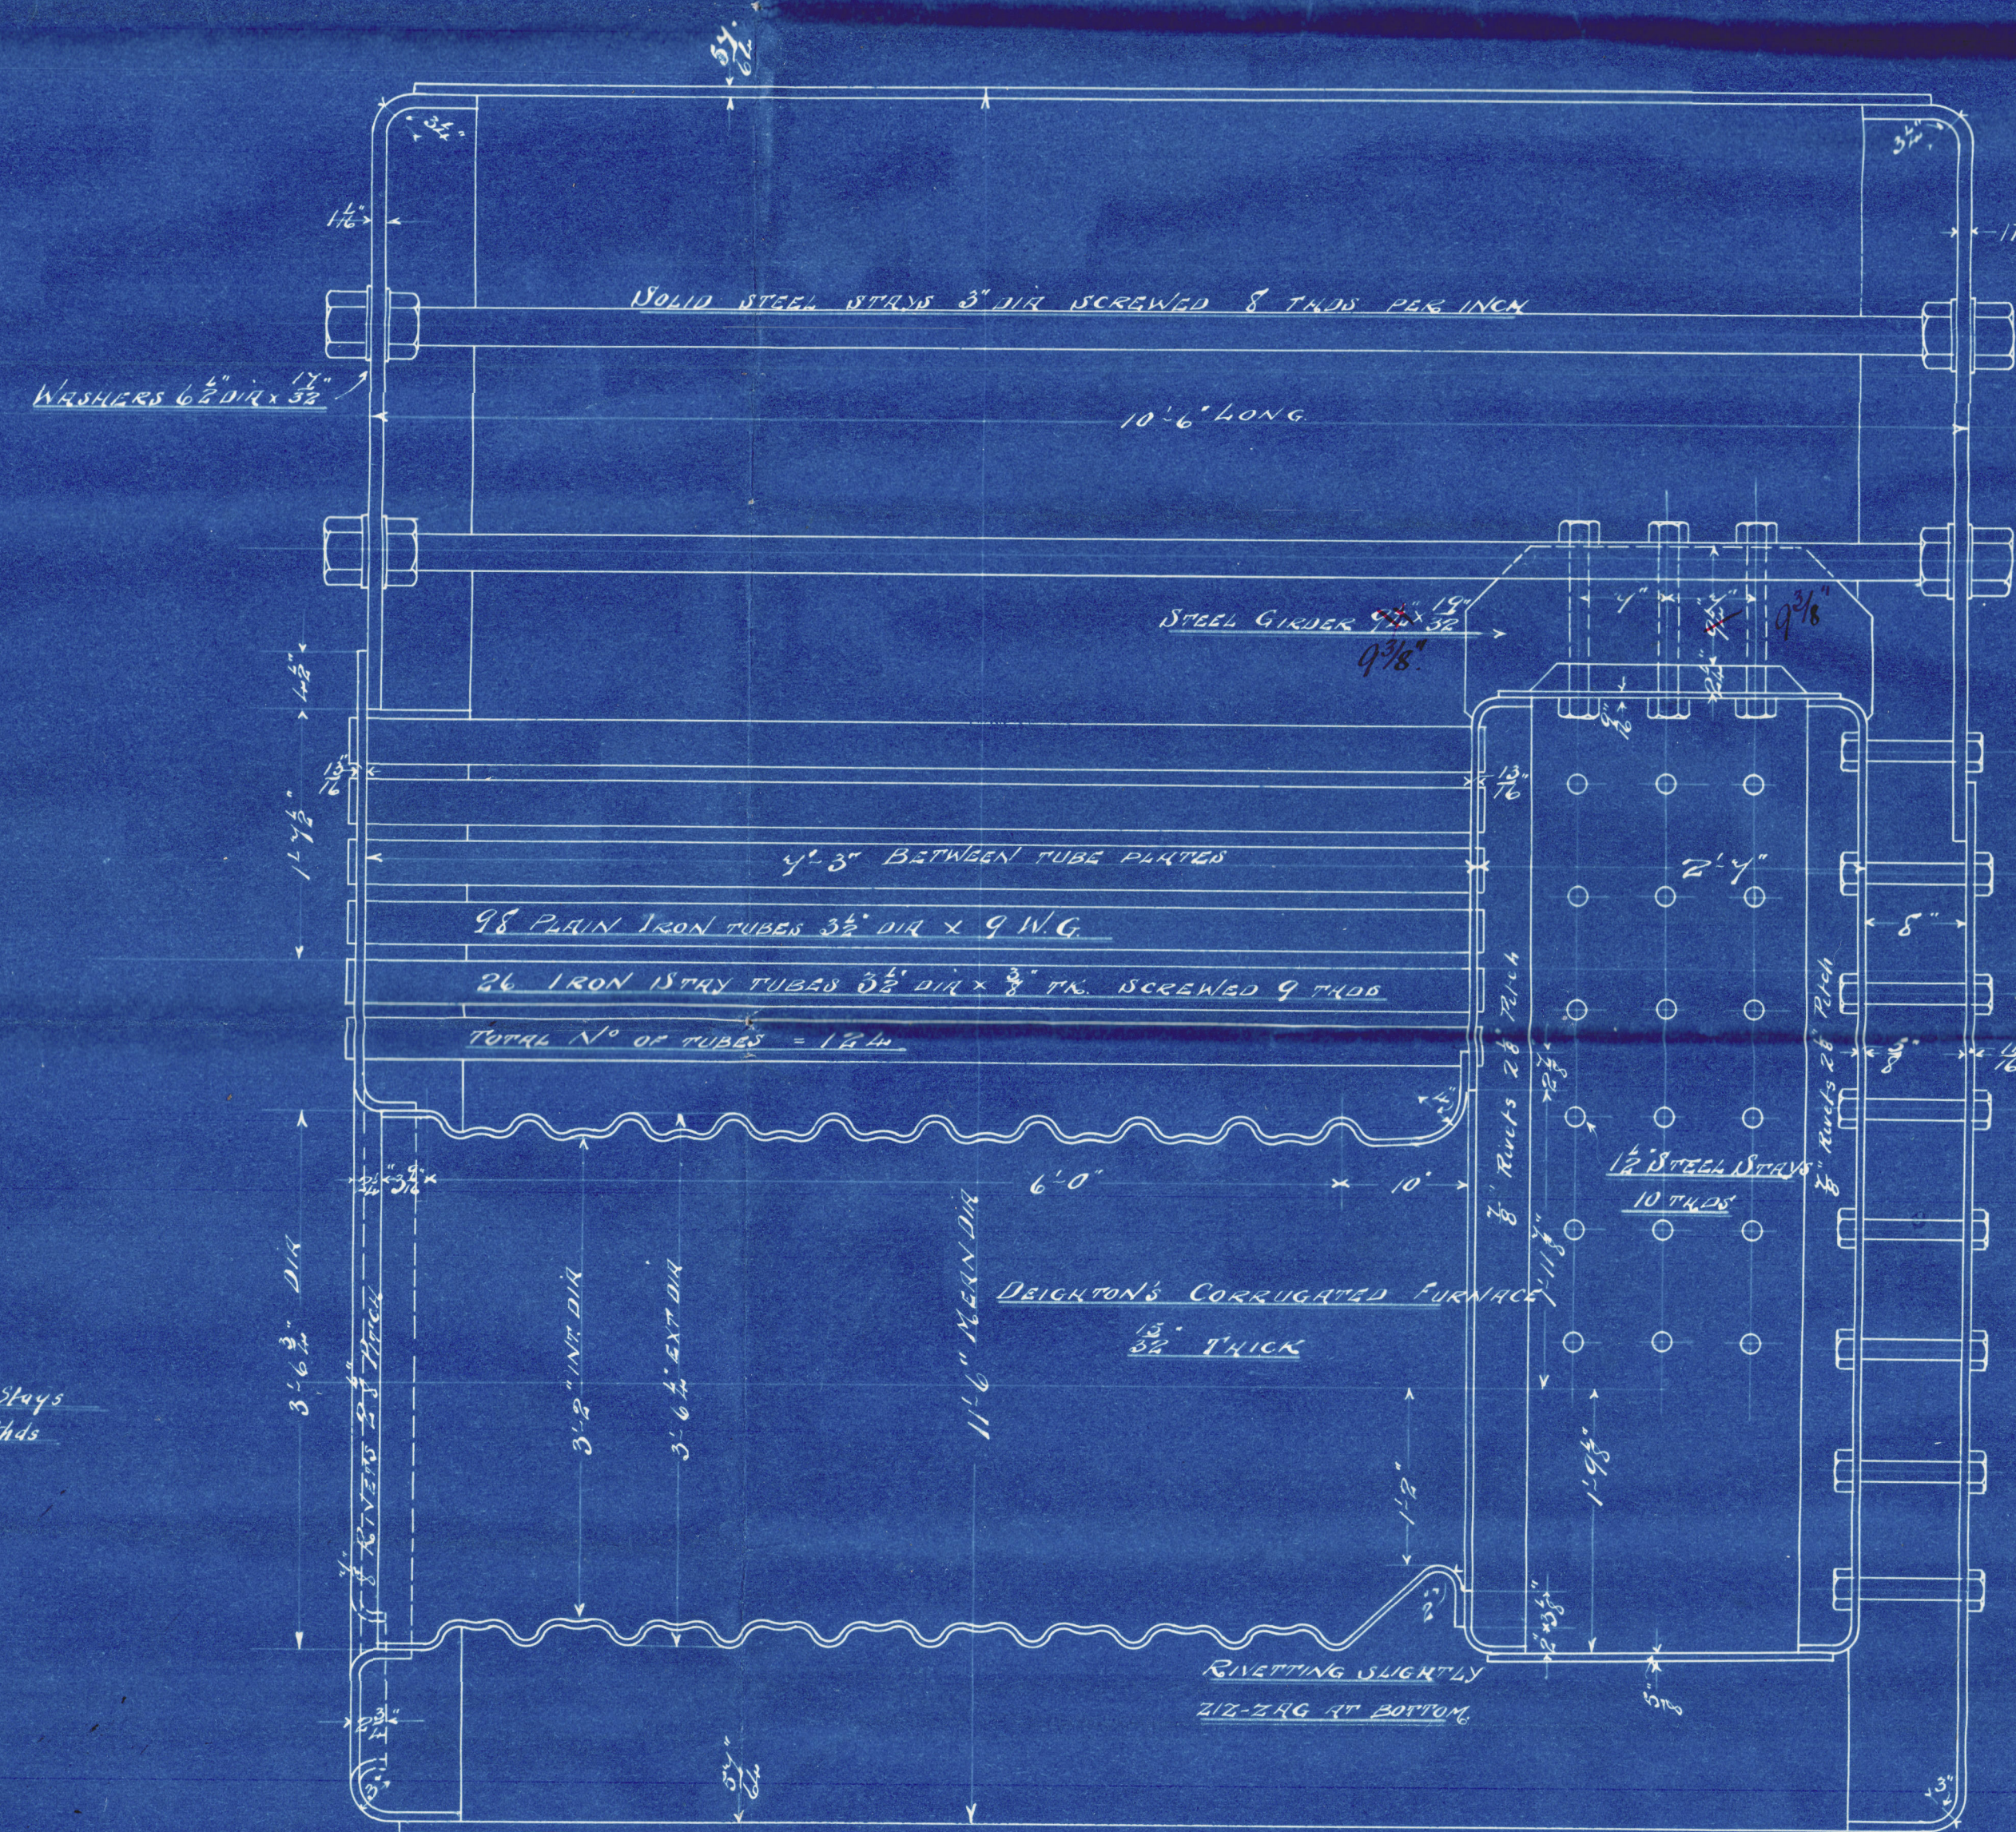


JOB NO. 89  
05

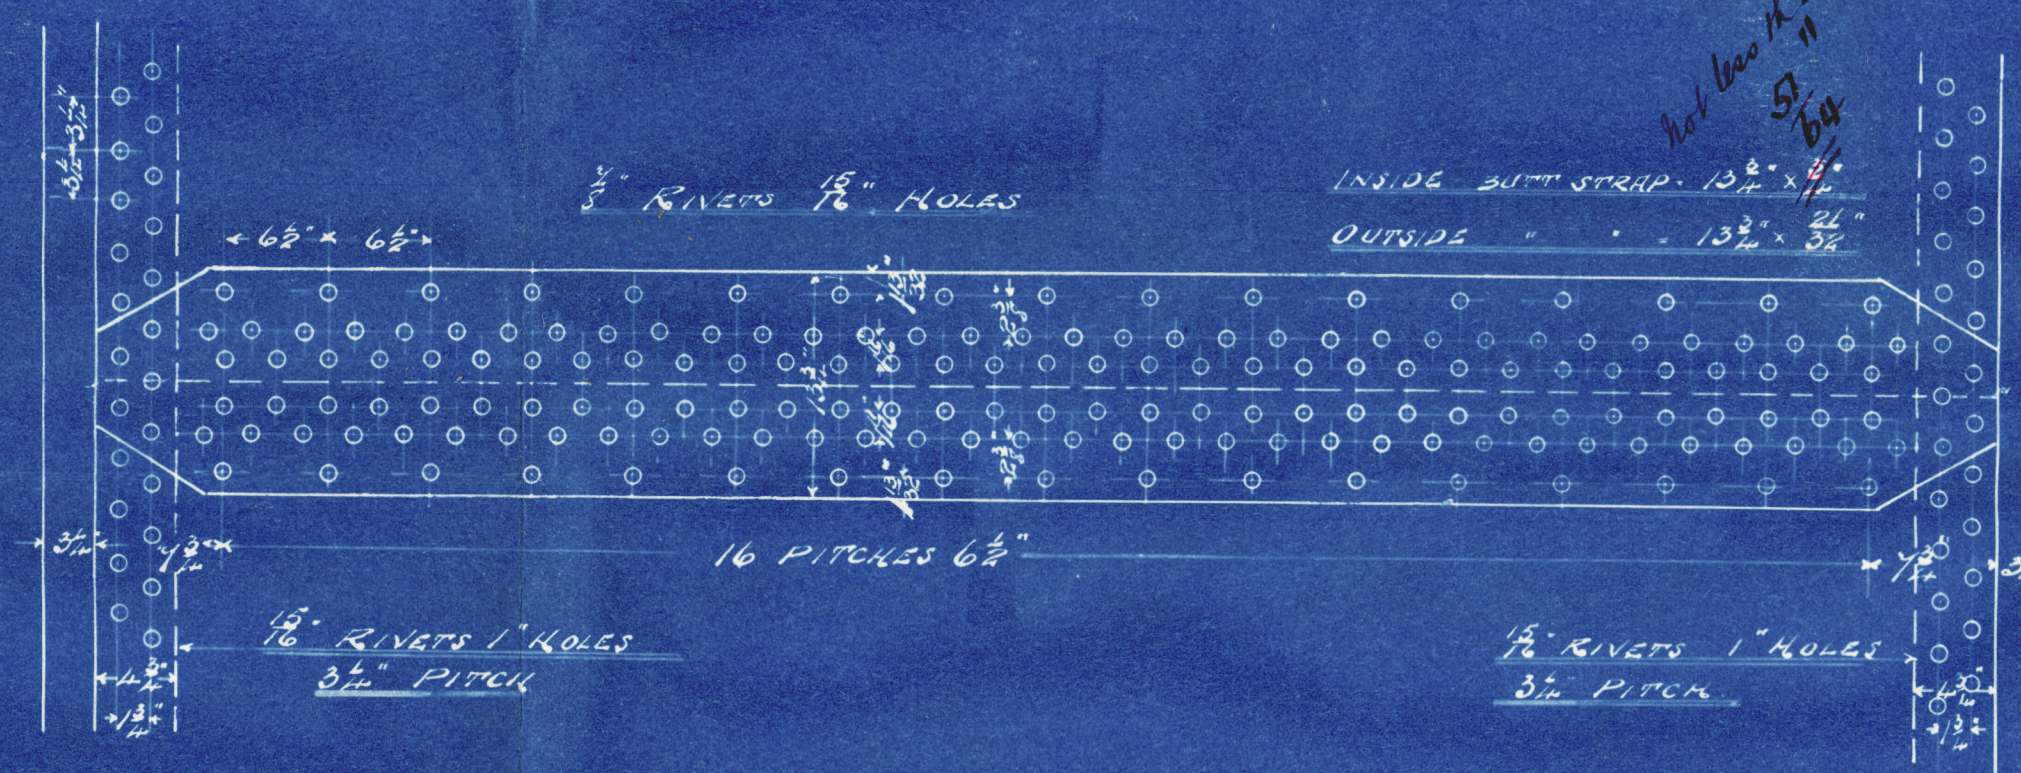

| Meating Surfaces |   |         |
|------------------|---|---------|
| 124 tubes        | = | 823.25  |
| furnaces         | = | 83.5    |
| plates           | = | 143.25  |
| Total            | = | 1050.00 |

MARINE BOILER 11'-6" HEIGH X 10'-6" LONG N<sup>o</sup>s 364-5

LLOYD'S SURVEY W.P. = 165 LBS

SCALE:- 1" = 1-FOOT

6<sup>TH</sup> FEB 1905

10353



Craig & Co's

Ber. 364/5


Gls. rft No 22824



St. Luke

Exk 14305.

RETAIN

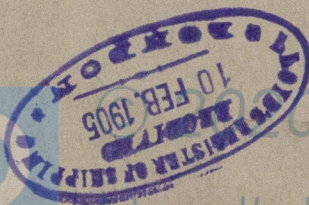

W429-0176



Lloyd's Register  
Foundation