

S.S. NOS 282/3 MIDSHIP SECTION.

SCALE: 1/2" = 1 FOOT.

DIMENSIONS: - 428' 0" B.P. x 58' 2 1/2" B.D. x 38' 3" M.D. TO . UPPER DECK.
CLASS # 100 A1. WITH FREEBOARD.
CORRESPONDING TO A DRAFT NOT EXCEEDING THAT CONTEMPLATED BY THE RULES,
FOR A COMPLETE SUPERSTRUCTURE SHIP HAVING A TONNAGE OPENING.

INCREASED THICKNESSES ABOVE LLOYD'S SCANTLINGS ARE REQUIRED
BY OWNERS AS STATED BELOW. These increases are not included in
THE FOLLOWING TO BE OF CHROMED STEEL:-

ALL MATERIAL IN ENGINE & BOILER ROOM TANKS, & PLUS 5% OVER MILD STEEL.
G.R. GRADIE PLATES & PLATES IN E. & B. FORECASTLE DECK PLATING, & PLUS 5% OVER MILD STEEL.


TANK TOP IN ENGINE & BOILER SPACE & PLUS 5% OVER MILD STEEL.
SECOND DECK PLATING, & PLUS 5% OVER MILD STEEL.

UPPER DECK PLATING WHERE EXPOSED & PLUS 5% OVER MILD STEEL.
SHELL PLATING FORWARD IN WAY OF PAINTING AREA IS IN WAY OF FORE PEAK STRINGERS.
THE WHOLE OF THE DEEDED TANK INCLUDING DECK, BEAMS, FRAMES, SHELL, BULKHEADS,
TANK TOP & ALL STRINGERS & ANGLE CONNECTIONS.

DOUBLE BOTTOM TO BE ABOUT 3/4" IN EXCESS OF LLOYD'S REQUIREMENTS
OR LINE B.D. IN HULLS 3/8" THICK & 3/8" THICK IN TWEEN DECKS.
BEAMS TO UPPER & 2ND DECK TO BE ONE ROW SIZE CLEAR OF HATCH & Casing, WITH
GIRDERS IN LINE WITH HATCH SIDE-COMMINGS.

LENGTH ON LOAD LINE.	
BREATH MONDOED.	428'-0"
DEPTH TO UPPER DECK.	58'-2 1/2"
" " SECOND DECK	38'-3"
RULE DEPTH (28'-9" + 8'-0")	36'-9"
1ST NUMBER 6 x II	15728.00
2ND 6 x (B+I)	40638.00
I + BY DEPTH TO SHELTER DECK =	11.19
d AT V.L. FORWARD FRAMES	14.28
d AT E. & B. SPACE	24.4
d AT COLLISION BULKHEAD, PAINTING FRAMES.	24.0
d (OTHER THAN FRAMES.)	14.28 24.8

EQUIPMENT NUMBER	
210 NUMBER	41280-62
FORECASTLE	160-31
CASING & SIDEHOUSES	289-20
SAFETY DECKHOUSE	121-00
BRIDGE	92-00
AFT	133-00
8 LOWER ANCHORS 72 LBS EACH STOCKLESS	42076-11
1 " 62 OZ'S STOCKLESS	
1 STREAM ANCHOR 2016 OZ'S EX STOCK	
300 FATHOMS 21/8" STAINLESS CHAIN CABLE (TAYCO PRODUCT) RULE 2 1/4"	
120 " 5" STEEL WIRE STREAM 9/2A	
130 " 5" " " TOWLINE 6/2A	
2-100 " 2 1/4" " " HANLERS 6/2A	
2-100 " 2 1/4" " " WARPS. 9/2A	

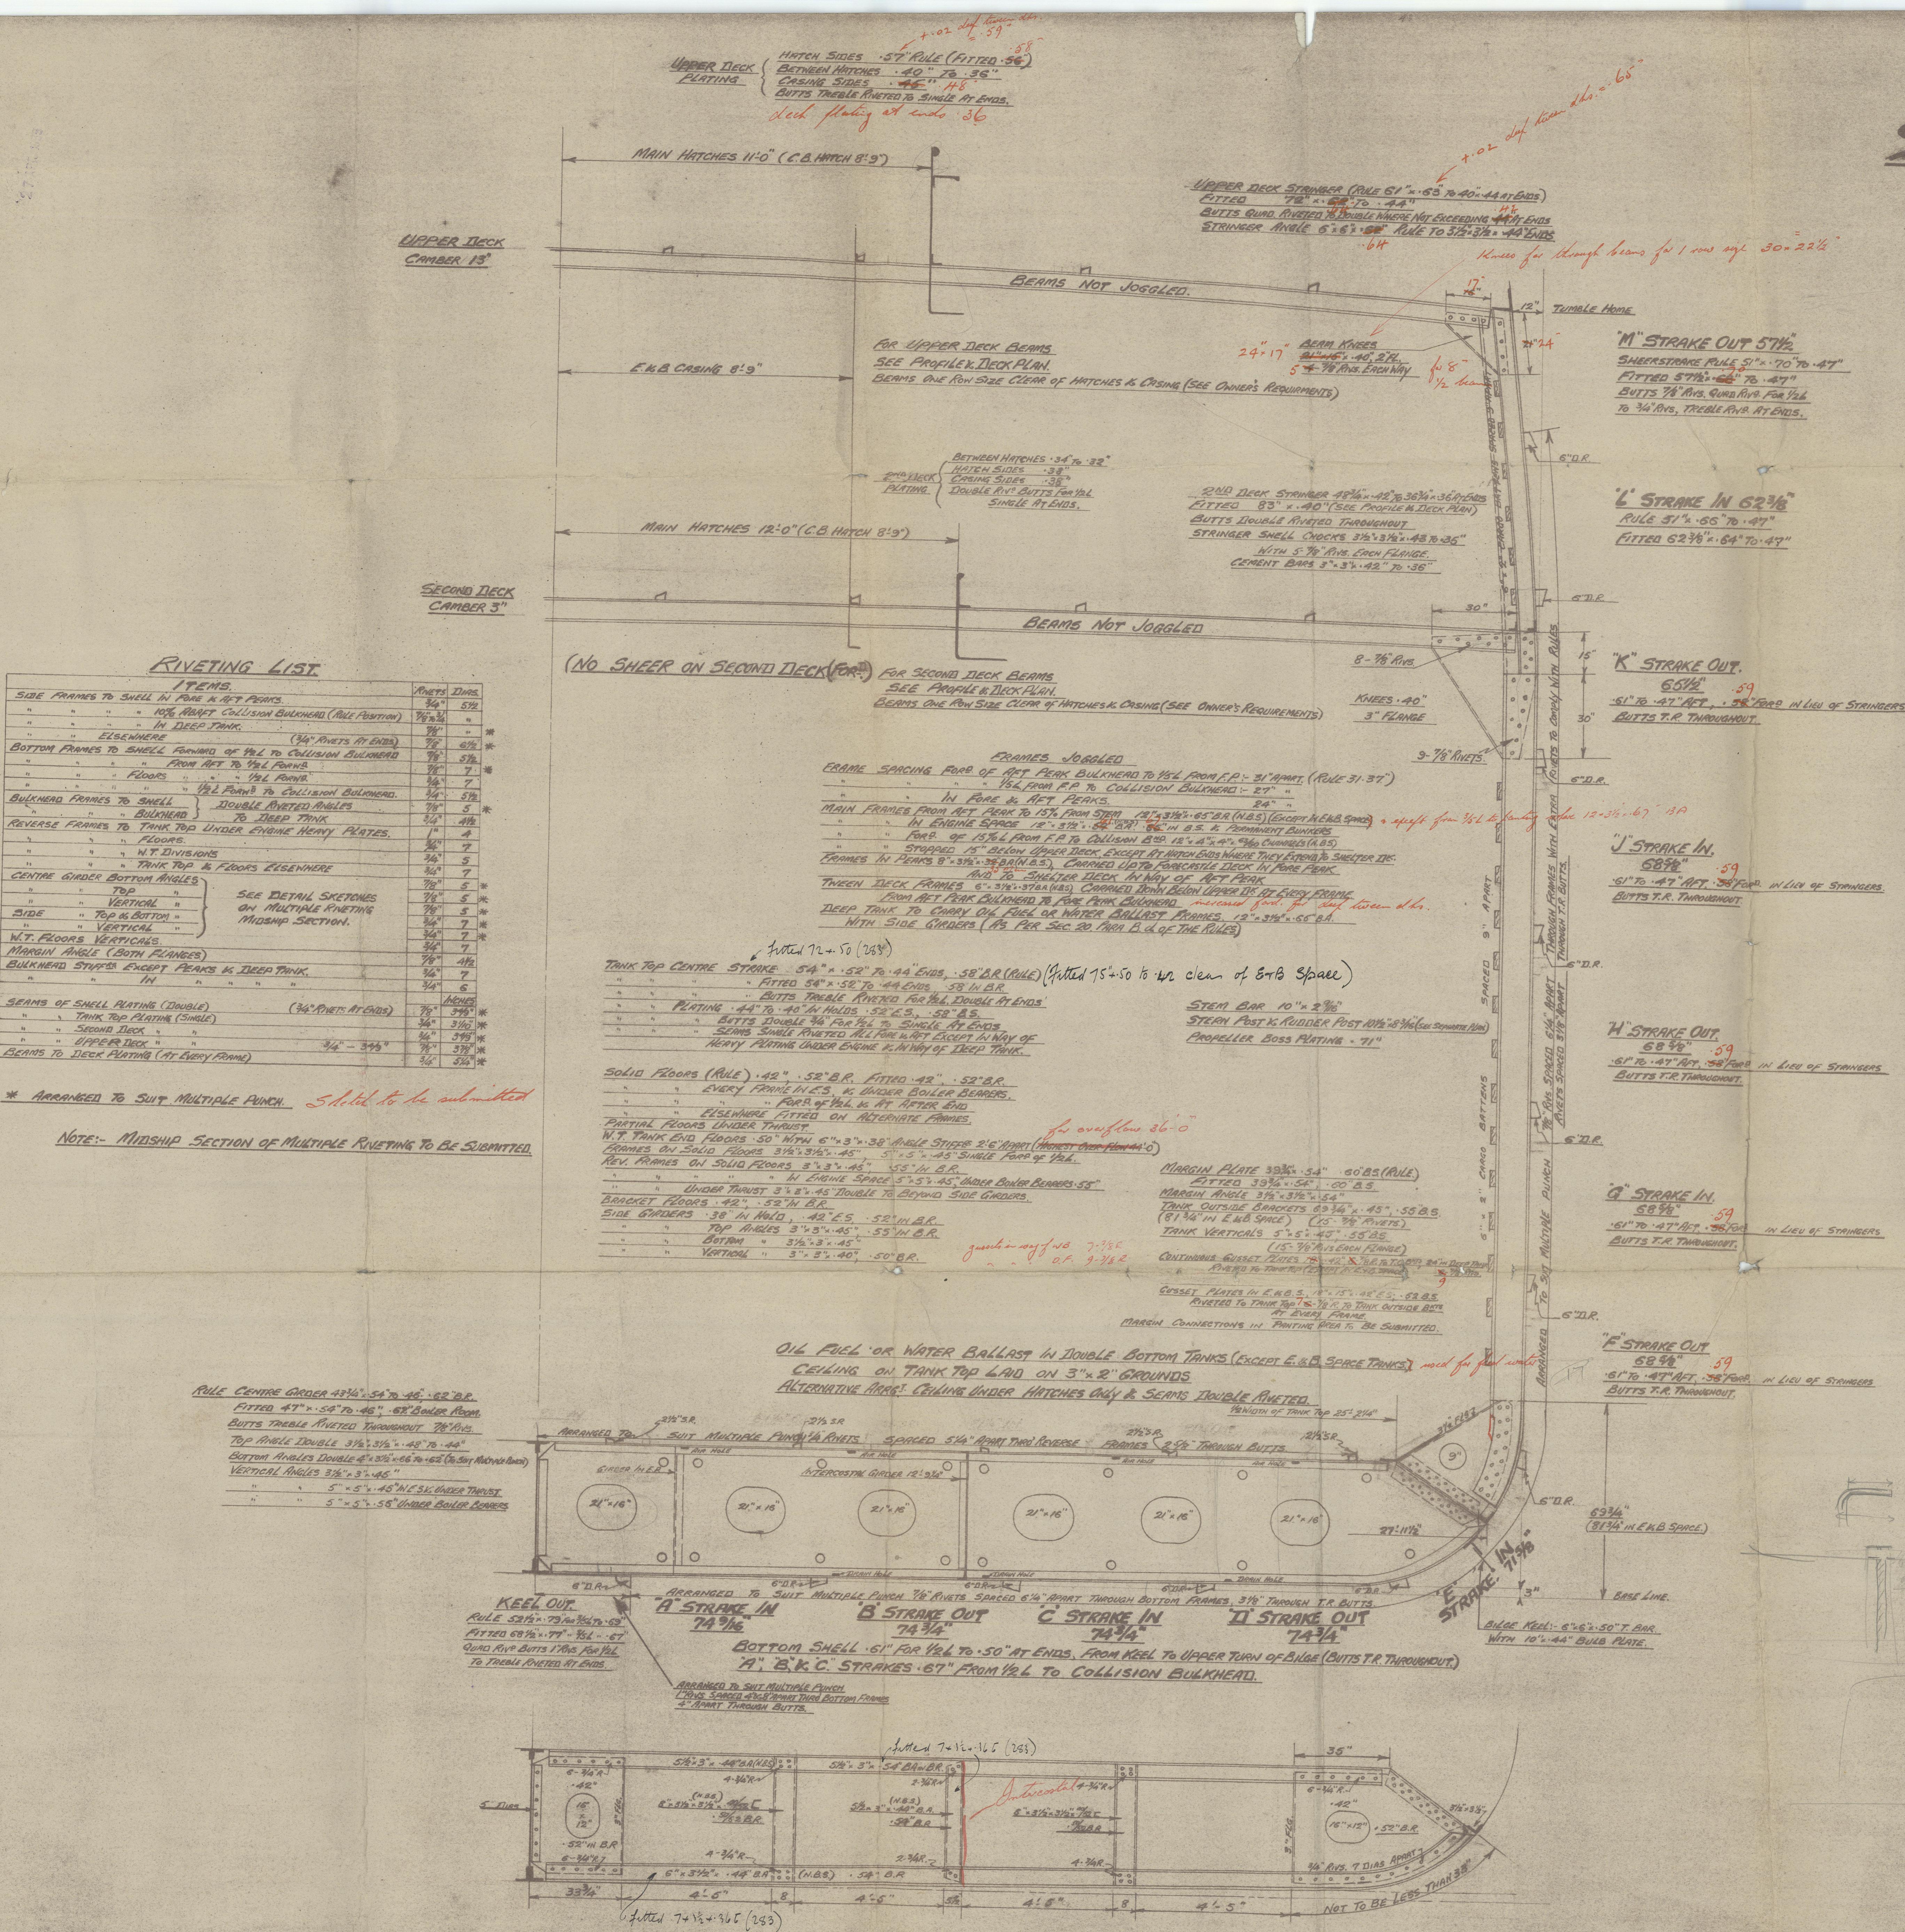

Barkham 282-3


Mudsho Section



"Harpagus"

Sed. 32855.

Harpagites
SUNDERLAND RPT. No. 32905.

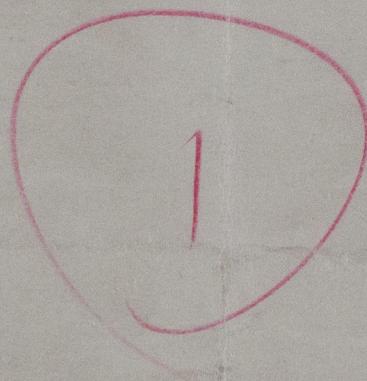

A 788 BOX NO 382 GEM

W43-0931



© 2020

Lloyd's Register
Foundation