

# "MANGALORE"

ALTERATIONS TO DECKS AND TANK TOP INVOLVED IN SHORTENING VESSEL BY 37'-6"






SCALE 1/4" = 1'-0"

BRIDGE DECK

UPPER DECK

MAIN DECK

TANK TOP

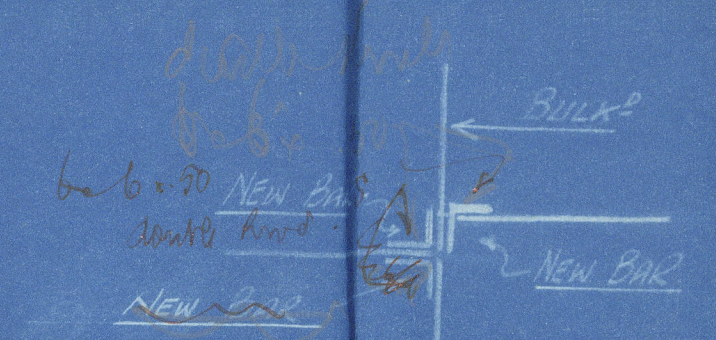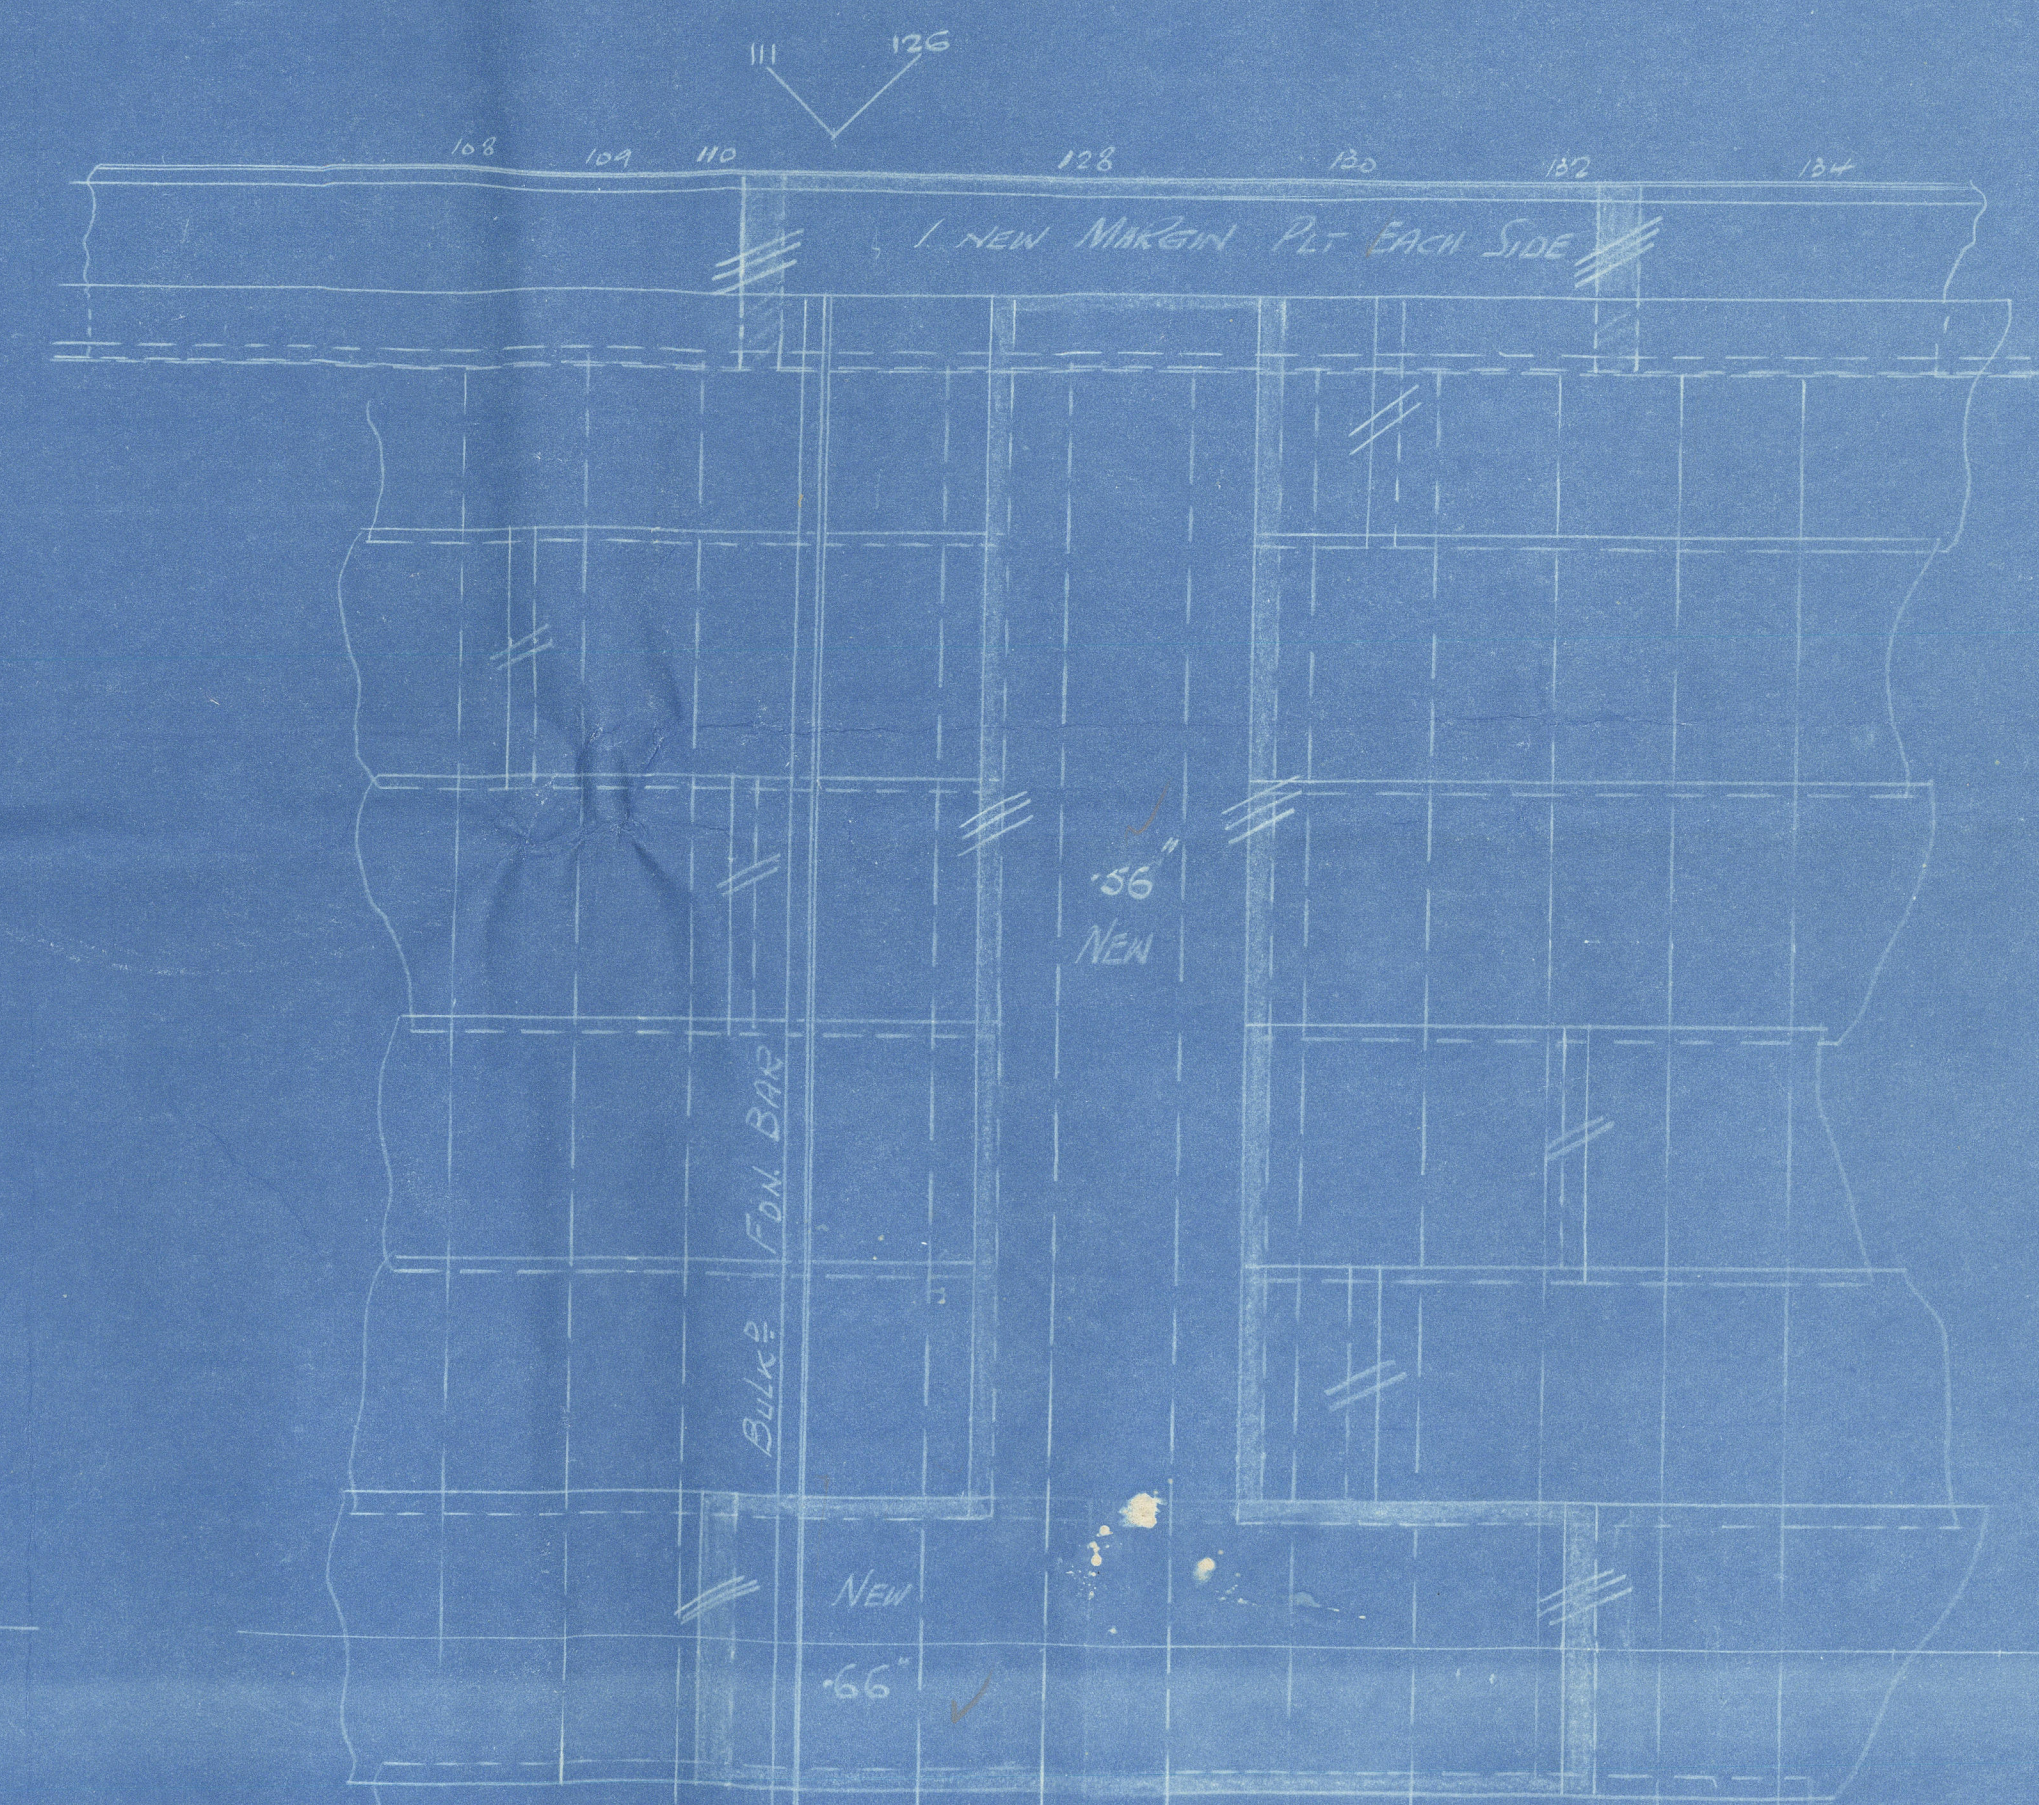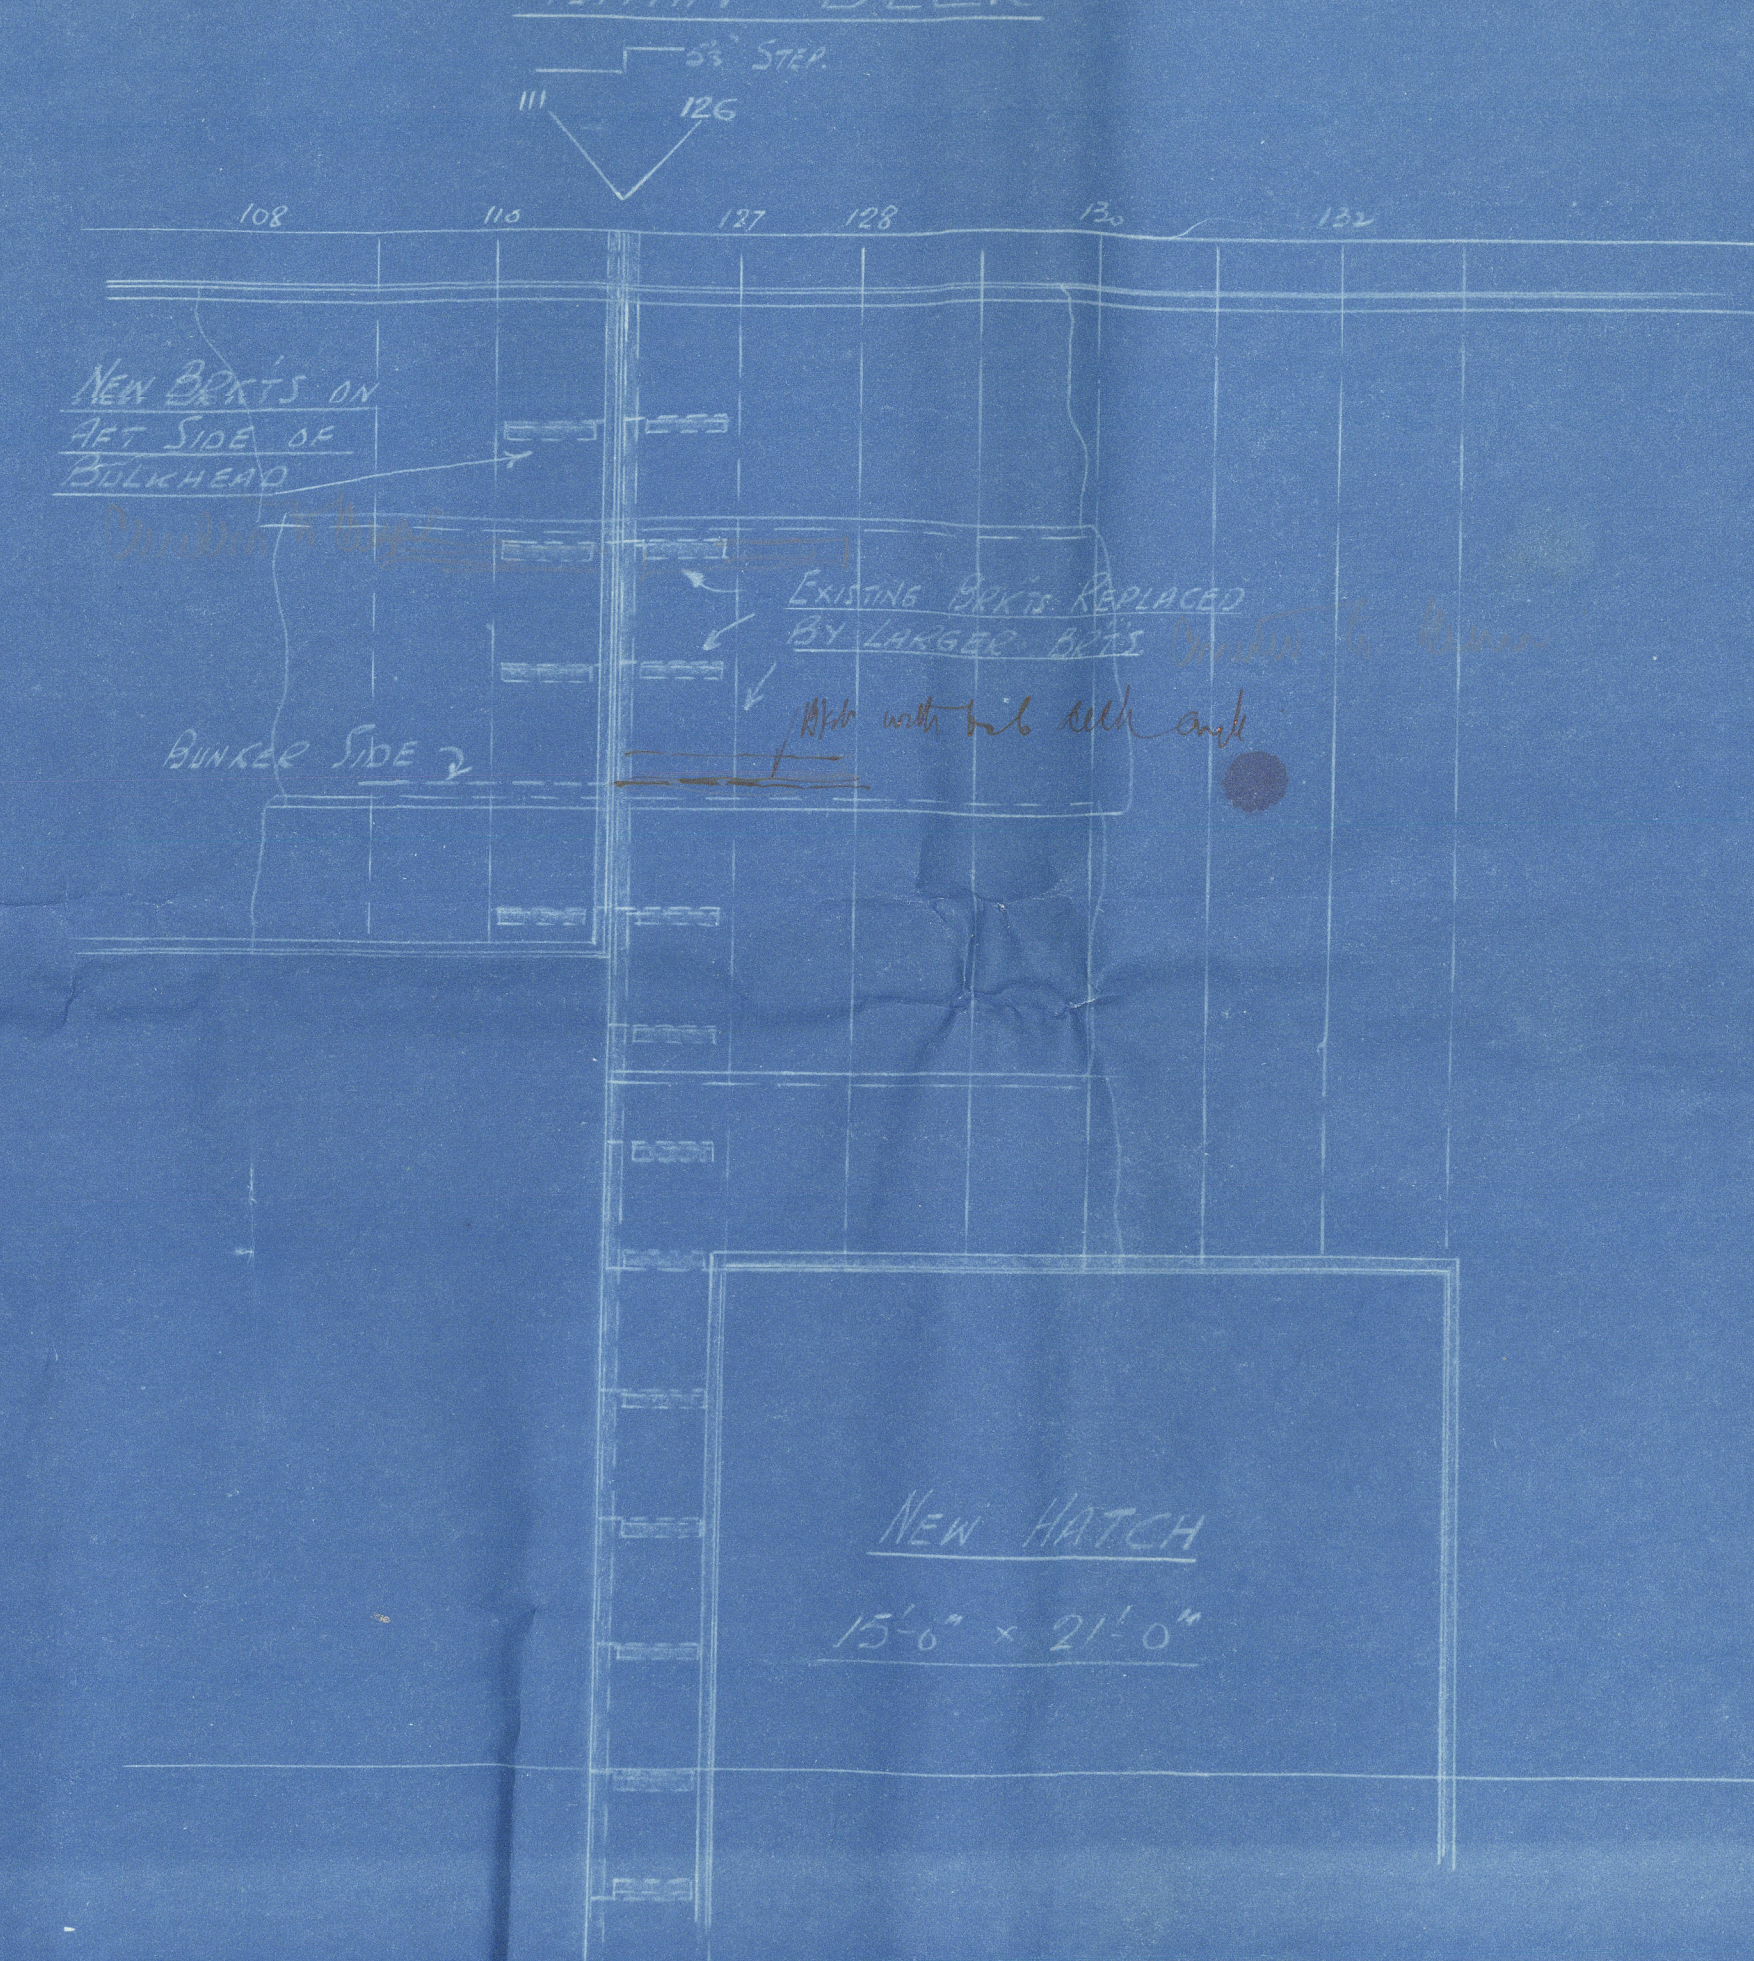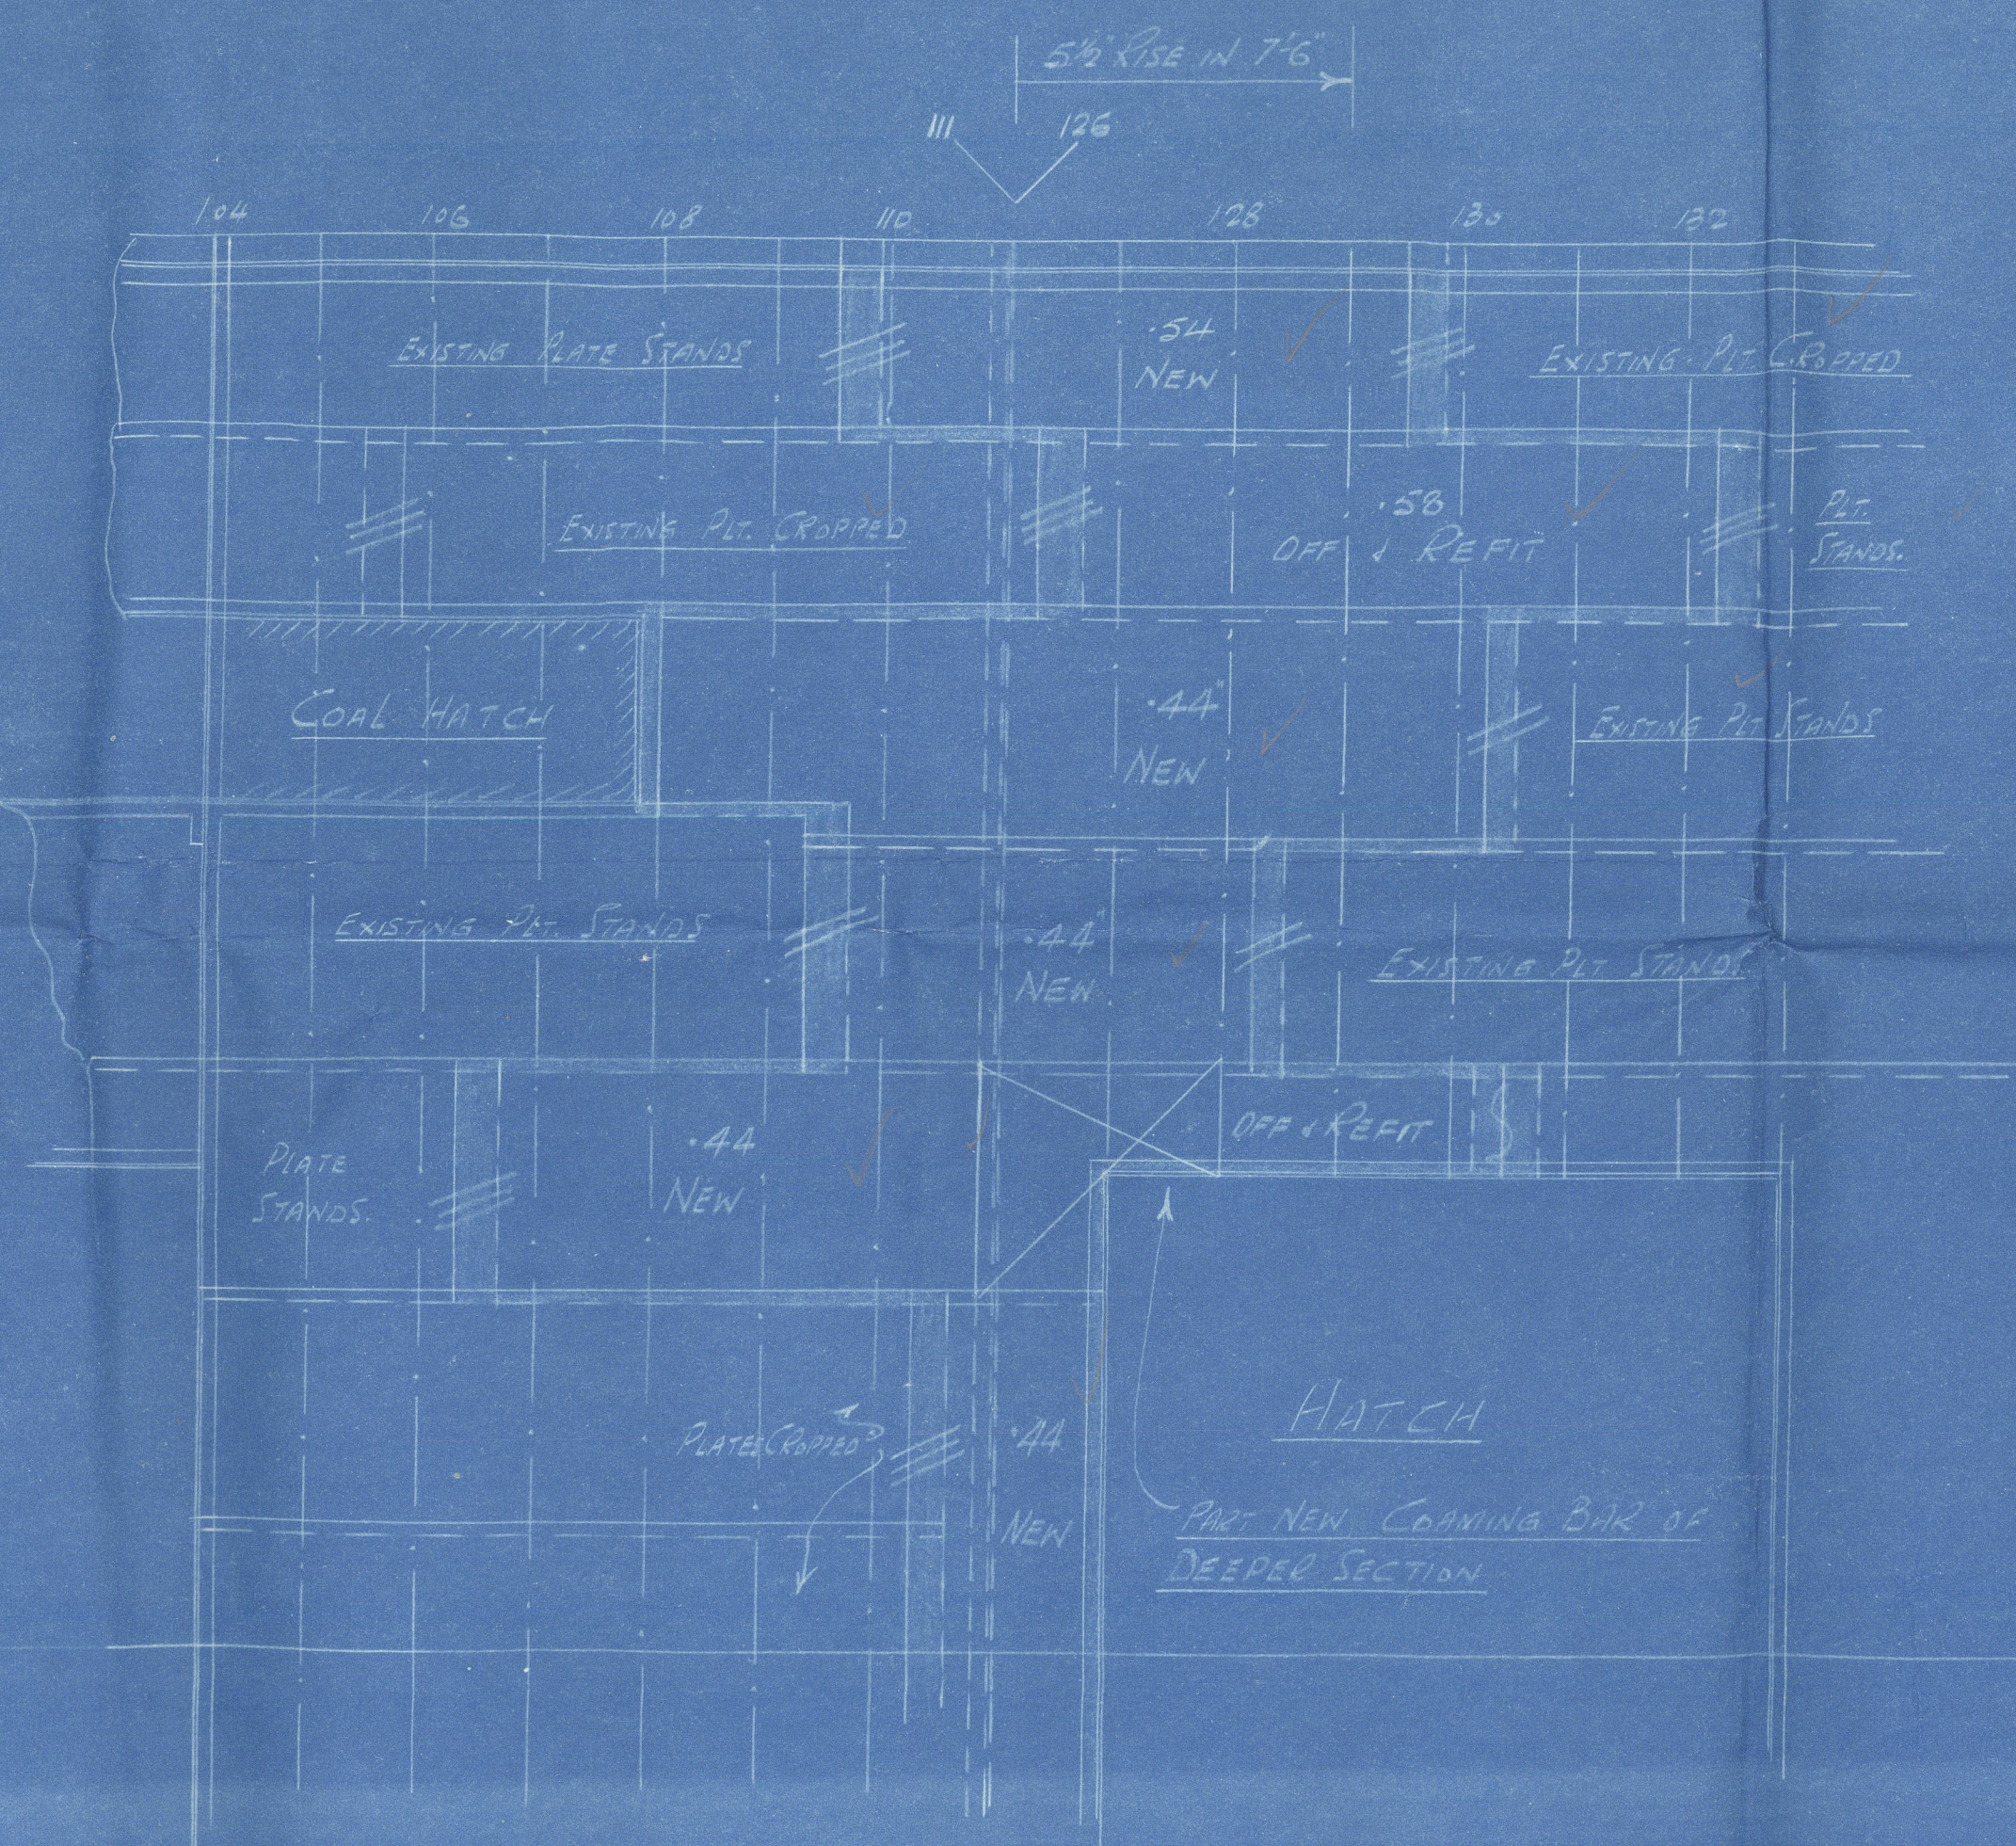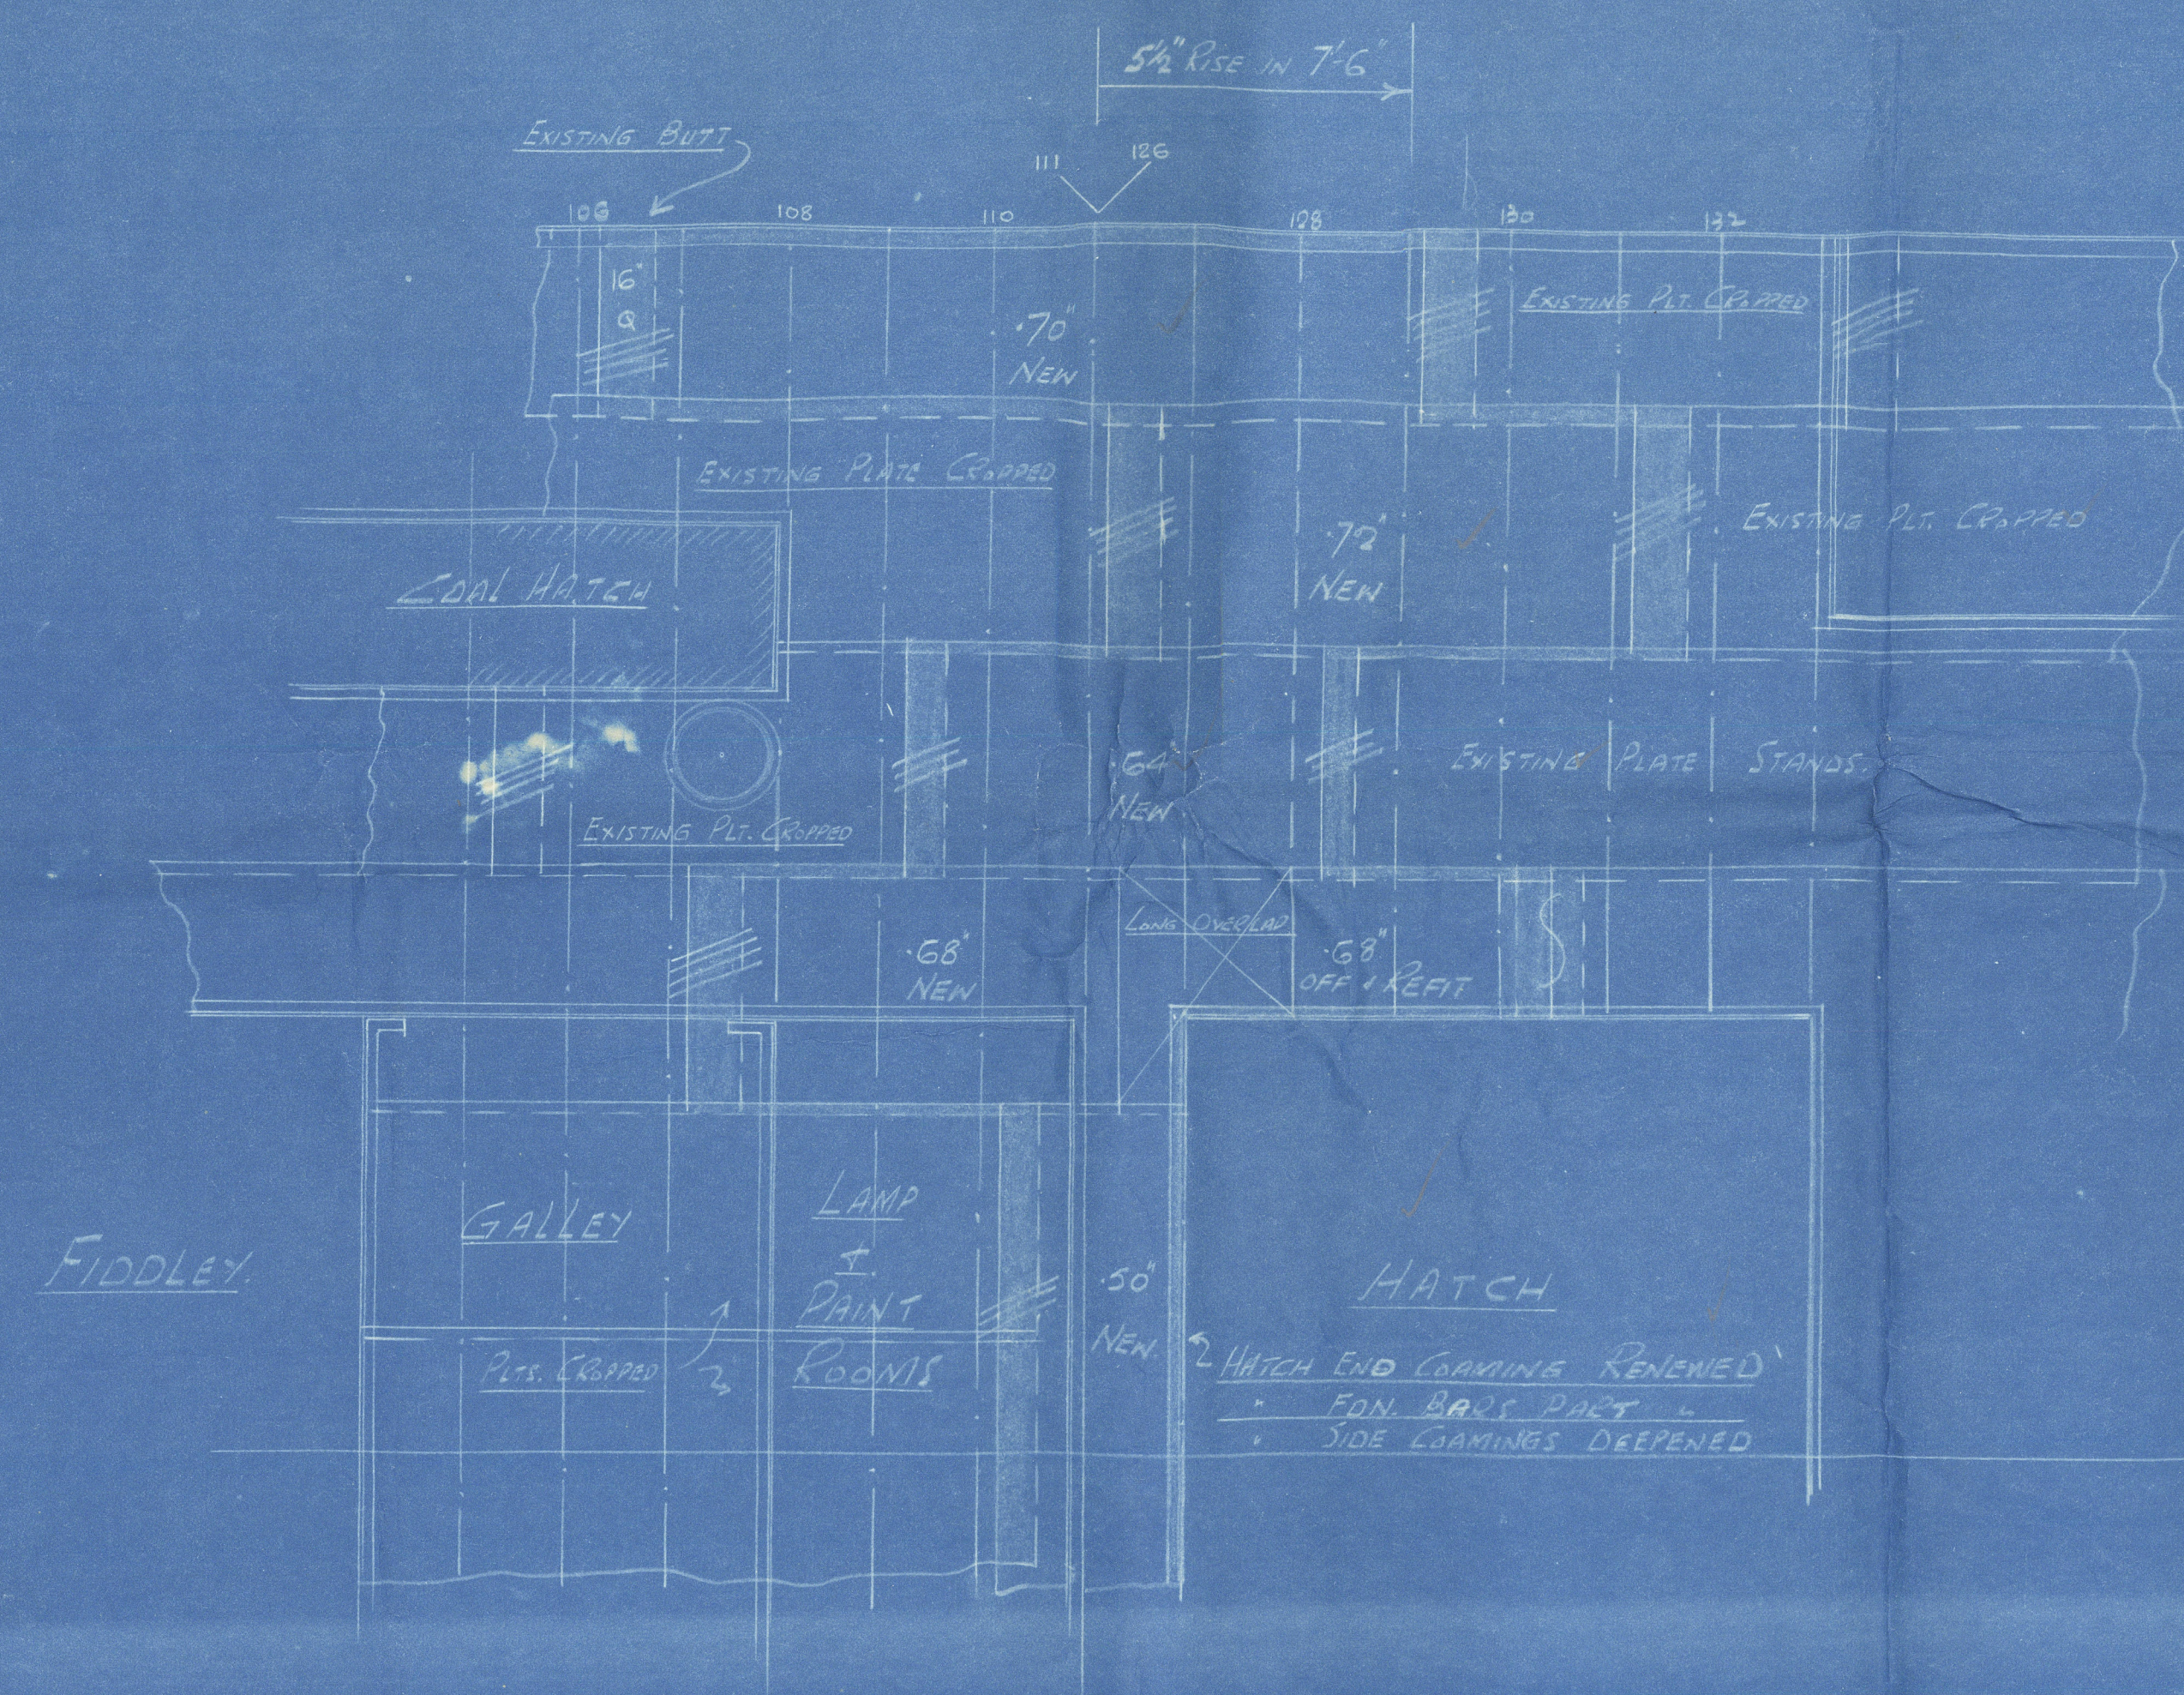

17.11.34



REMAIN



© 2020

Lloyd's Register  
Foundation



W 432-0274

1/2 "MANGALORE" Mod rept. No 1538.  
PROPOSED ALTERATIONS.  
(Man in dup)

REMAIN

W432-0274



© 2020  
Lloyd's Register  
Foundation