
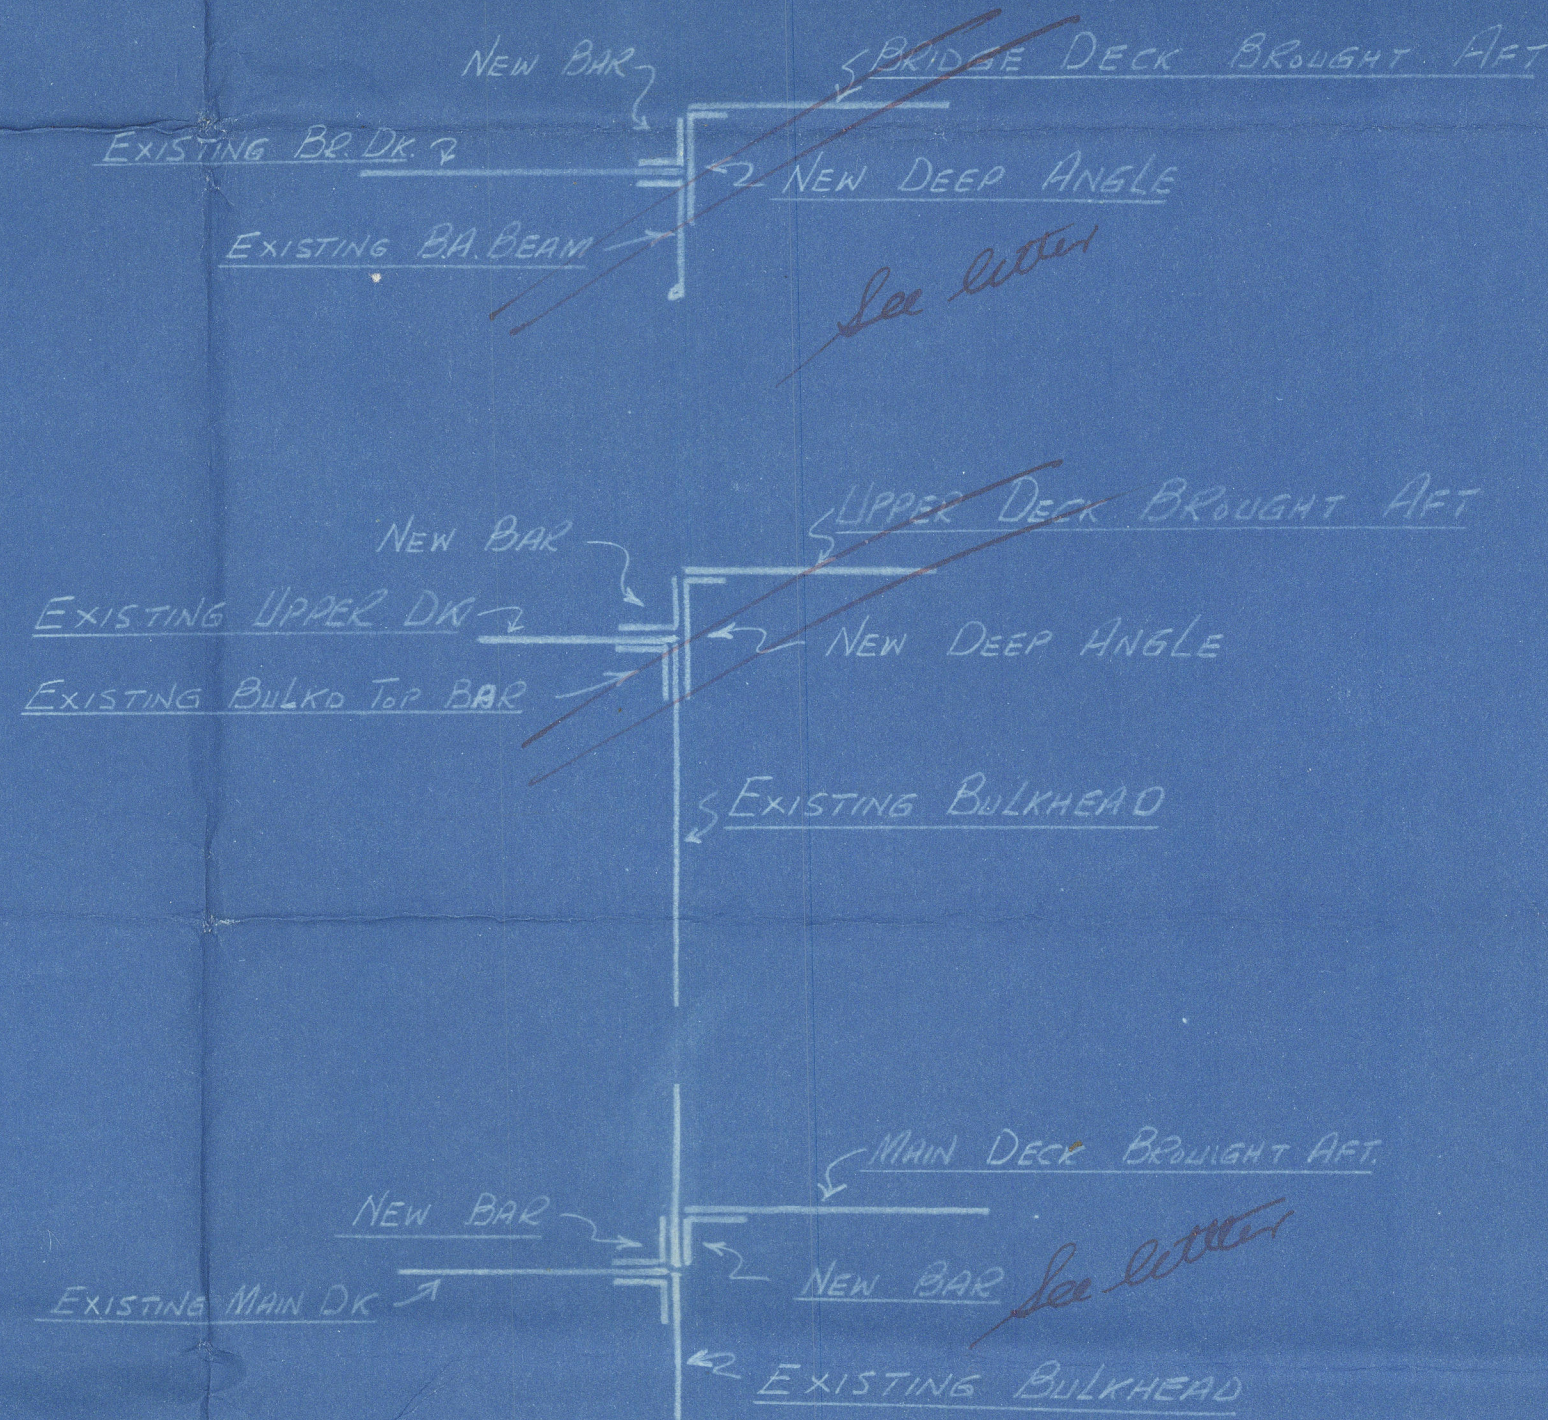


20.10.34

# 5/8 "MANGALORE" + "MATHURA"

PROPOSED ARRANGEMENT OF SHELL + DECKS AT JUNCTION  
OF FRAMES 111 + 126 AFTER SHORTENING VESSEL BY 37'-6"

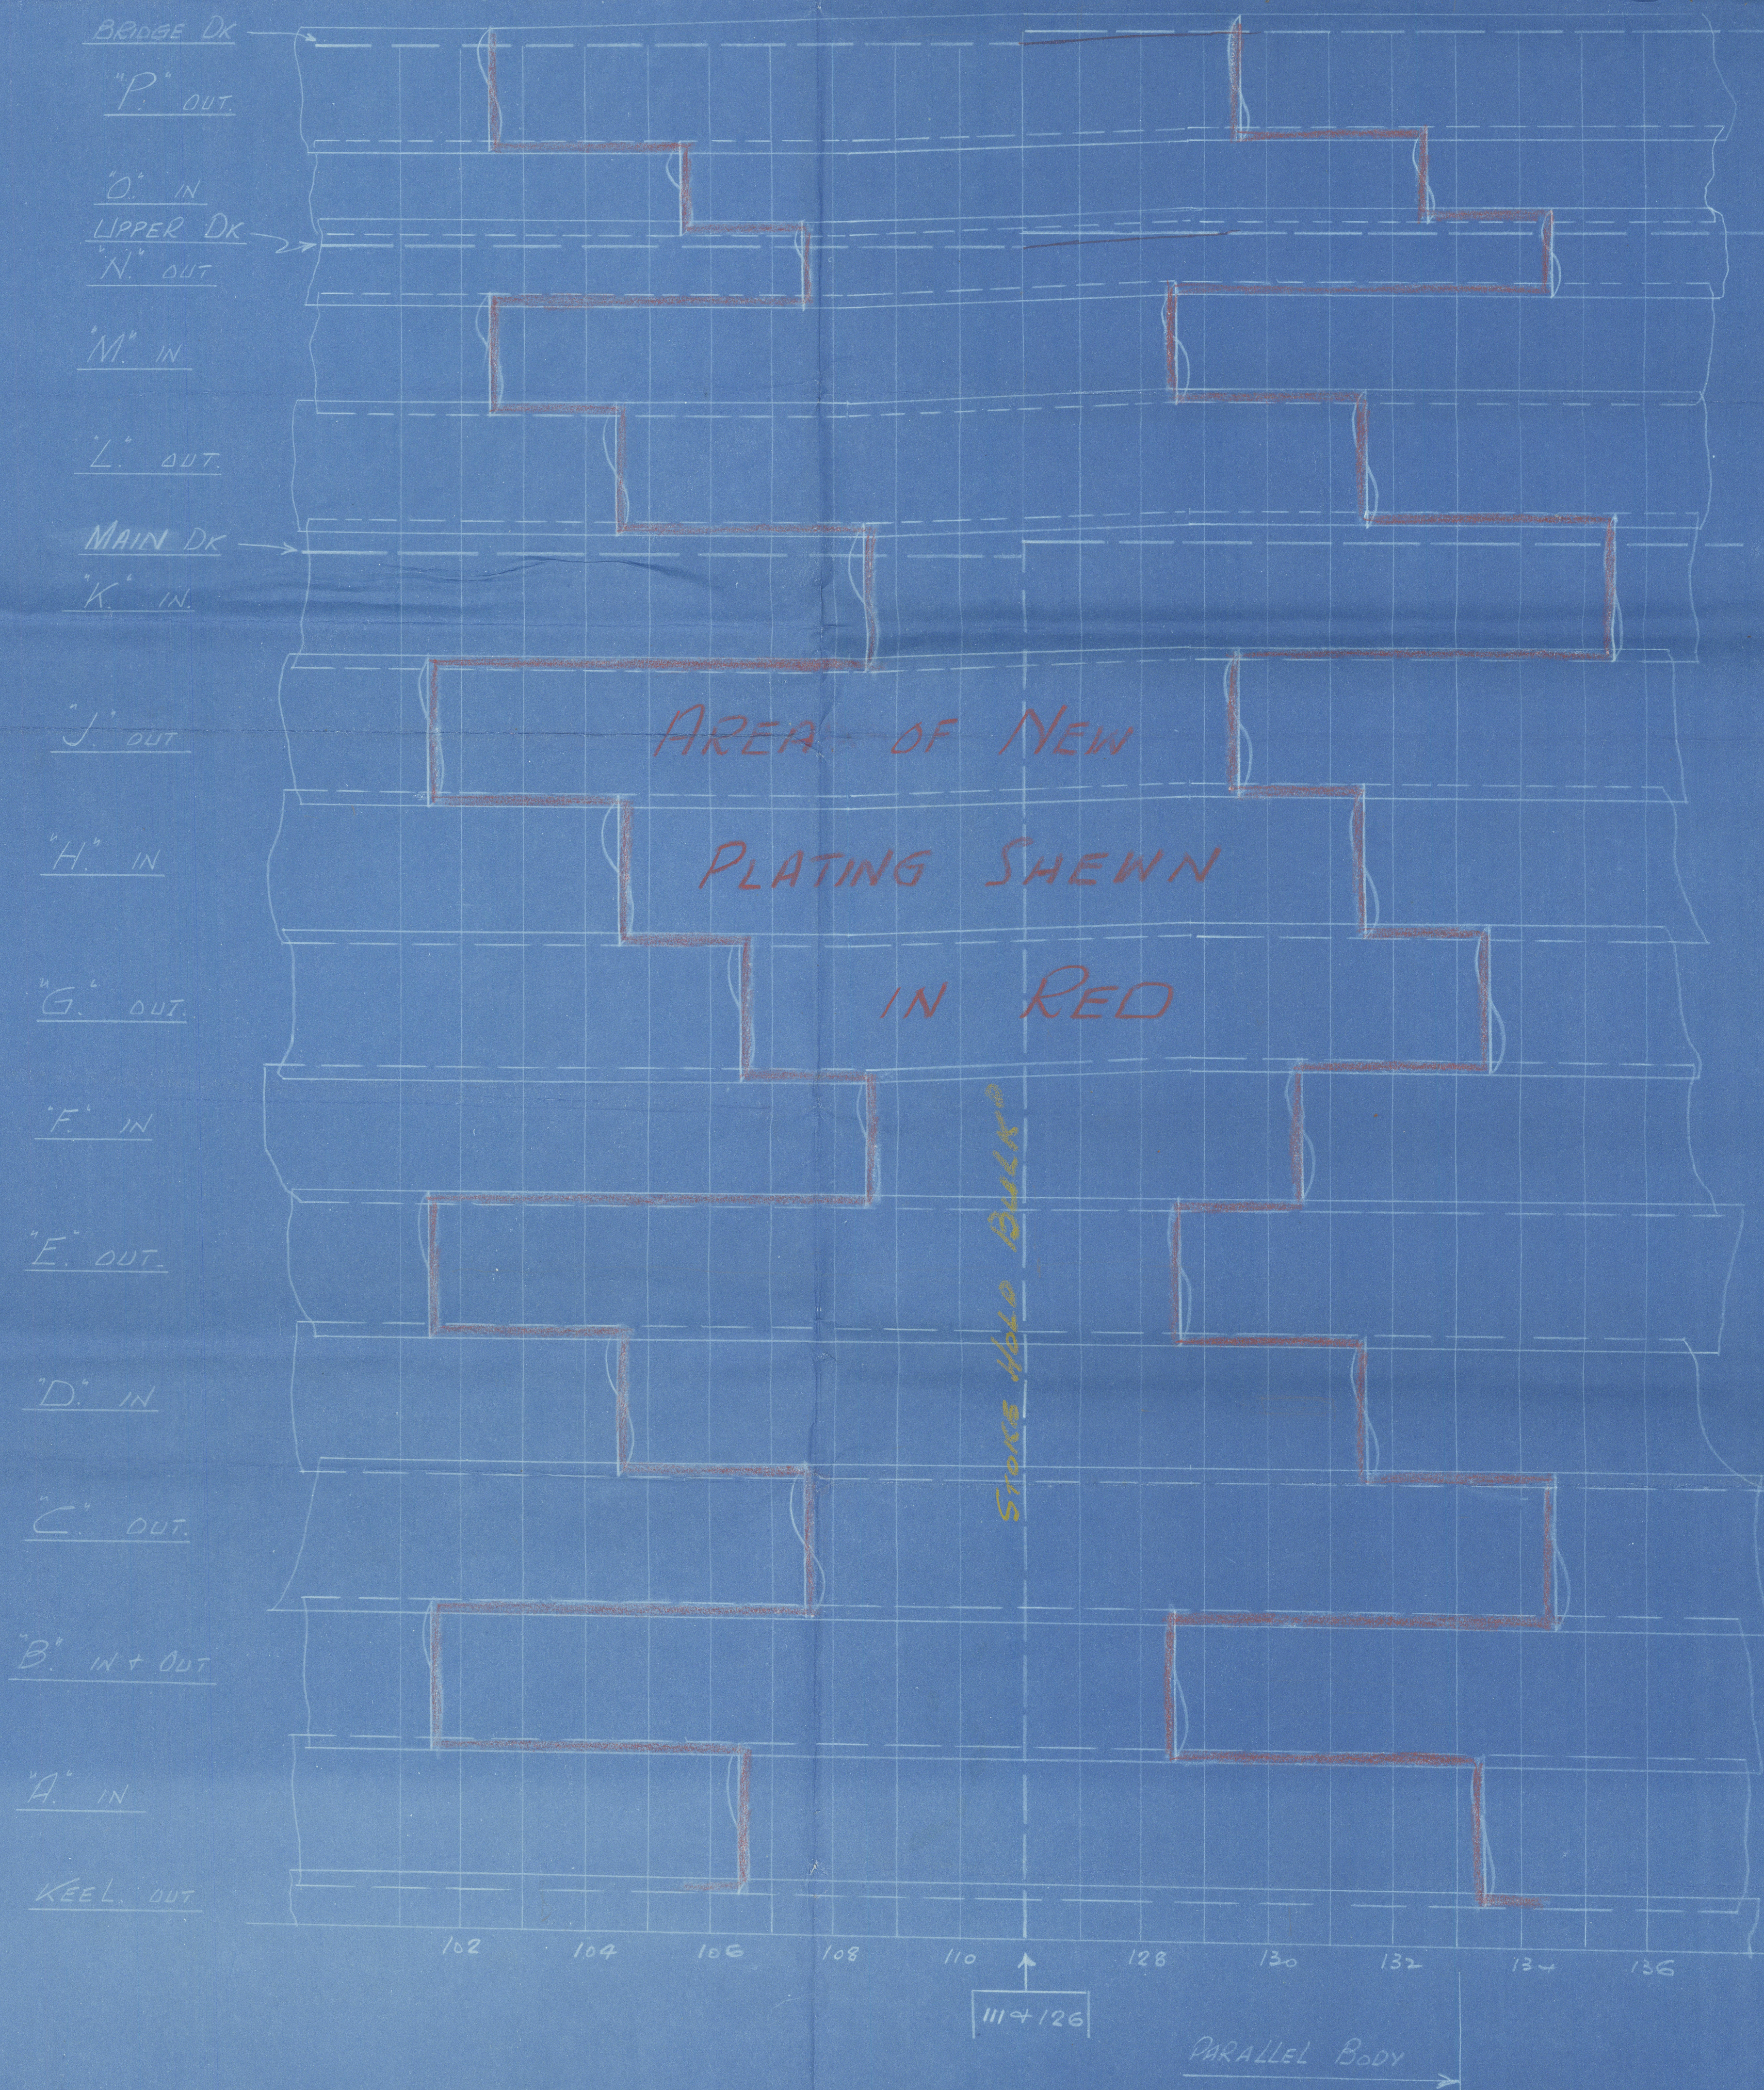

SECTIONS AT THREE DECKS AT JUNCTION  
OF FRAMES 111 + 126 AFTER SHORTENING  
SHIP. (SECTIONS ARE CLEAR OF HOUSES +  
CASINGS) DIFFERENCE IN SHEER HEIGHTS  
IS APPROX. 5/8"

20.10.34



© 2020  
Lloyd's Register  
Foundation

W432-0215



PROPOSED ALTERATIONS

S/S. MANGALORE.

S/S. MATHURA.

S.S. "Mangalore"  
M.D.B. RPT. No. 15385

W432-0275



© 2020

Lloyd's Register  
Foundation