
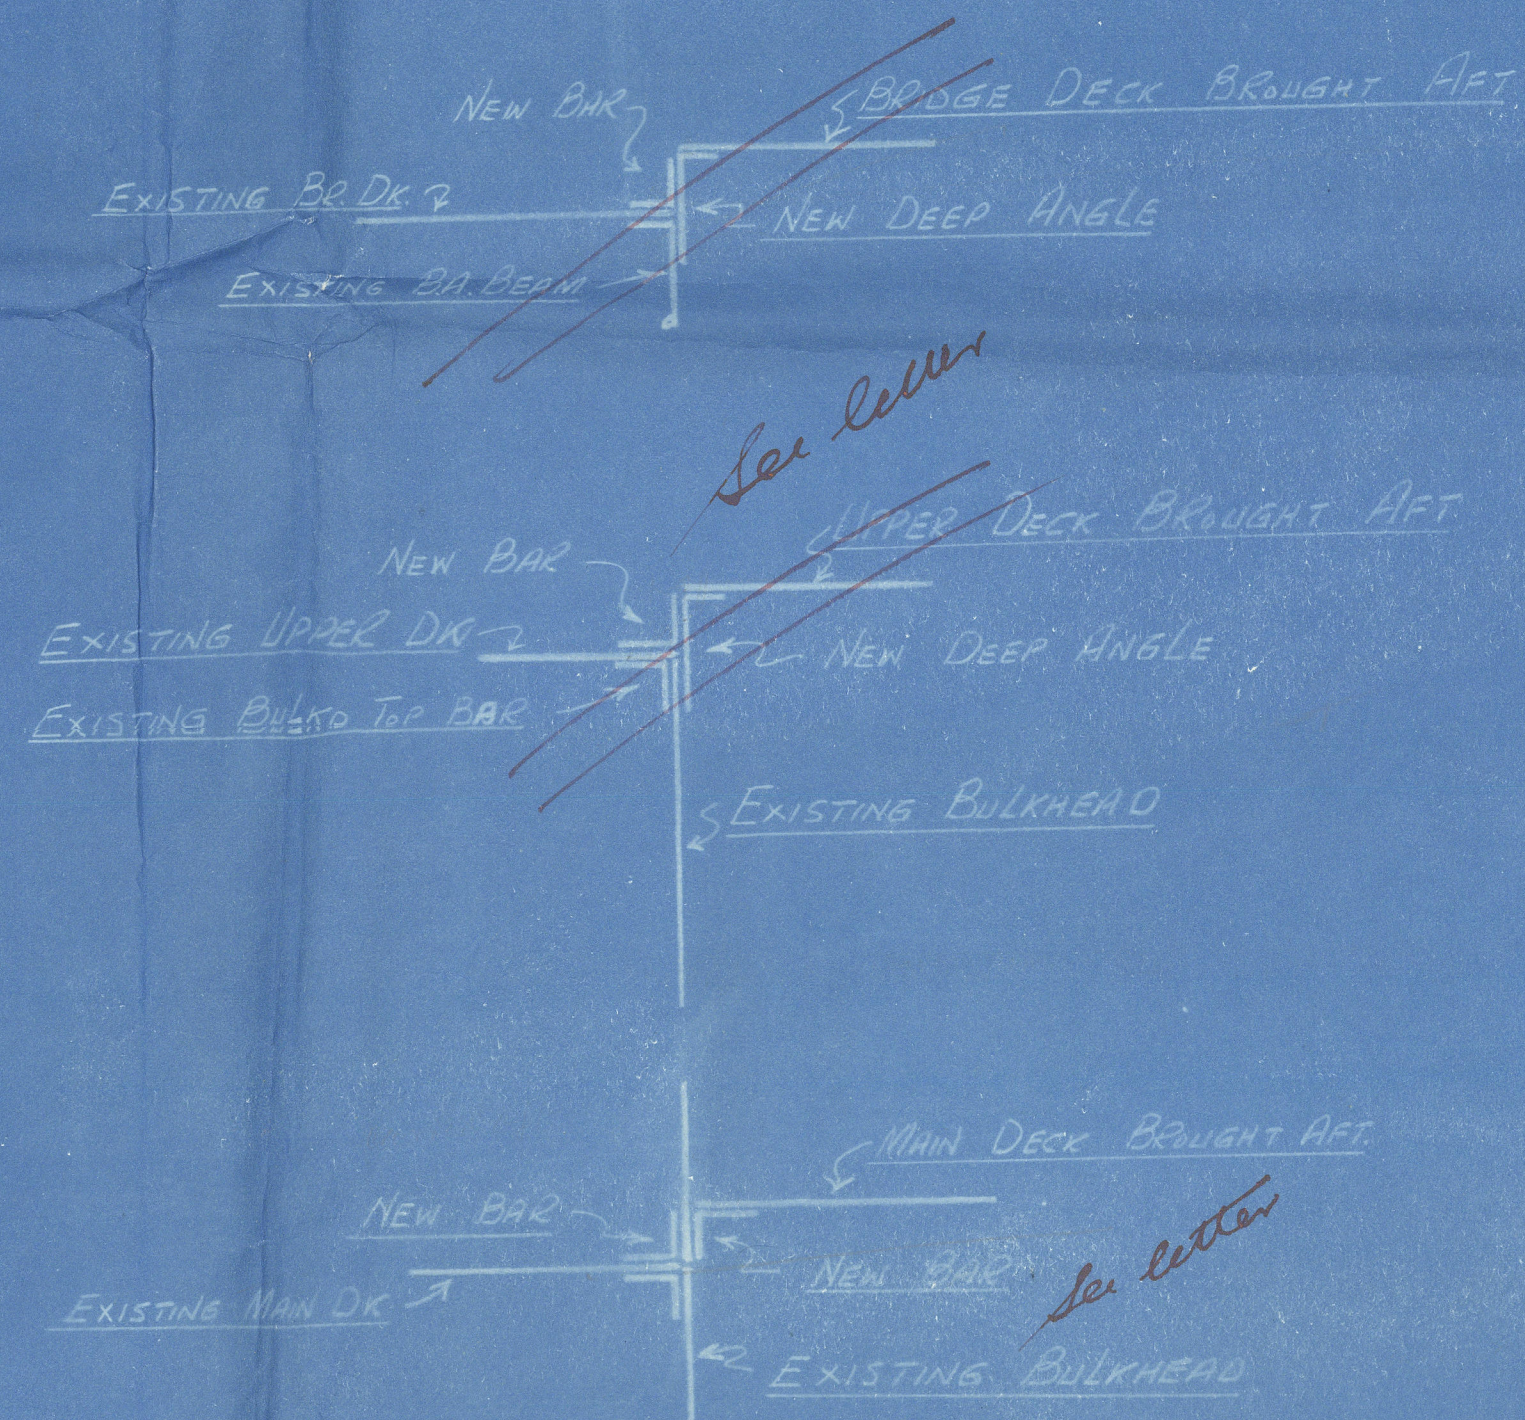


# 5/8 "MANGALORE" + "MATHURA"

PROPOSED ARRANGEMENT OF SHELL & DECKS AT JUNCTION  
OF FRAMES 111 + 126 AFTER SHORTENING VESSEL BY 37'6"

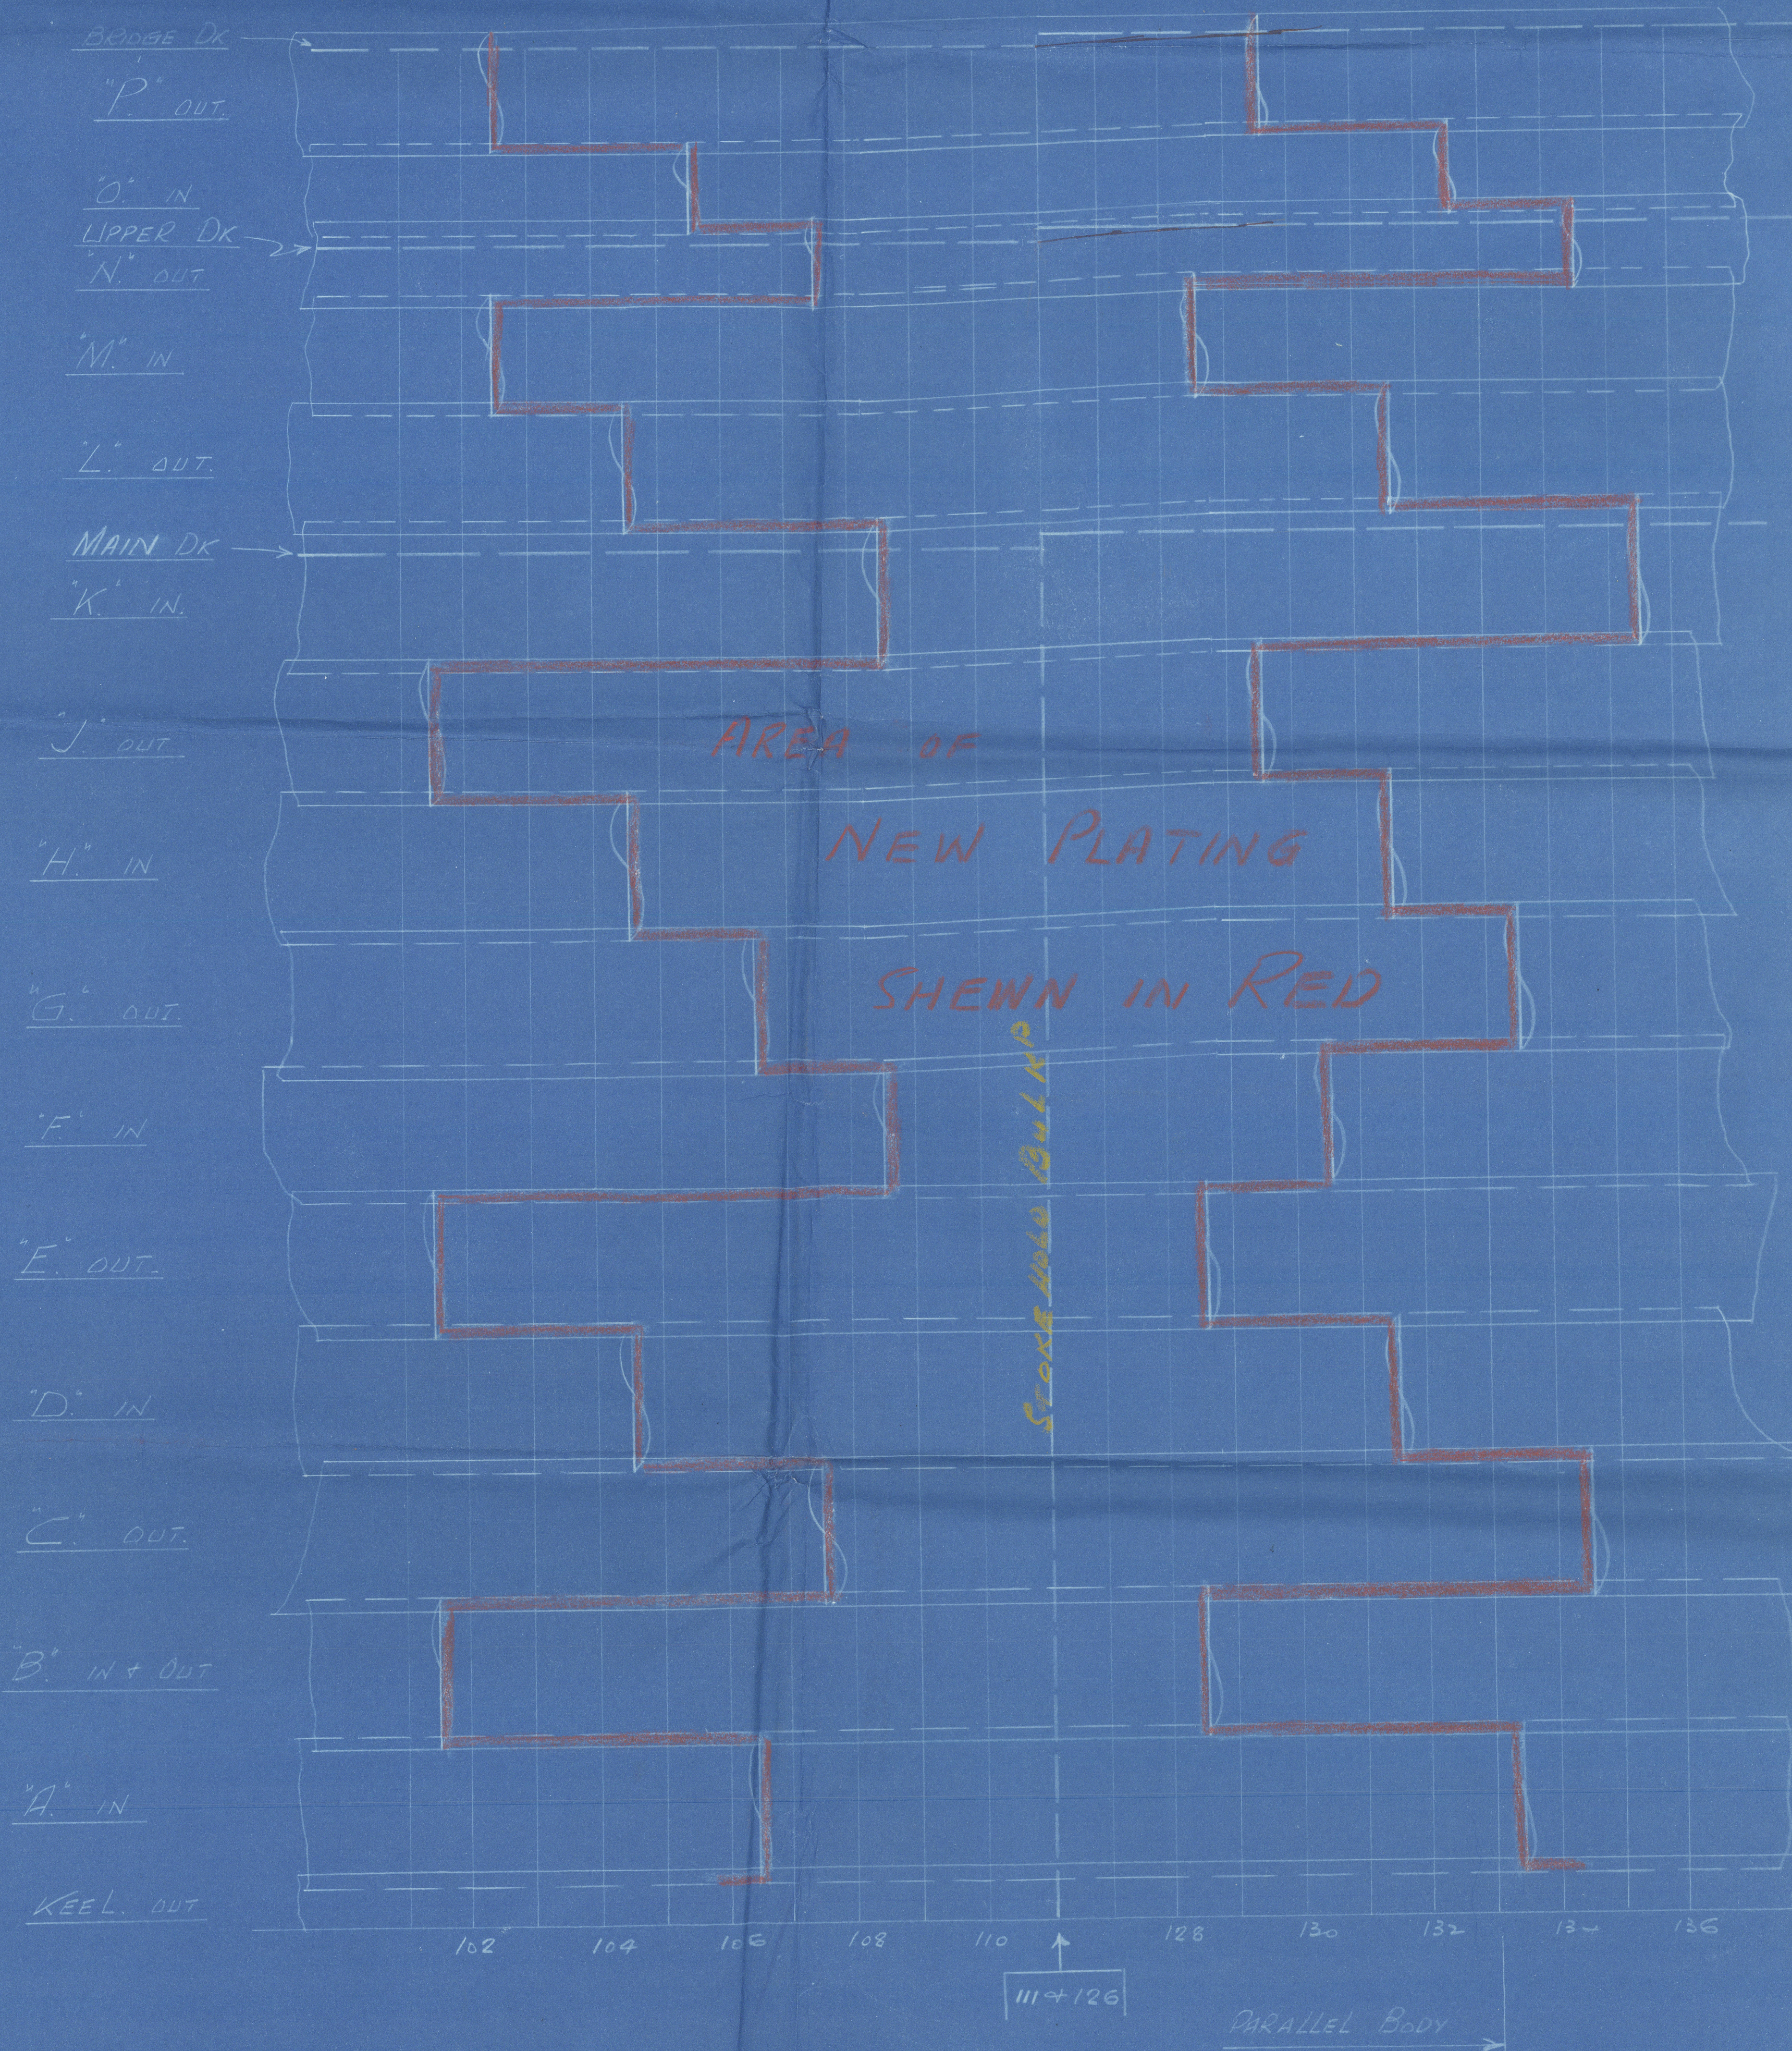

SECTIONS AT THREE DECKS AT JUNCTION  
OF FRAMES 111 + 126 AFTER SHORTENING  
SHIP. (SECTIONS ARE CLEAR OF HOUSES +  
CASINGS) DIFFERENCE IN SHEER HEIGHTS  
IS APPROX. 5 1/2"

24.10.20



RETAIN

RETAIN



© 2020

Lloyd's Register  
Foundation



PROPOSED ALTERATIONS (Plan indep.)

5/3 MANGALORE Mdb rept. No 15-385

5/4 MATHURA

RETAIN

RETAIN

w432-0276



© 2020

Lloyd's Register  
Foundation