


STANDARD "A" TYPE.



SCALE 1 INCH TO A FOOT.
100 LBS. W. P. "LLOYDS."

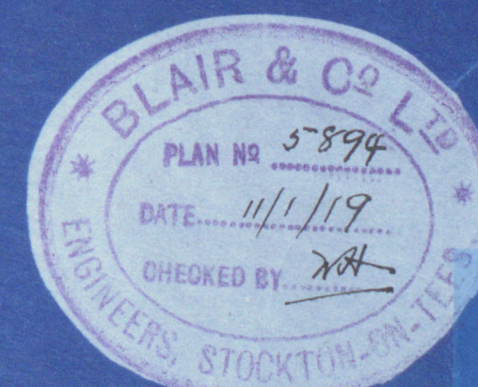

For Enclosure to
Messrs Lloyd
Engineer Surveyors
Middleboro

TYPE.

100 LBS. W. P. "LLOYDS."

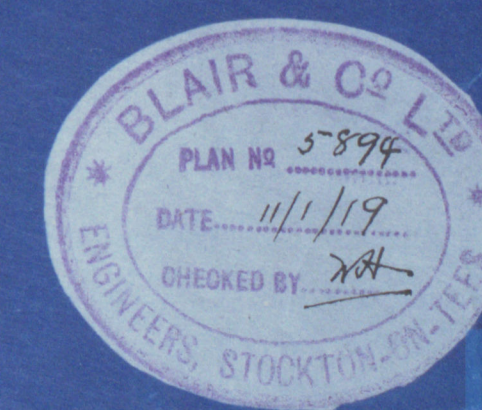

W433 F0081 1/2 - Renal
Foundation

Messrs Blair & Co *Engines*
Donkey Boilers Nos E. 1056-1905
E. 1069-1907
E 1070-1908

for

Messrs Richardson Duck & Co

S.S. Nos 677-678 & 679

Working Press 100 lbs

Duplicate of Plan approved for
E 1054 on 10.7.18

E 1056

No.	6019
LLOYD'S TEST	
W.P.	200
22.7.19-W.M.	

S.S. Charlton
Report No.
10491

E 1069

No.	6083
LLOYD'S TEST	
W.P.	200
10.9.19-W.M.	

S.S. Peterston
Dubb Rpt
10545

E 1070

No.	6062
LLOYD'S TEST	
W.P.	200
5.12.19-W.M.	

SS. Liberton
Dubb Report
10625

Duplicate of No E 1054
approved 10.7.18

Lloyd's Register
Foundation