
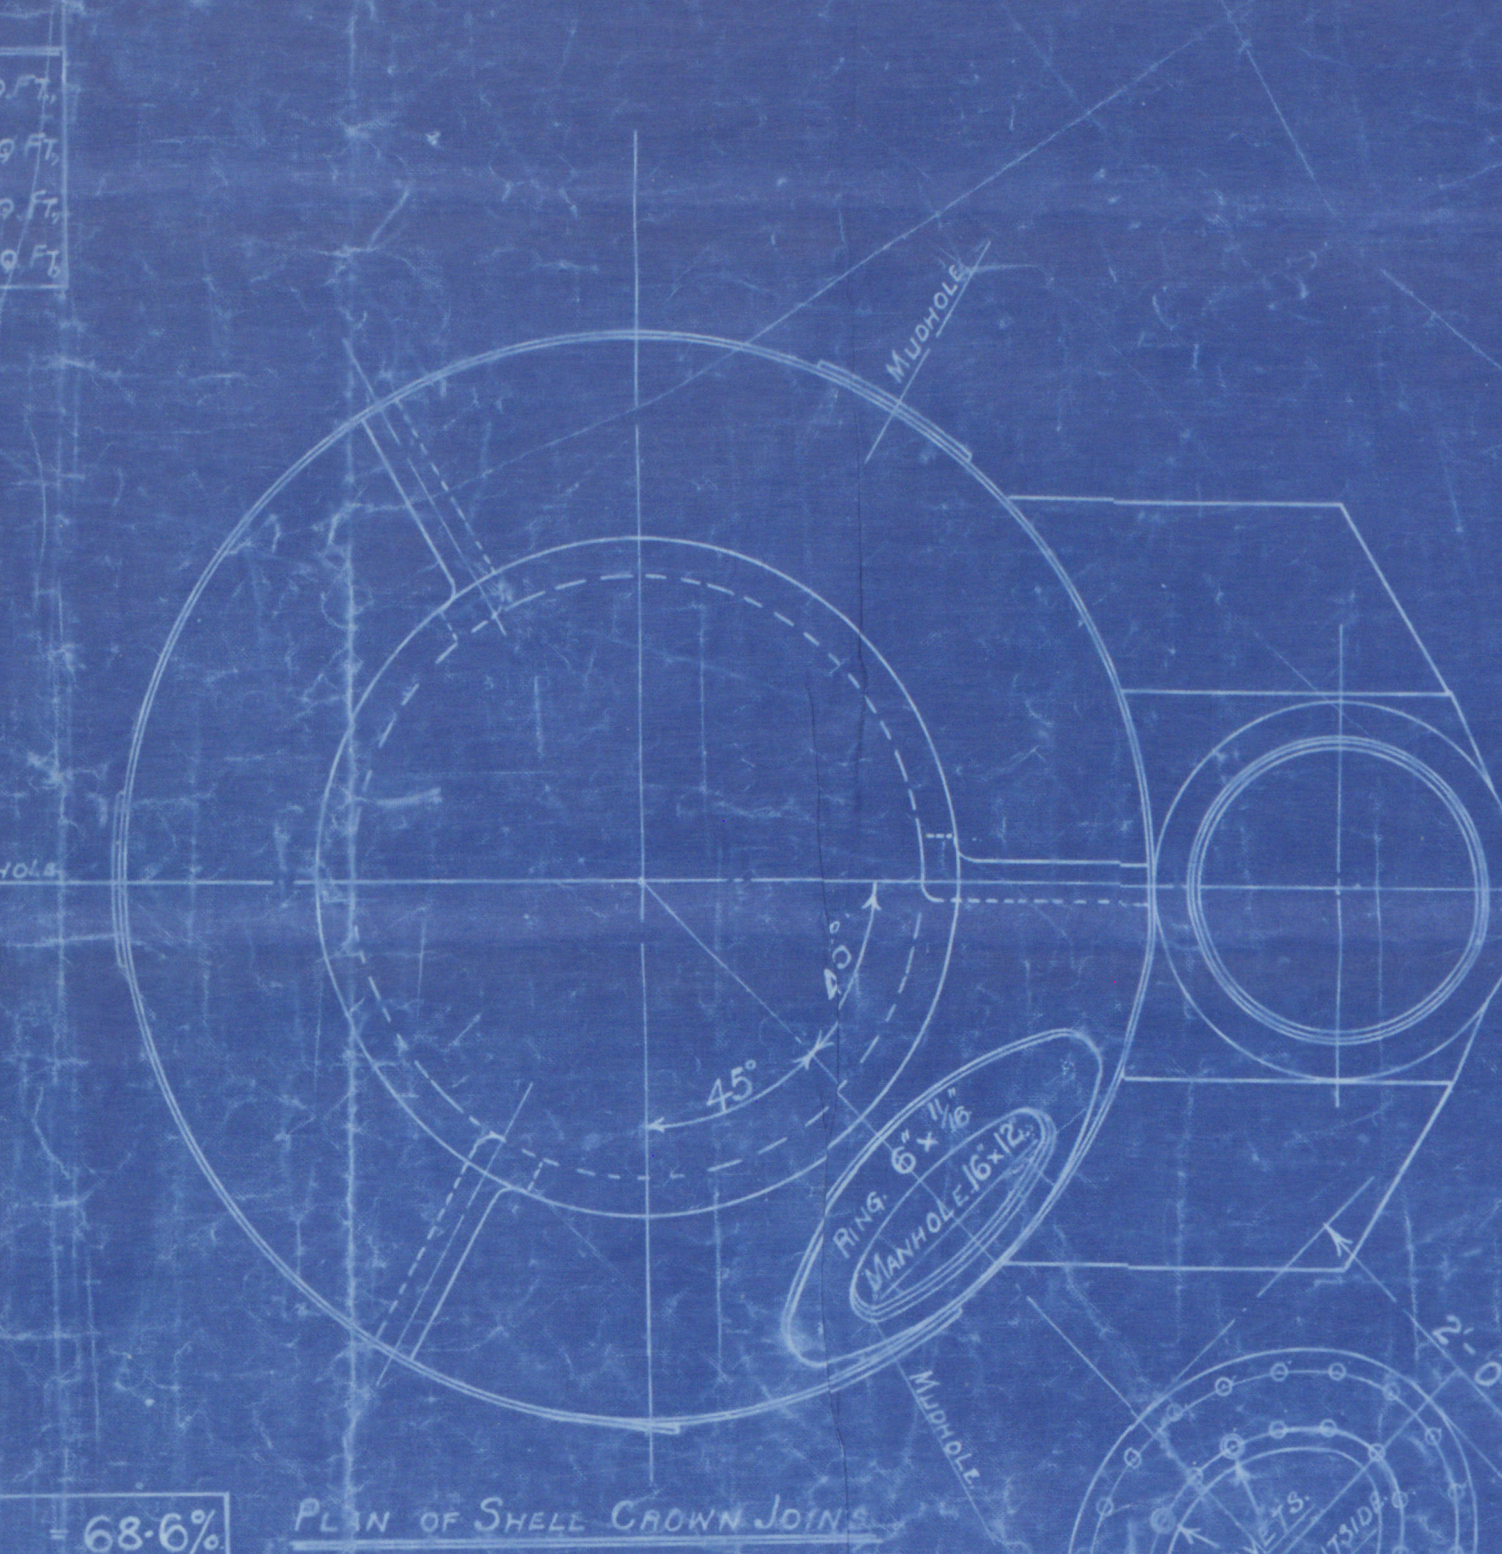
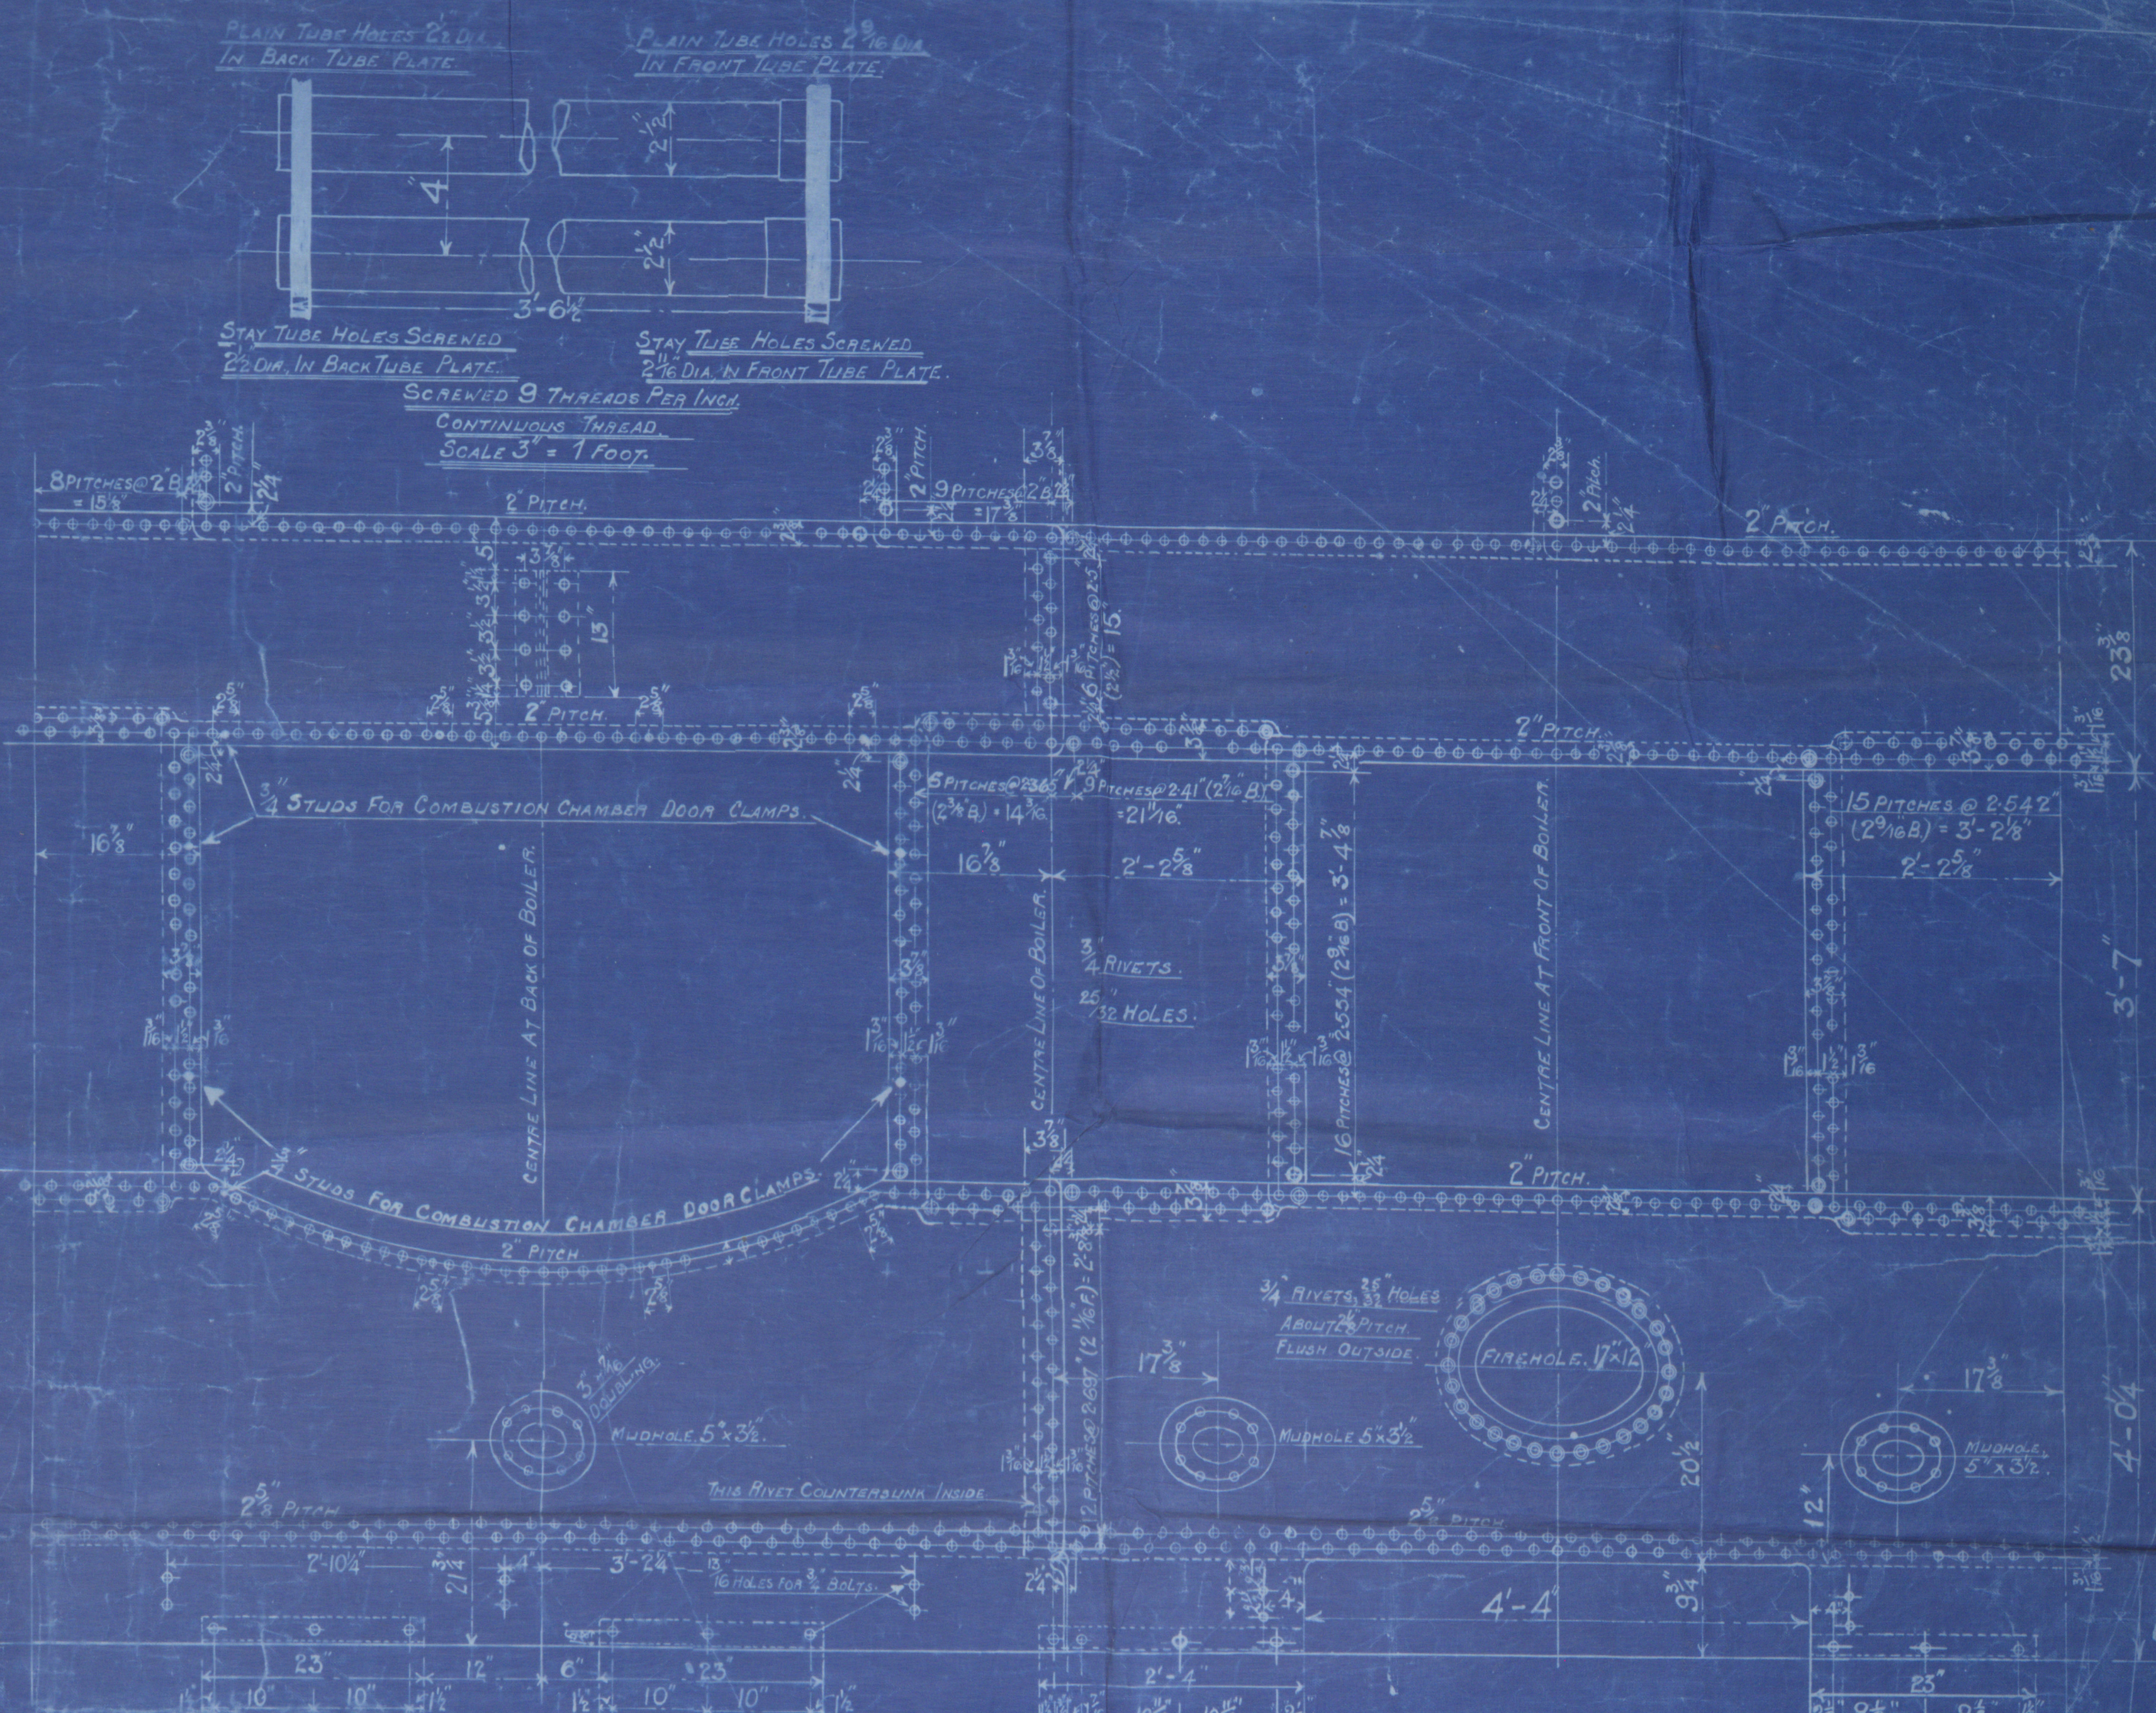
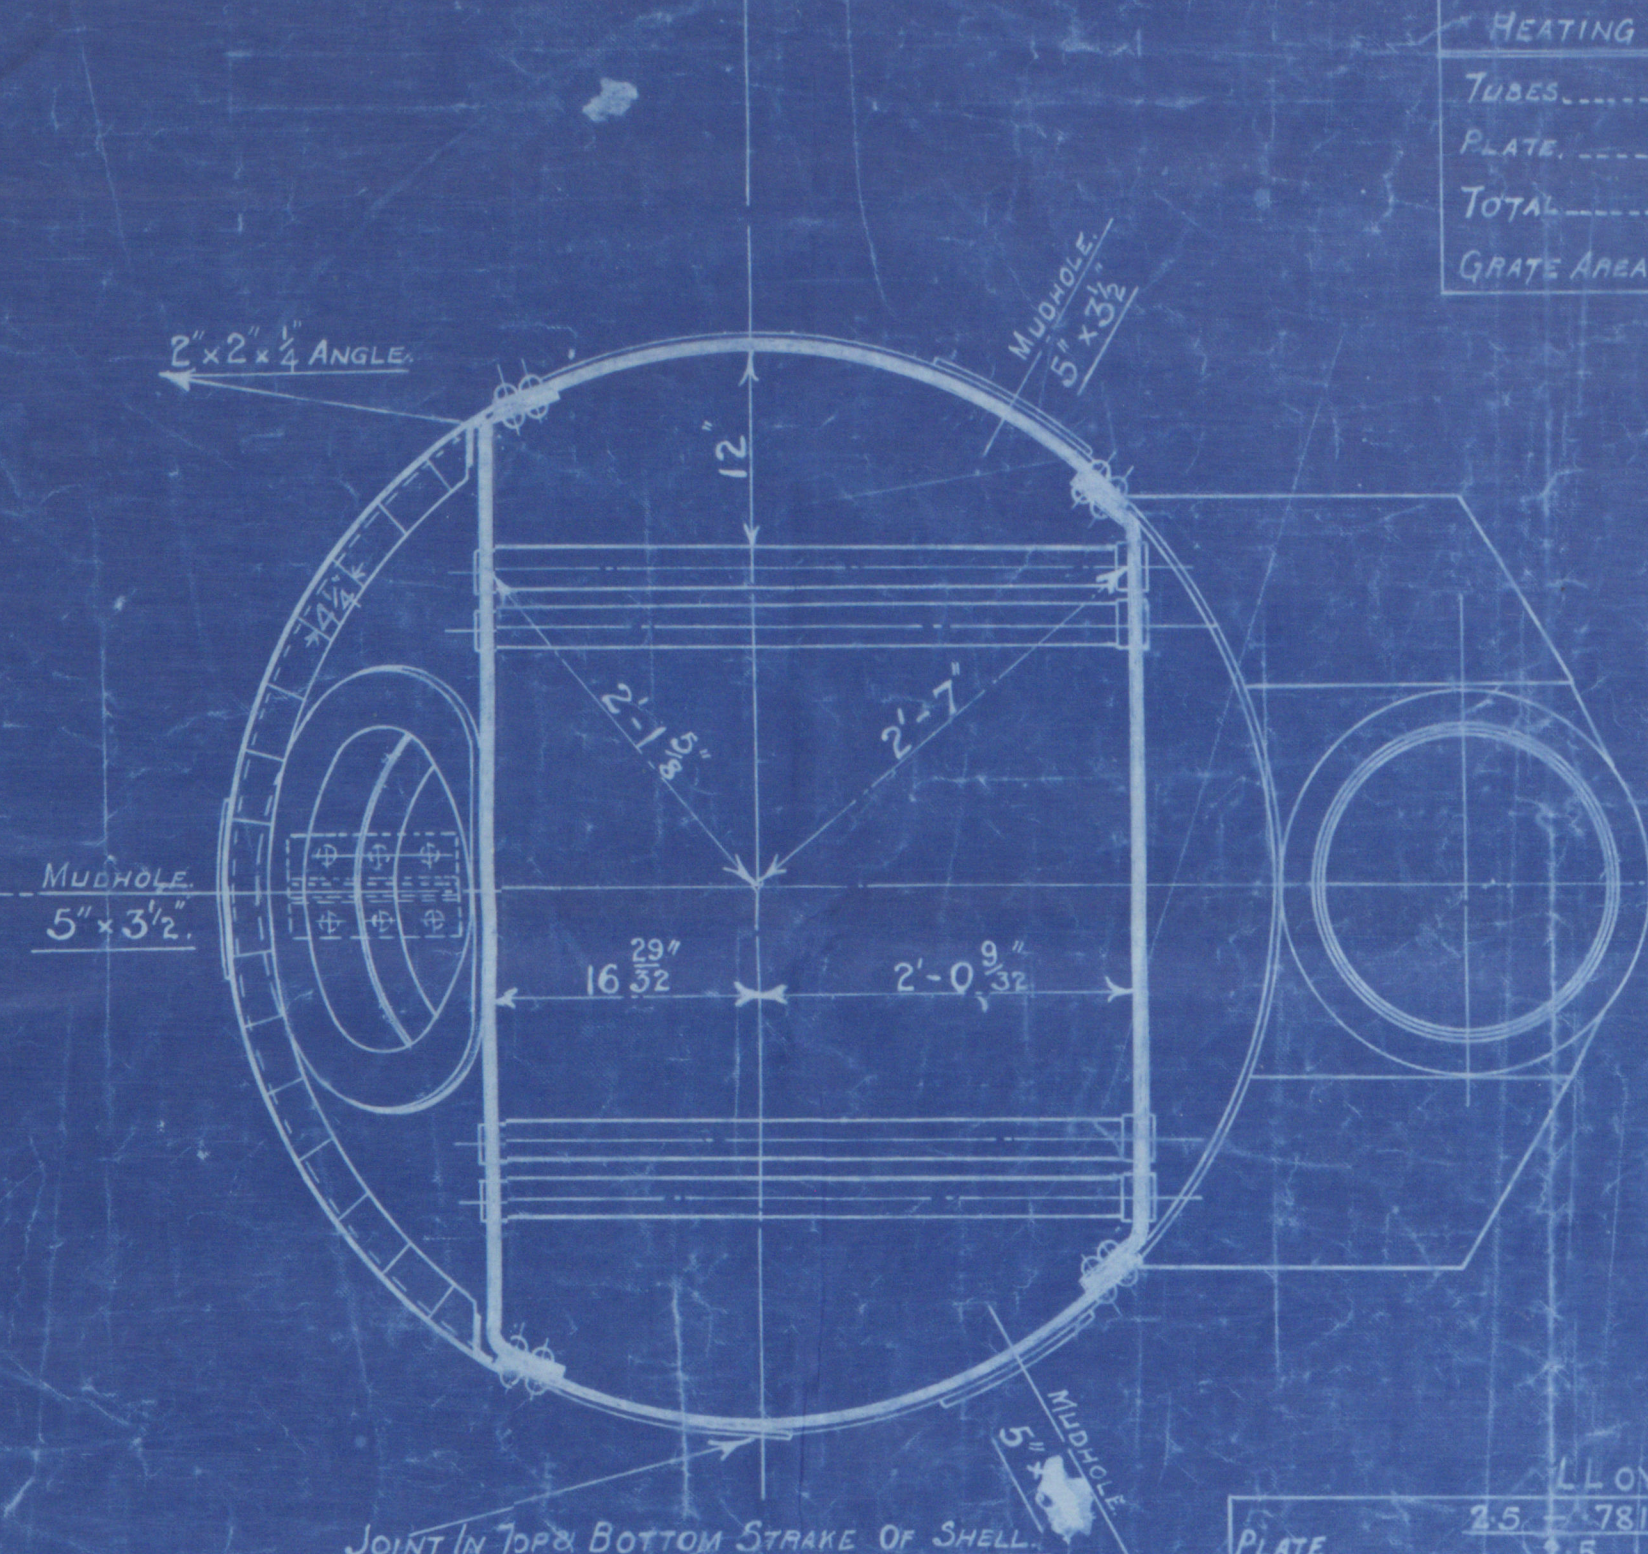


COCHRAN PATENT VERTICAL MULTITUBULAR BOILER

HORIZONTAL FLUE TUBES

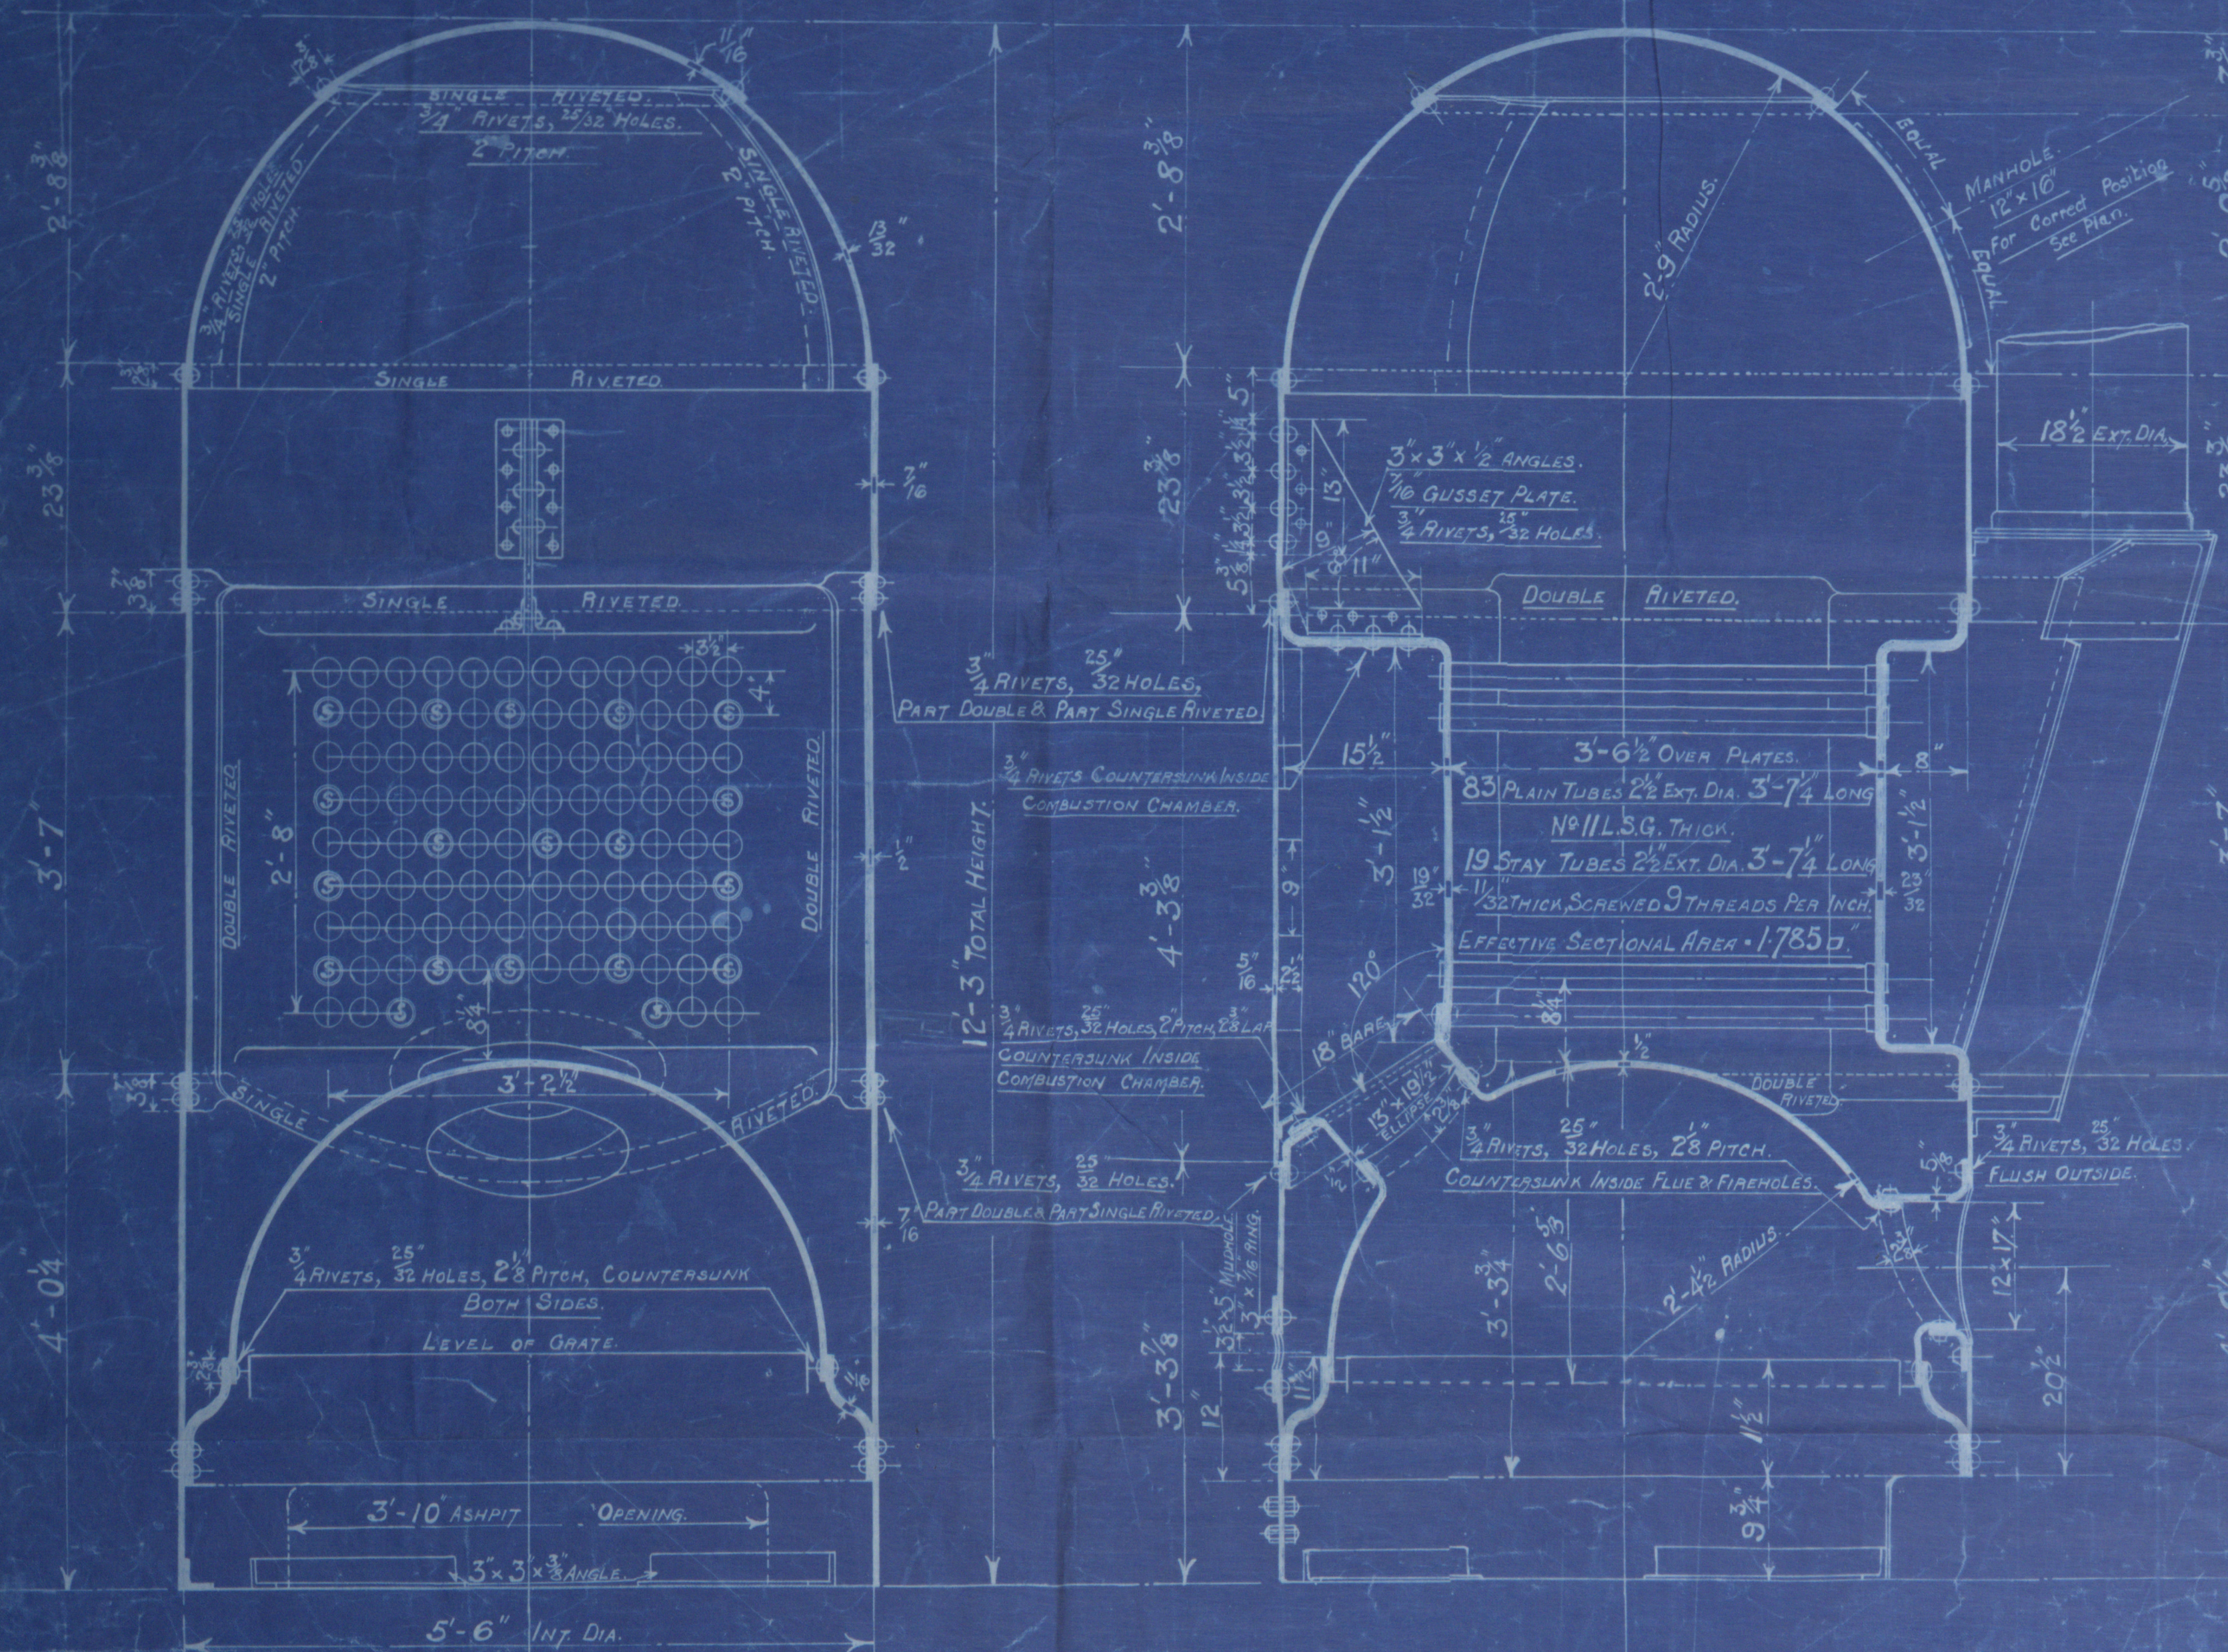

Approved 25-2-22 for Boiler No 8859

PATENT BOILER No 11,249
5'-6" x 12'-3" x 300 # x 100 LBS.

SCALE 1/4" = 1 FOOT

SIEMENS MARTIN MILD STEEL PLATES
TENSILE TESTS

PLATES NOT EXPOSED TO FLAME OR FLANGED..... 28 TO 32 TONS
PLATES EXPOSED TO FLAME OR FLANGED & RIVETS..... 26 TO 30 TONS

DRAWING No 11,249

N.R.

STANDARD
SURVEY: LLOYDS.

COCHRAN & CO ANNAN LTD
ENGINEERS & BOILERMAKERS
ANNAN, SCOTLAND.

	LLOYDS	

Lloyds Register Foundation

RETAIN

W433-0161

COCHRAN & CO., ANNAN, LD.

Boiler No. 11249. ✓

Drawing No. 12710.

W.P. 100 lbs.

RETAIN



© 2019

Lloyd's Register
Foundation