


Midship Section
Craig Taylor & Co
No 94

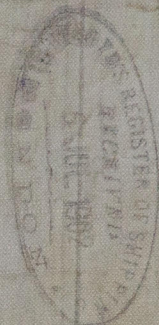

~~Ammanthura~~
S.S. "Dicio"
Moro Repou - No 3578

RETAIN



© 2019

Lloyd's Register
Foundation

W434-0055

19. 6. 02
5. 7. 02
30. 8. 02

CLASS 100 A.I. LLOYDS

SINGLE DECKER.

NOTES.

1
2 BREADTH 18.50 ✓
2 GIRTH 37.20 ✓
DEPTH 21.93 ✓
F.N# 7763 ✓ 76/80

248.5 × 7763 - 19291.05 PLATING N# 187/19900

POOP 30.0 8) 19291.05 ✓
BRIDGE 58.0 2411.38 ✓
FLE 26.5 ~~46~~
118.5118.5 4468.28 ✓
248.5 = 46 9645.52 ✓
11092348 ✓
19291.05 ✓
EQUIPMENT N# 20400.28 ✓
1150
19291
20400.1

$$\frac{L}{D} = 11.33$$
$$\frac{L}{B} = 6.71$$


J.F.L.
19/6/12

W1434-0055