

Profile &
Deck Plan
Craig Taylor 100

Re 94

S.I. Dicido "3548"
~~Consolidated~~
New Report - Re 3578


RETAIN

W434-0056 © 2019

Lloyd's Register
Foundation

19.6.02
5.7.02
30.8.02


S.S. No 94.
LONGITUDINAL SECTION
SCALE 1/8 INCH = 1 FOOT.

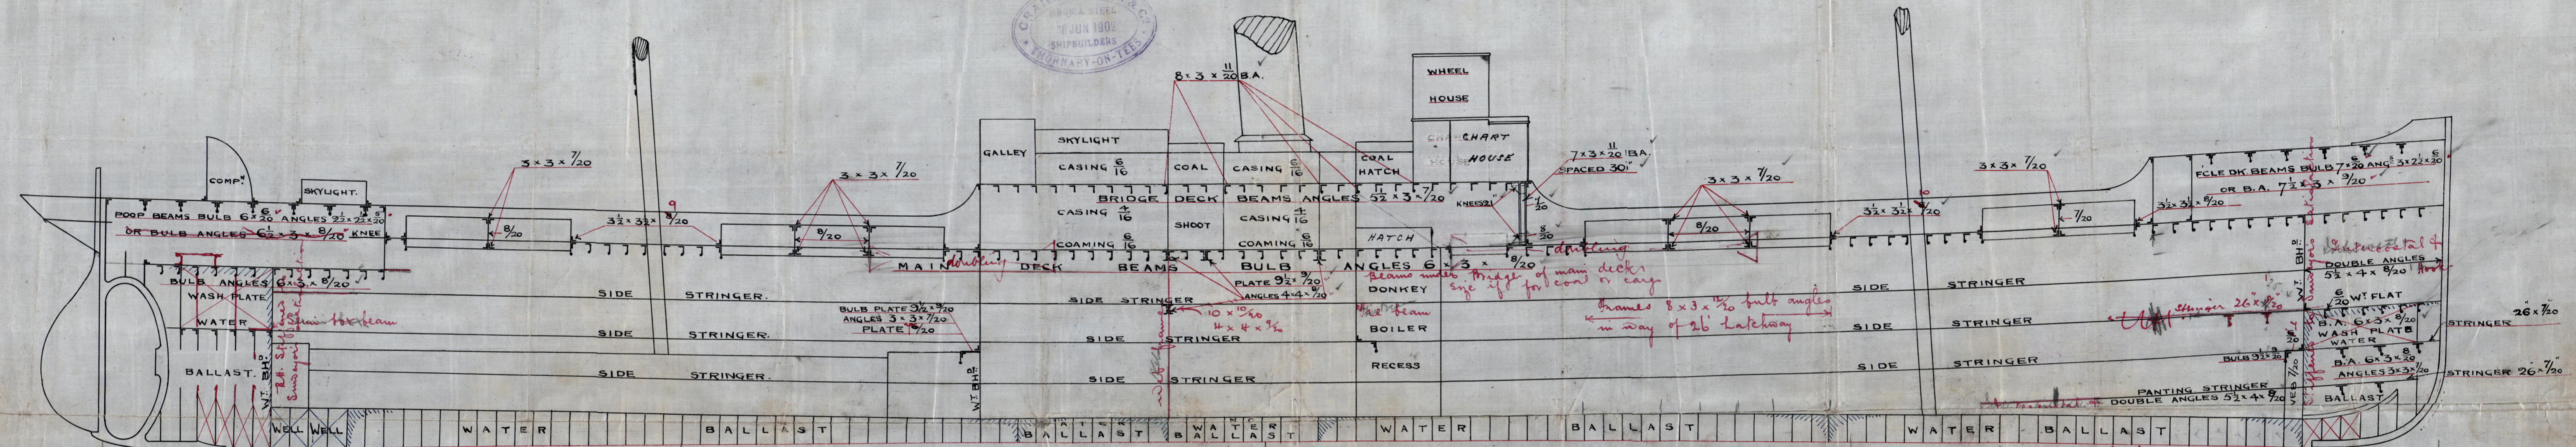

Rise through frames & shell
spaces 6 diam. apart
in peaks

105 in ship

Rise through frames & shell
spaces 6 diam. apart in
peaks

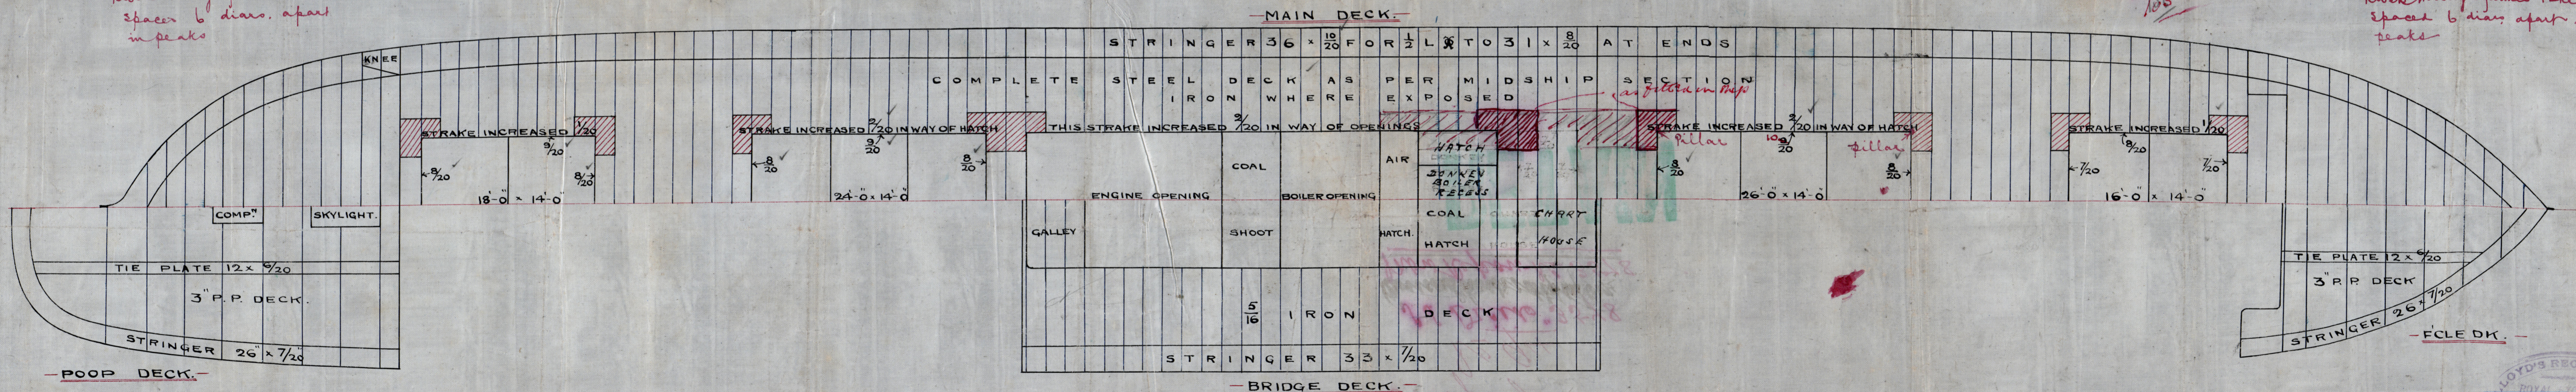

J.P.L.
19/6/02