

MIDSHIP SECTION. STANDARD STEAMER.

DIMS. 400'-0" x 52'-0" MLD x 31'-0" MLD
TO CLASS 100A1 LLOYD'S REGISTER

SCALE $\frac{1}{2}$ " = 1 FOOT.

NUMERALS

BREADTH MLD = 52.00

DEPTH MLD = 31.00

85.00 TRANSVERSE N°

LENGTH 400 400

33200 LONGITUDINAL N°

5' TO UPPER DECK = 12.90

d = 27'-5"

COMPLETE LIST OF SECTIONS USED IN BUILDING THIS VESSEL

12" x 3 1/2" x 3 1/2" CHANNEL
8" x 5" DULO ANGLE
9" x 3 1/2" "
10" x 3 1/2" "
6" x 3 1/2" ANGLE
6" x 6" "
3 1/2" x 3 1/2" "
5" x 5" "

DOUBLE BUTT

FOR SCANTLING AT INTERMEDIATE FRAMES SEE SECTION BELOW

BULKHEADS AS PER RULE 5 1/2" x 12" CHANNEL (SEE PROFILE)

STEW 10 1/2" x 2 1/2"

PROPELLER 10 1/2" x 1 1/2"

RUDDER 10 1/2" x 1 1/2"

RIVETS TO BE OF IRON SPACED 15 PER RULE (EXCEPT UPPER D¹)

RUDDER AS PER RULE

ALL BUTTS OVERLAPPED











4 BUTTS IN HEADS & HEADS OF ROLLERS ABOVE 5' IN DIA

1 1/2" COLLIER SPACE DOUBLE RIVETED


EQUIPMENT NUMBER

MILL 100(22+3) = 33200


PROP. DRUMS 100 x 70 = 1700

DECKHOLD 31.3 x 7.5 x 9 = 118

33218

EQUIPMENT

2 DOWN ANCHORS 60 CWT. STEELLESS
1 STREAM 50%
1 KEDGE 7%
270 PATHWAYS 2 1/2" 5/16" LINK CHAIN CABLE
90 1 1/2" STREAM CHAIN OR 1 1/2" STEEL WIRE ROPE
170 1 1/2" HEMP HAWSEY 4 1/2"
2 HYP 90 8" HEMP HAWSEY 2 1/2"
2 HYP 90 4" WIRE 2 1/2"

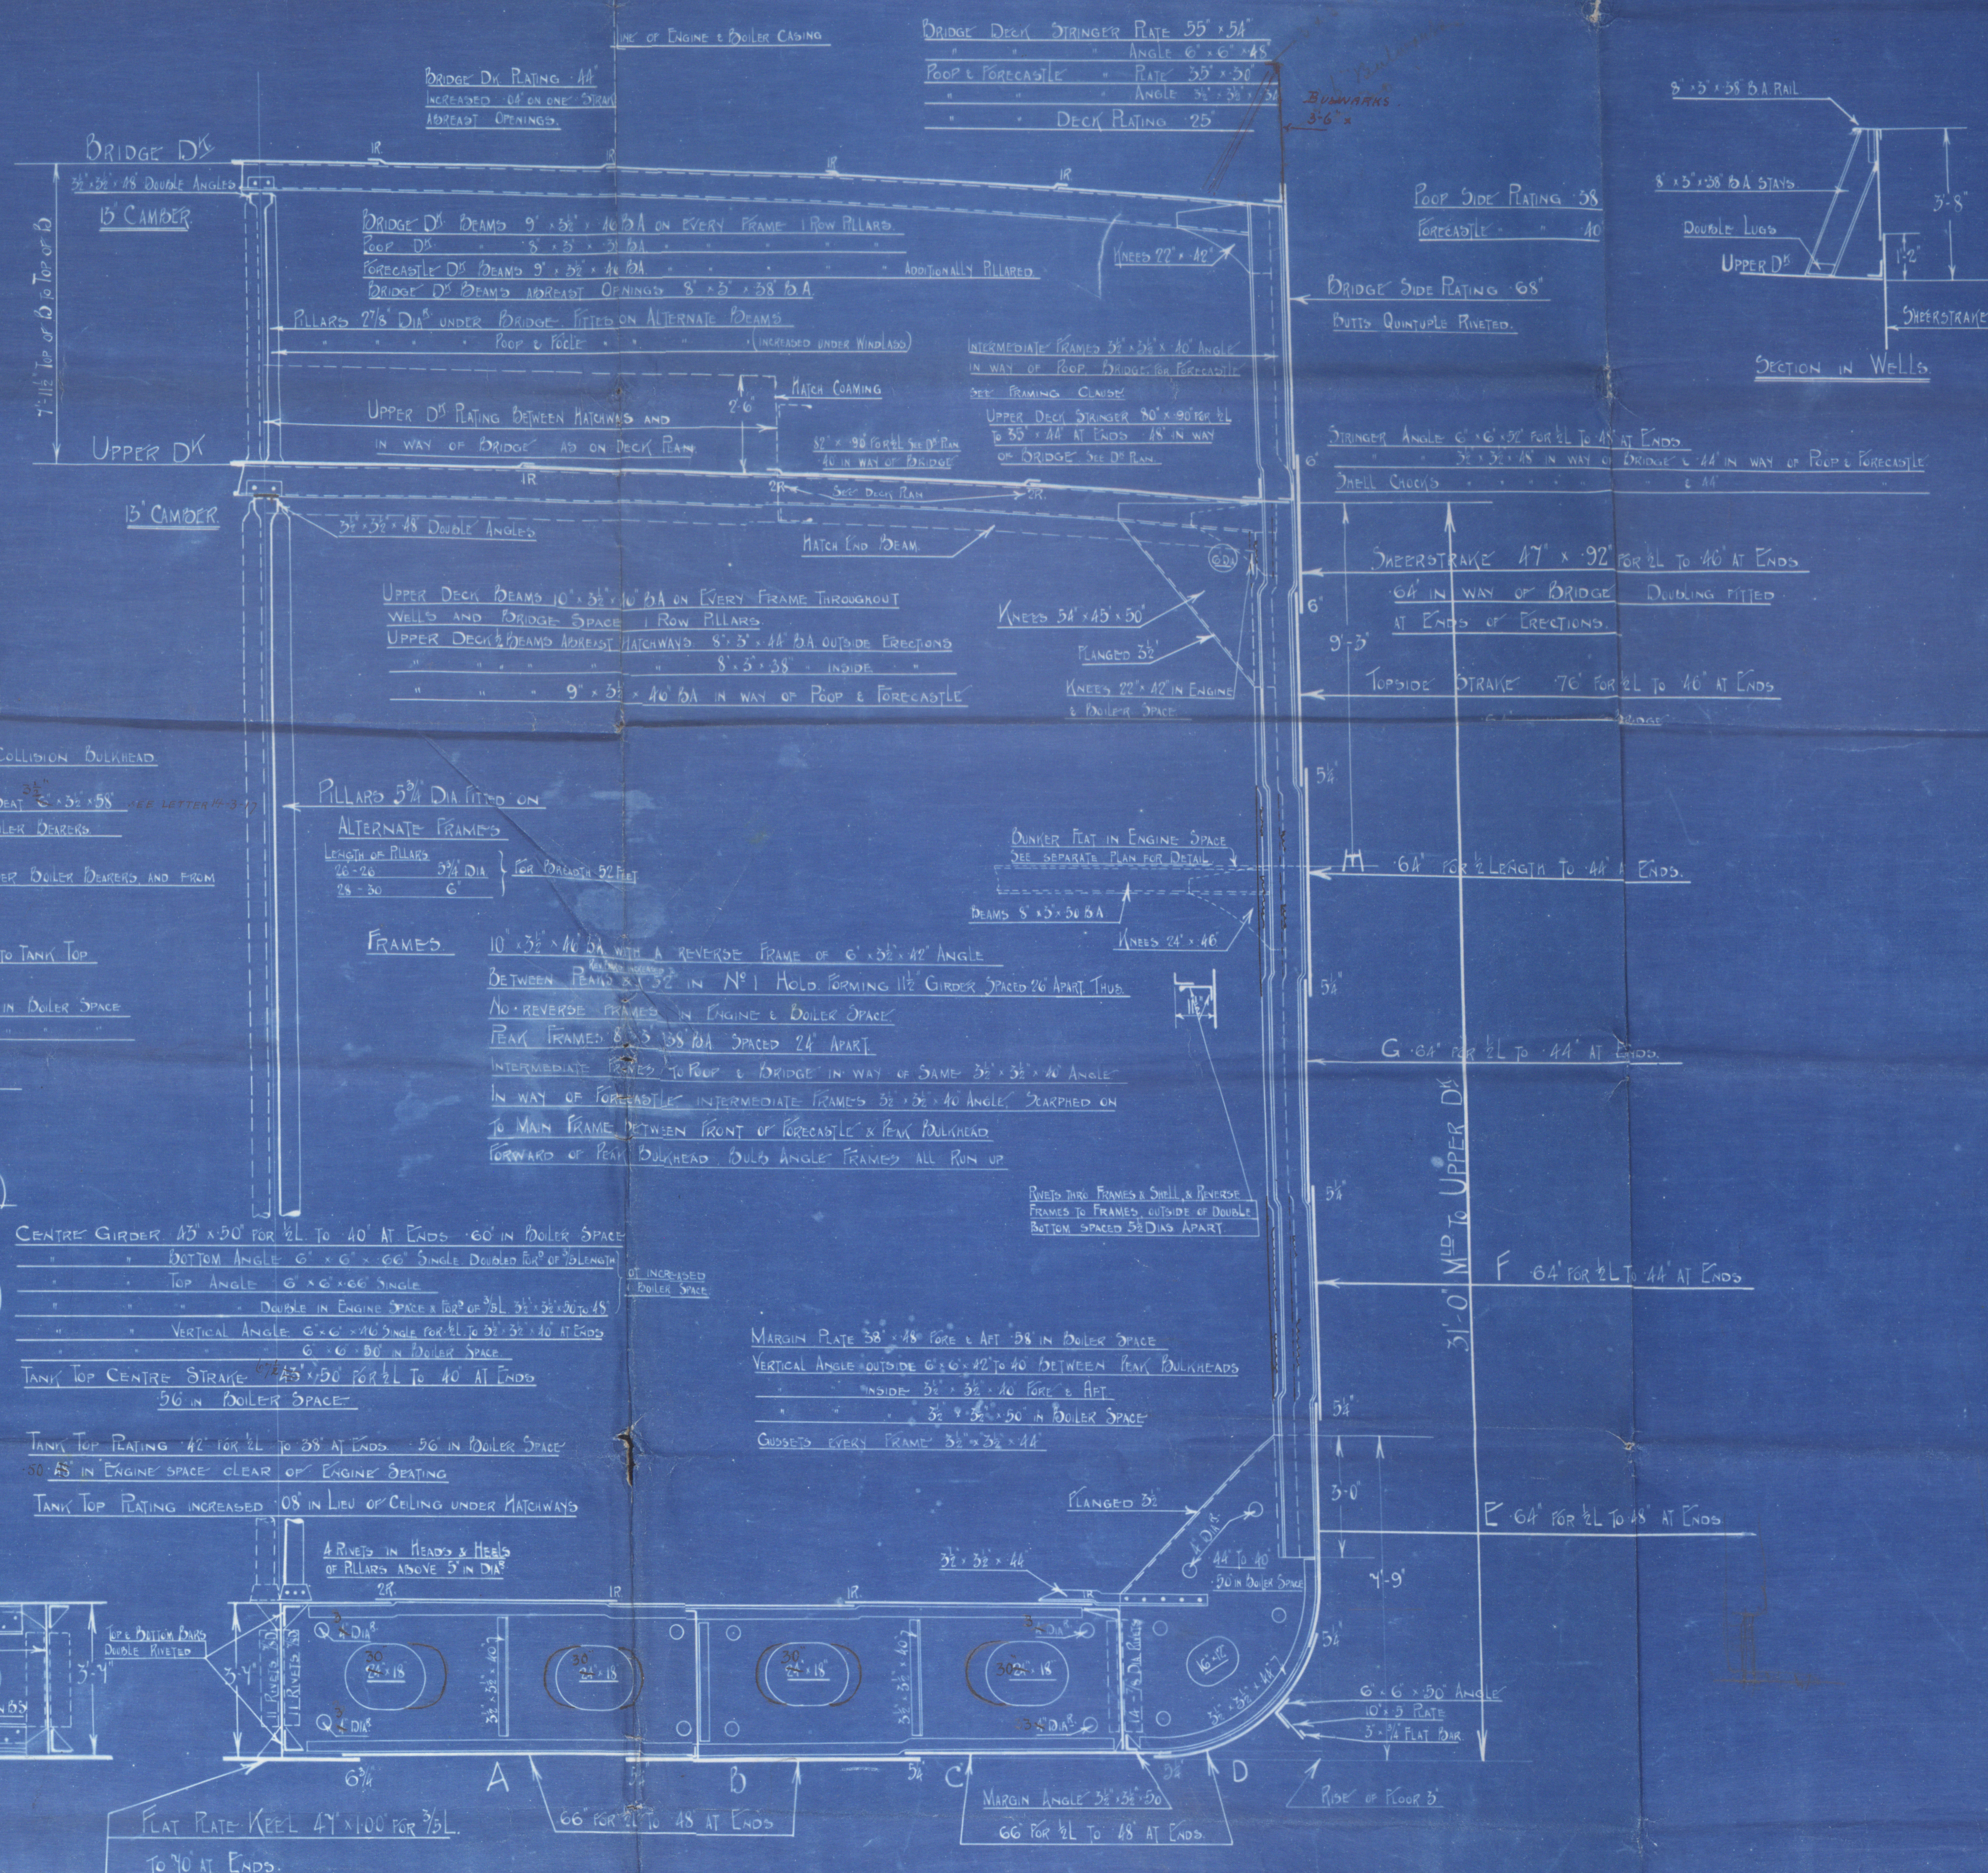

SECTION AT BRACKET FLOOR.

SOLID FLOORS EVERY 3RD FRAME.

NOTE: THREE STRAKES OF PLATING TO HAVE MIDSHIP THICKNESS CARRIED FORWARD TO COLLISION B¹

NOTE: BUTTS OF A & D STRAKES QUINTUPLE RIVETED WHERE BREADTH OF STRAKE EXCEEDS 8'

REMAINDER AS PER RULE

RETAIN

W435-0071



© 2019

Lloyd's Register
Foundation


Harland & Wolff, Ltd

Standard Ships "A"

N^{os} 520, 521 and 522.

Midship Section ✓

Official Plan
received Belfast. 7-2-17.

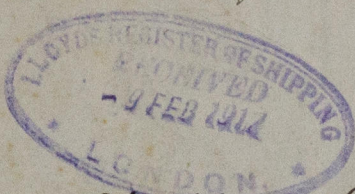

S/S "War Shamrock."
Bel. 7848.

S/S War Clover
Bel 7869.

S/S War Trefoil
Bel. 7870.



RETAIN



© 2019

Lloyd's Register
Foundation