










Superstructure bulkheads, trunks, deckhouses, casings, cargo and coaling hatchways, extent and thickness of sheathing on the freeboard deck, gangway, cargo and coaling ports, and any other openings, etc., which would affect the seaworthiness of the ship are to be shewn on the following sketches:—

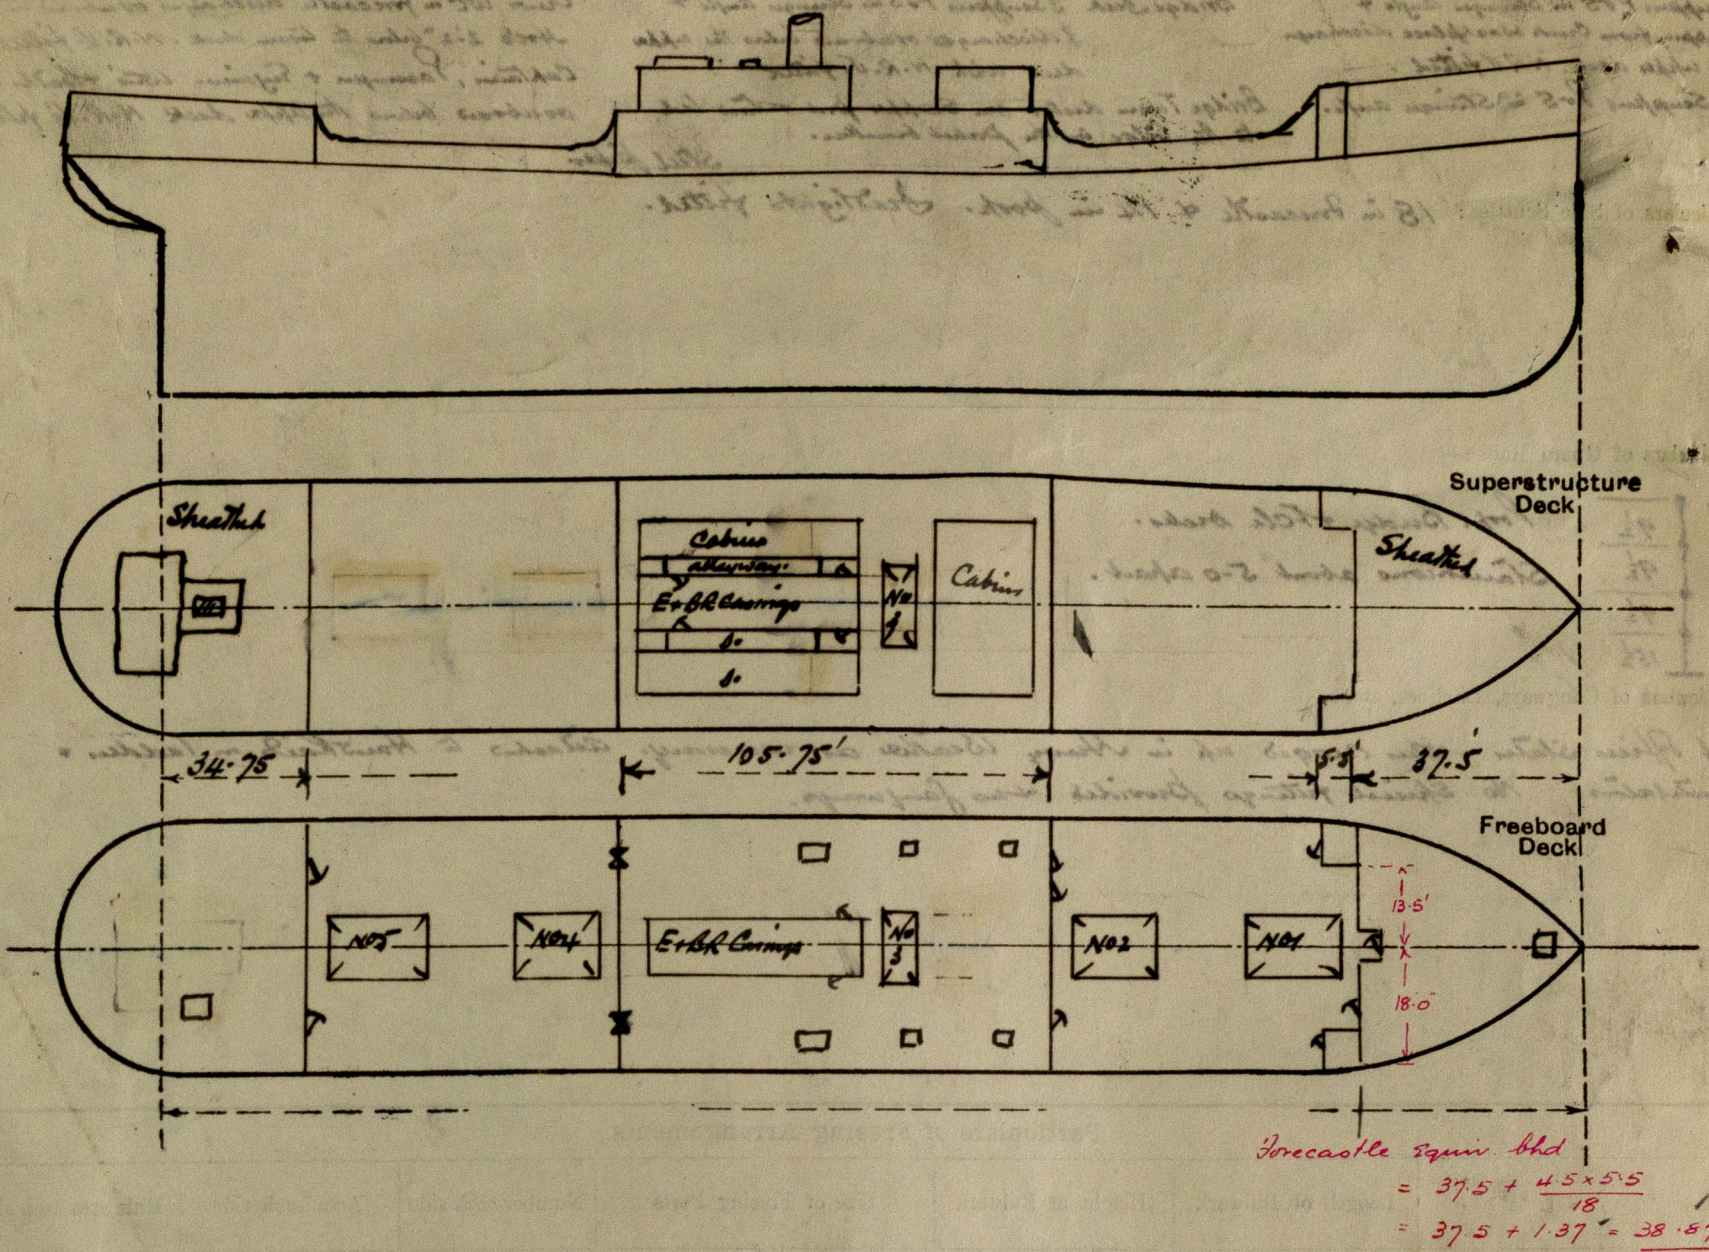

State any special features in the construction of the ship:—

The vessel examined in dry dock & afloat. No requirements for special survey carried out.  
 Owners letter giving particulars of displacement &c forwarded herewith.

Builder's name and yard number

Names of sister ships

Owners

Fee *£* 2700 -

Tax 14-40  
 Exp. 50

Received by me

4/6/32



© 2019

Lloyd's Register  
 Foundation