


HORIZONTAL FLUE TUBES.

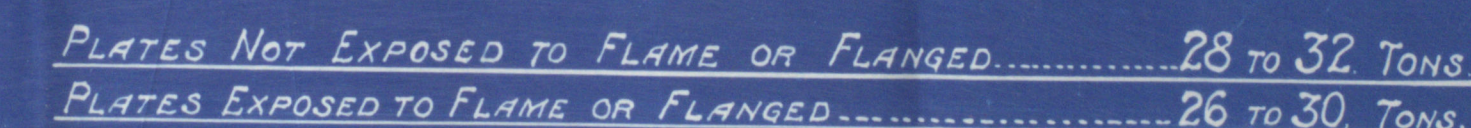

RETAIN



© 2019

Lloyd's Register
Foundation

COCHRAN & CO., ANNAN, LD.

Boiler No. 10423

Drawing No. 15696

WP ~ 100 lbs

^h King Egbert ^u

bel. rpt no 9905

GLASGOW REPORT No. 46905

RETAIN

W235-0290



© 2019

Lloyd's Register
Foundation