


25/11/24

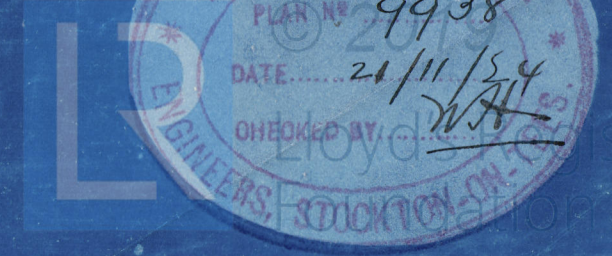

From **BLAIR & Co., Ltd.,**
STOCKTON-ON-TEES.

FOR ENCLOSURE TO

*Messrs Lloyd's
Registry of Shipping
Middleboro*

3 Main Boiler

Munn Blair & Co Ltd

No. 1964

for

Munn Roper & Co Ltd

S.S. No. 549

Working Press 180 lb

Duplicate of Builders

No. 1956 & 1957

except wrapper plates

3/5 Hollowpool

Indb Rpt

12356



© 2019

Lloyd's Register
Foundation

W436-0160