


24/11/24

DETAIL OF GUSSET TO UPPER DECK HATCHES IN BRIDGE (ALSO WELL HATCHES)  
SCALE 1/2" = 1'00"

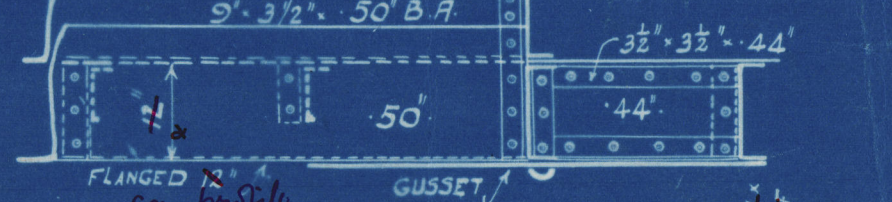



PROFILE AND DECK PLANS.

DIMENSIONS 300' 0" B.P. 55' 6" 28' 9" TO U. DECK  
TO CLASS 100A AT LLOYDS


SCALE 1/2" = 1'00"

MINIMUM SCANTLING REQUIRED


Woodwork, varnished & steering gear supported to Surveyors satisfaction

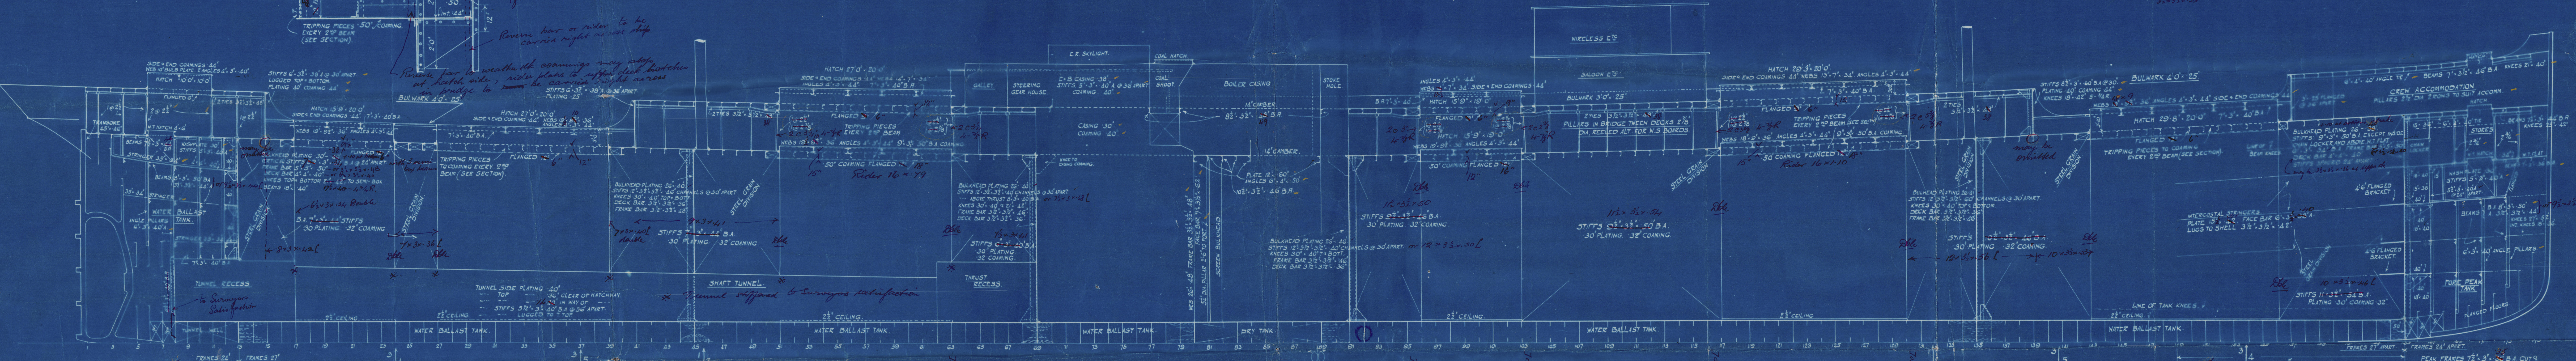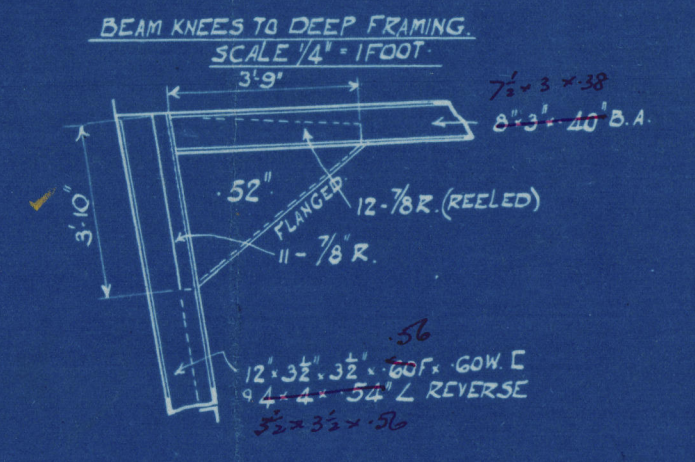

FOOP DECK  
BEAMS 7' 3" x 42" B.A.  

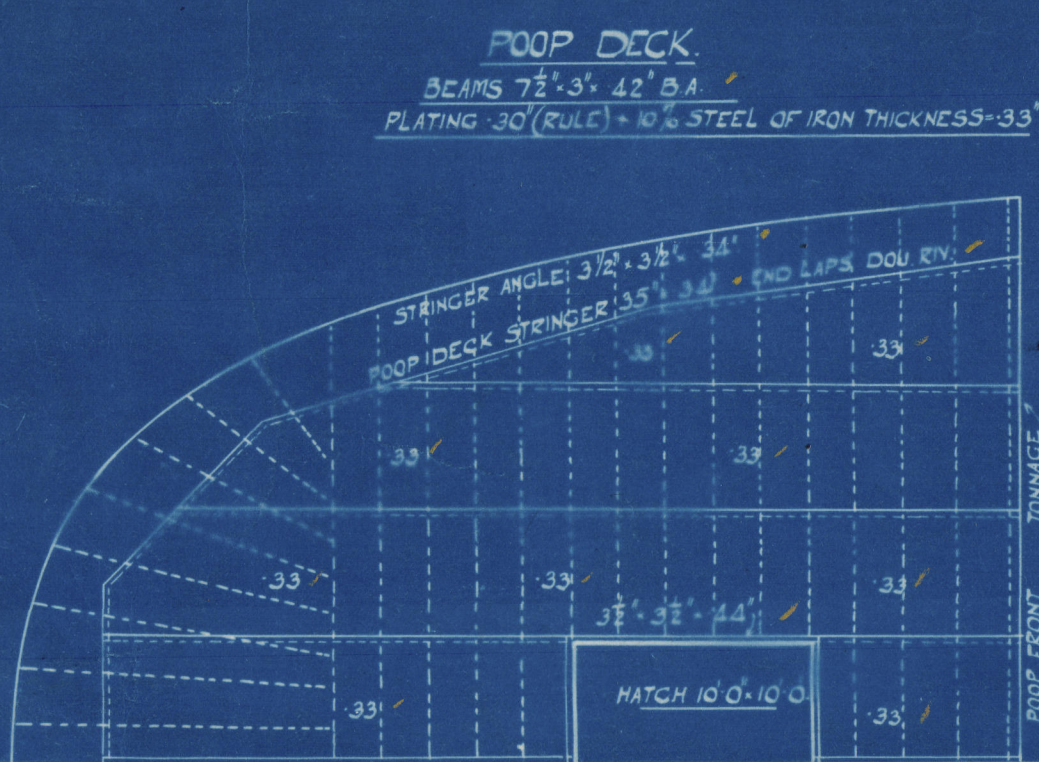


DETAIL OF GUSSET TO BRIDGE DECK HATCHES  
SCALE 1/2" = 1'00"

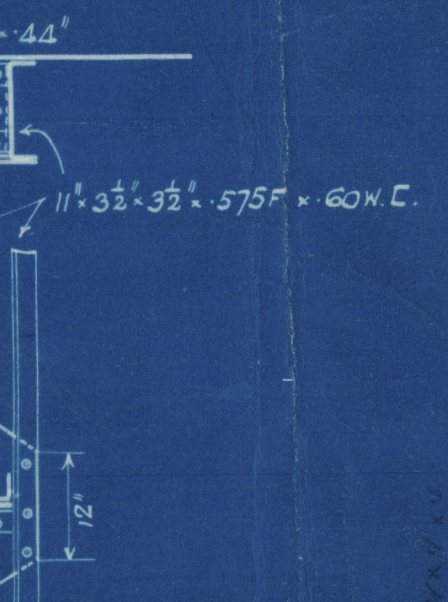

BRIDGE DECK

BEAMS (THROUGH) 6' 3" x 42" B.A. HALF BEAMS ALSO IN WAY OF CASING 7' 3" x 42" B.A. HATCH END BEAMS CHANNELS (IN PAIRS) 12' 3" x 31' 3" x 50' 1/2" C.W.C. (MARK V)

DECK STEEL OF IRON THICKNESS WHERE EXPOSED

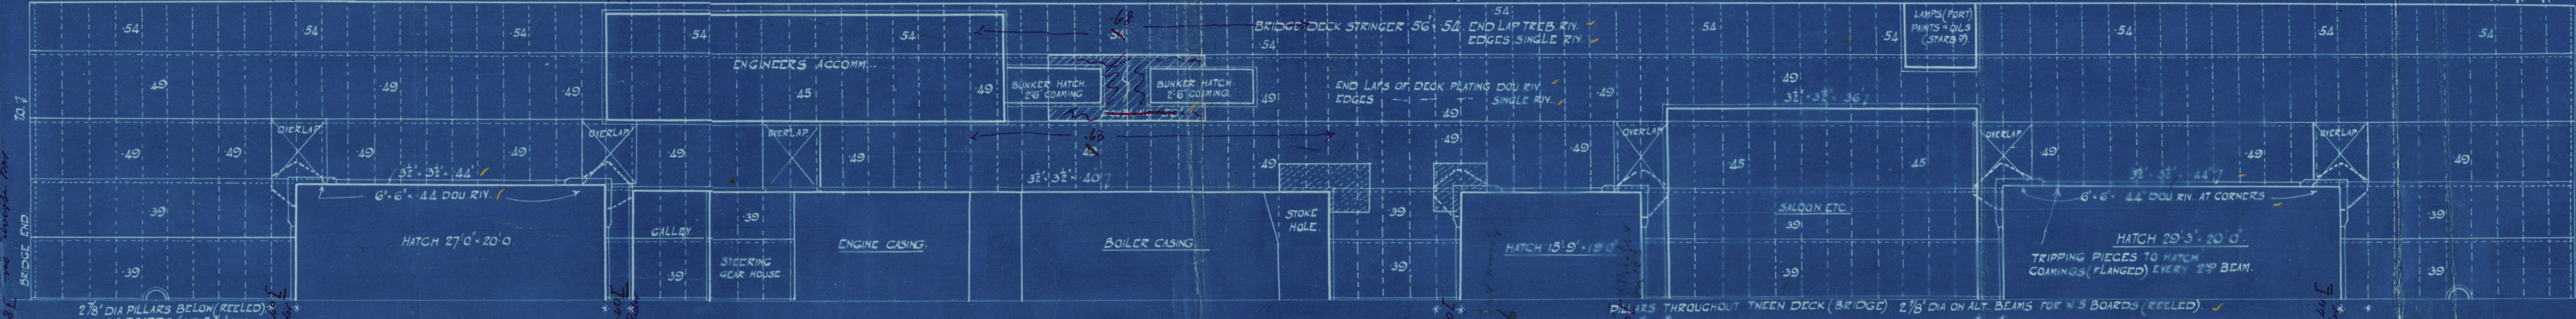

UPPER DECK

BEAMS UNDER BRIDGE 10' 3" x 42" B.A. BEAMS CLEAR OF BRIDGE IN WELLS 10' 3" x 42" B.A. HALF BEAMS IN WAY OF E & B CASING 7' 3" x 42" B.A. (ALSO IN WAY OF HATCHES)  
BEAMS AT HATCH ENDS CHANNELS (IN PAIRS) 12' 3" x 31' 3" x 50' 1/2" C.W.C. (MARK V)

DECK PLATING ABRAST HATCHES 86' TO 42' AT ENDS 36' UNDER BRIDGE 1/2" STEEL OF IRON THICKNESS WHERE EXPOSED

WITHIN LINE OF 42' TO 36'

36' UNDER BRIDGE

36' UNDER BRIDGE

THE ROPNER SHIPBUILDING & REPAIRING CO. (STOCKTON) LTD.  
STOCKTON-ON-TEES.  
Date November 15<sup>th</sup> 1924

No 549 S.S.





RETAIN



© 2019

Lloyd's Register  
Foundation




Insurance The ~~Porter~~ Ship 3d Rpt. 3rd 1

No 549

Profile & Deck plan ✓

S.S. Willowpool  
MDB. RPT. No. 12356

RETAIN

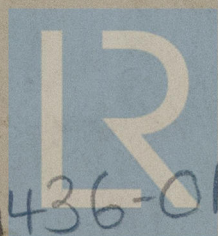

© 2019

Lloyd's Register  
Foundation

W436-0163