
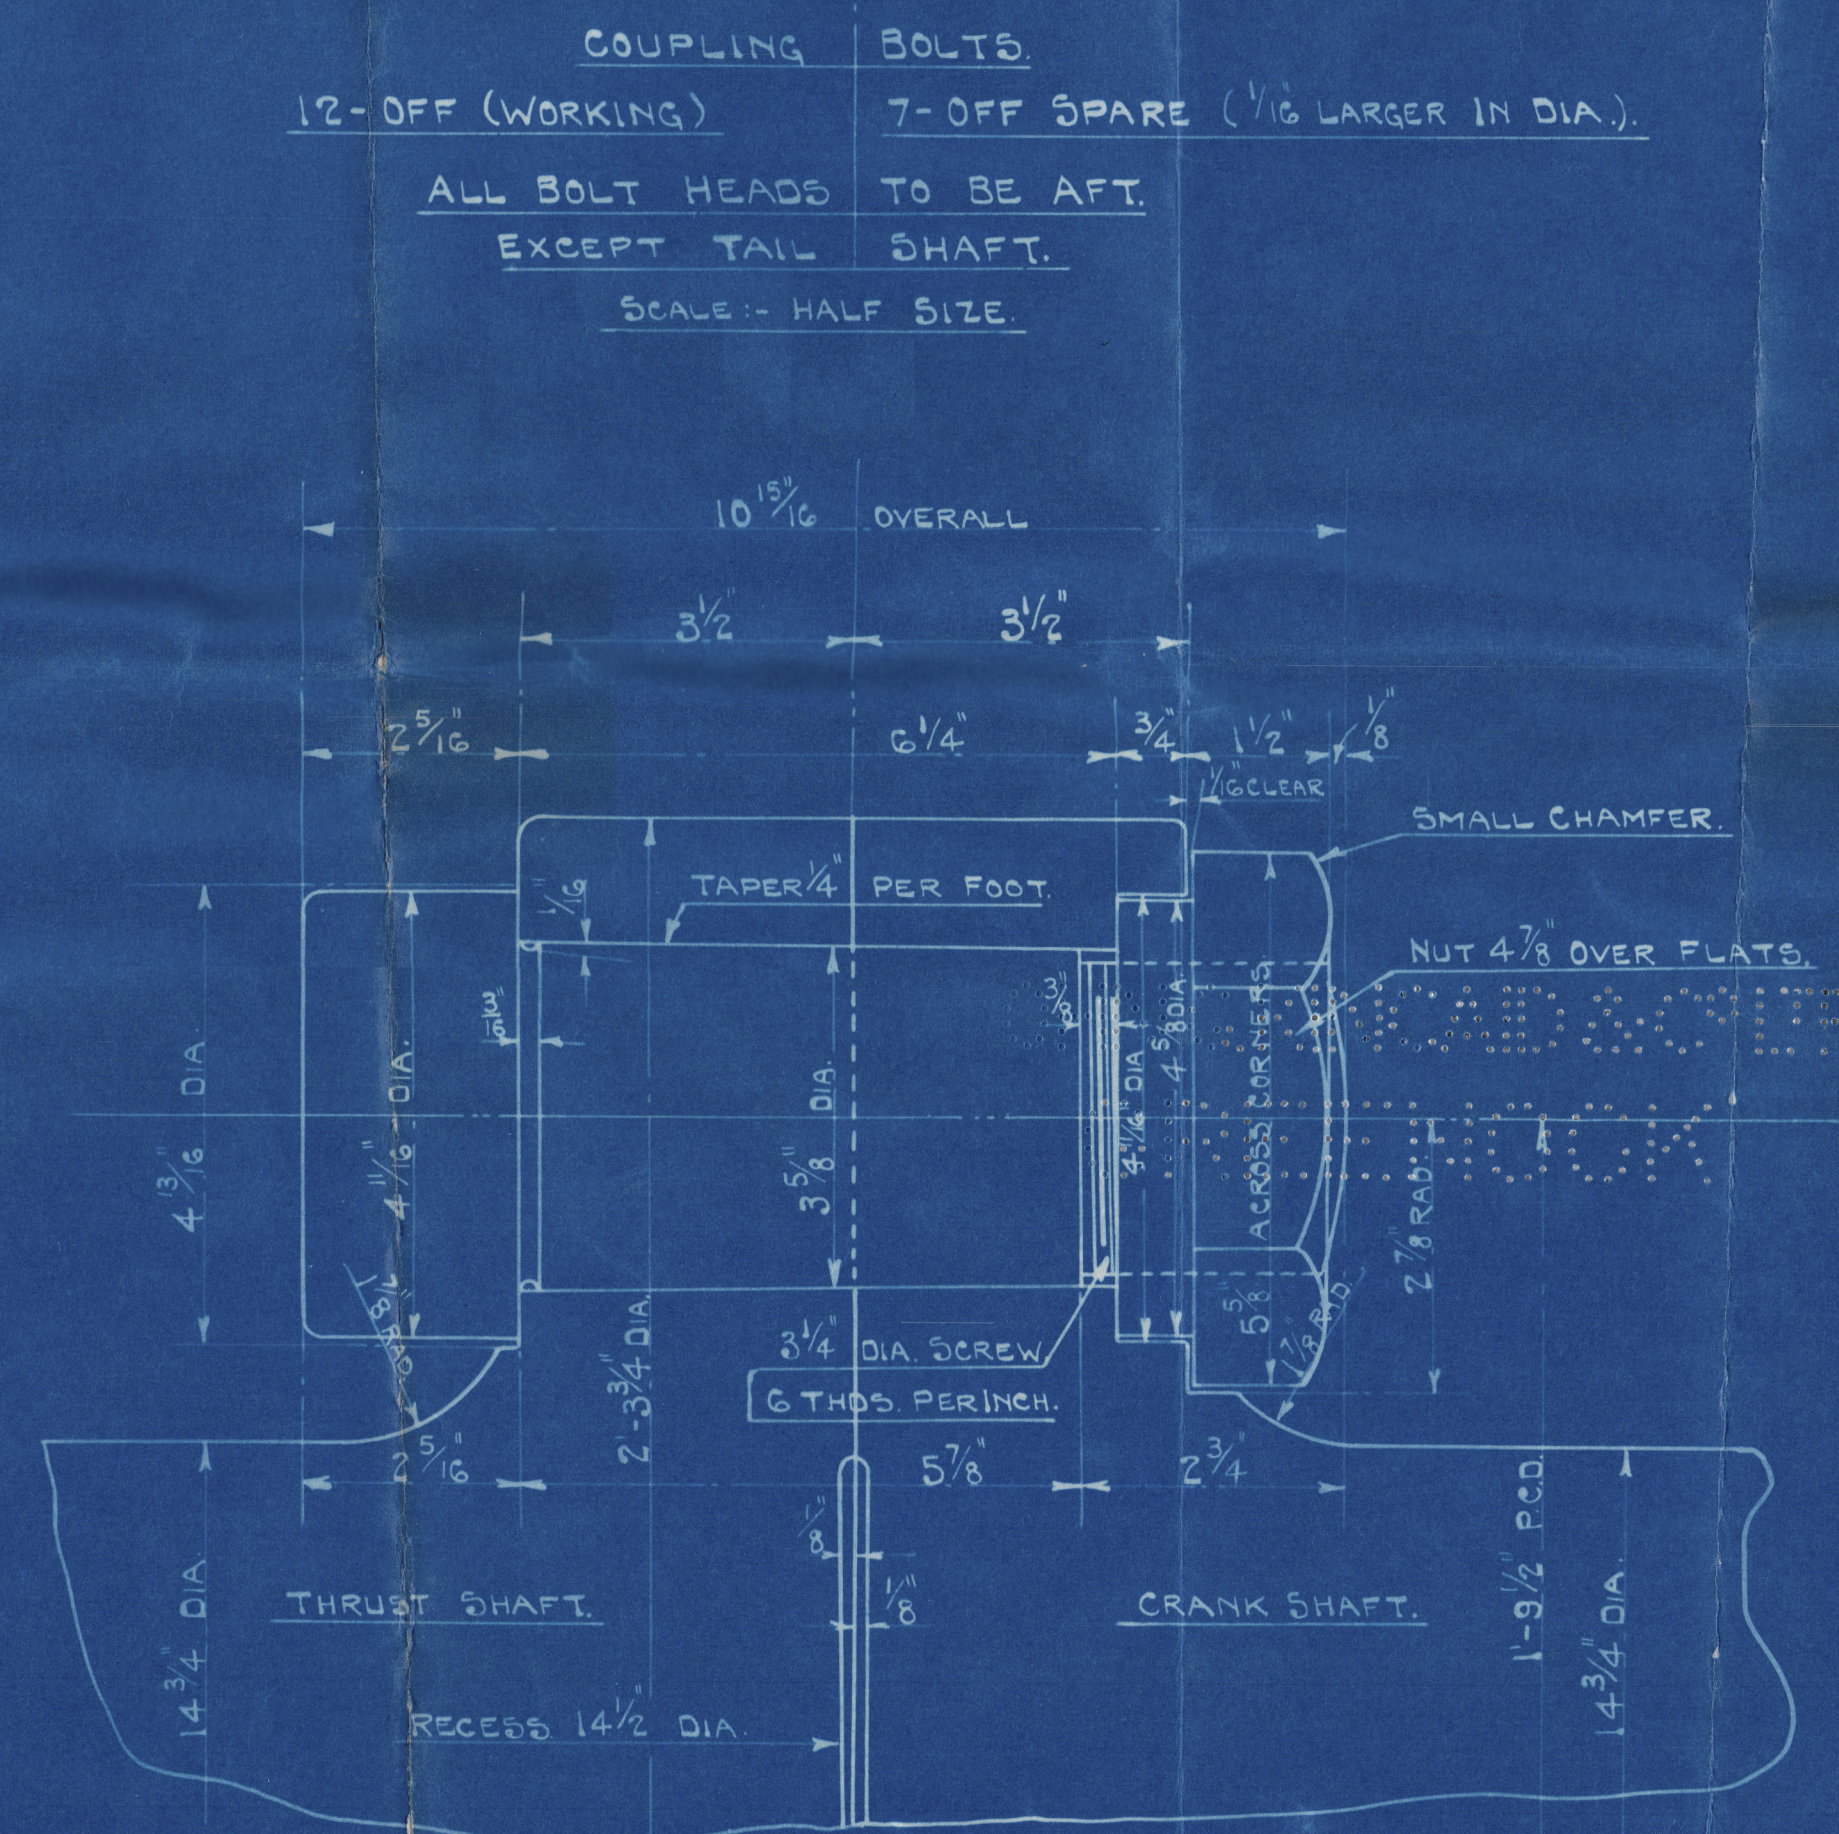
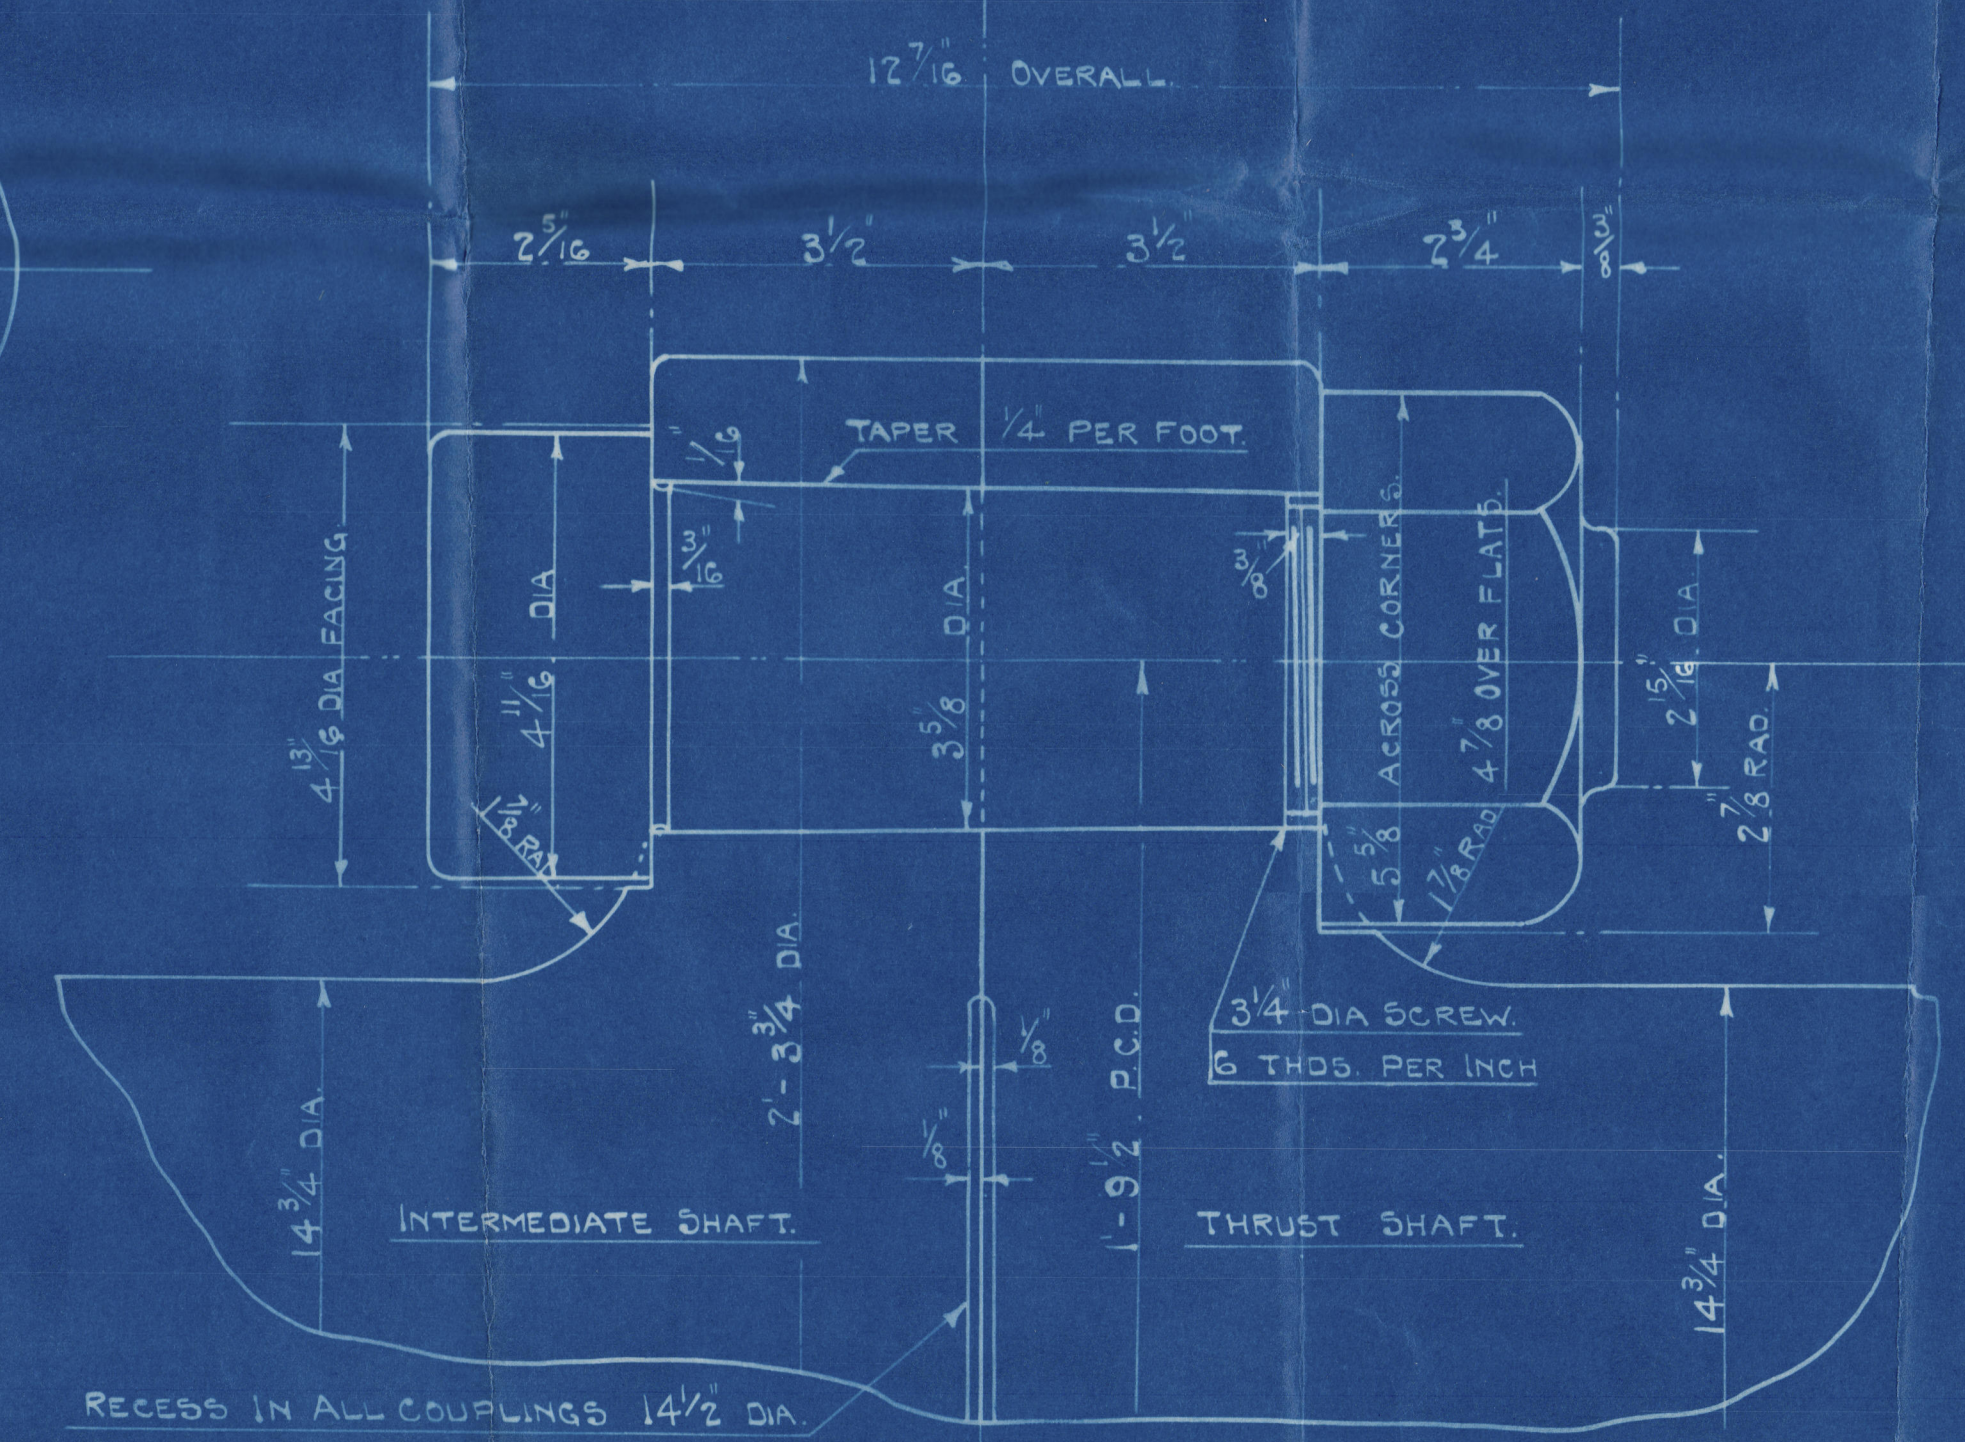
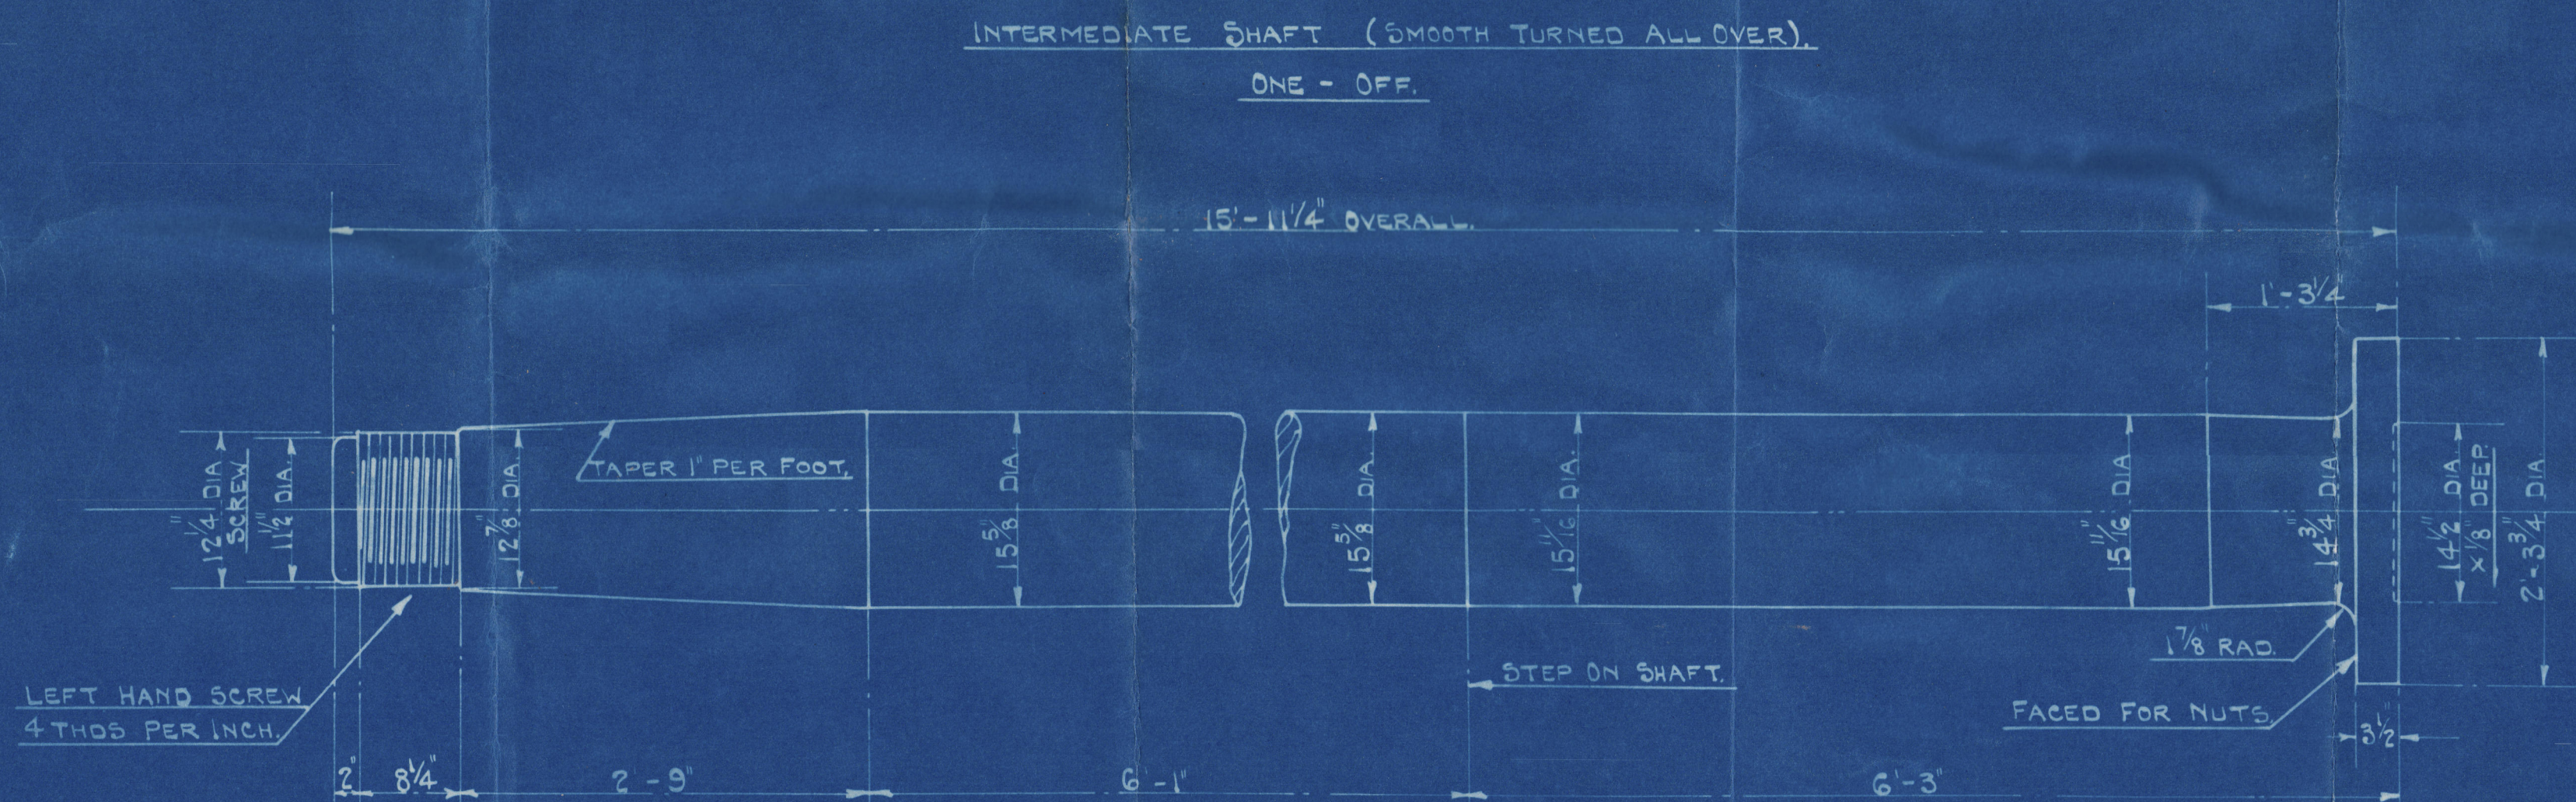
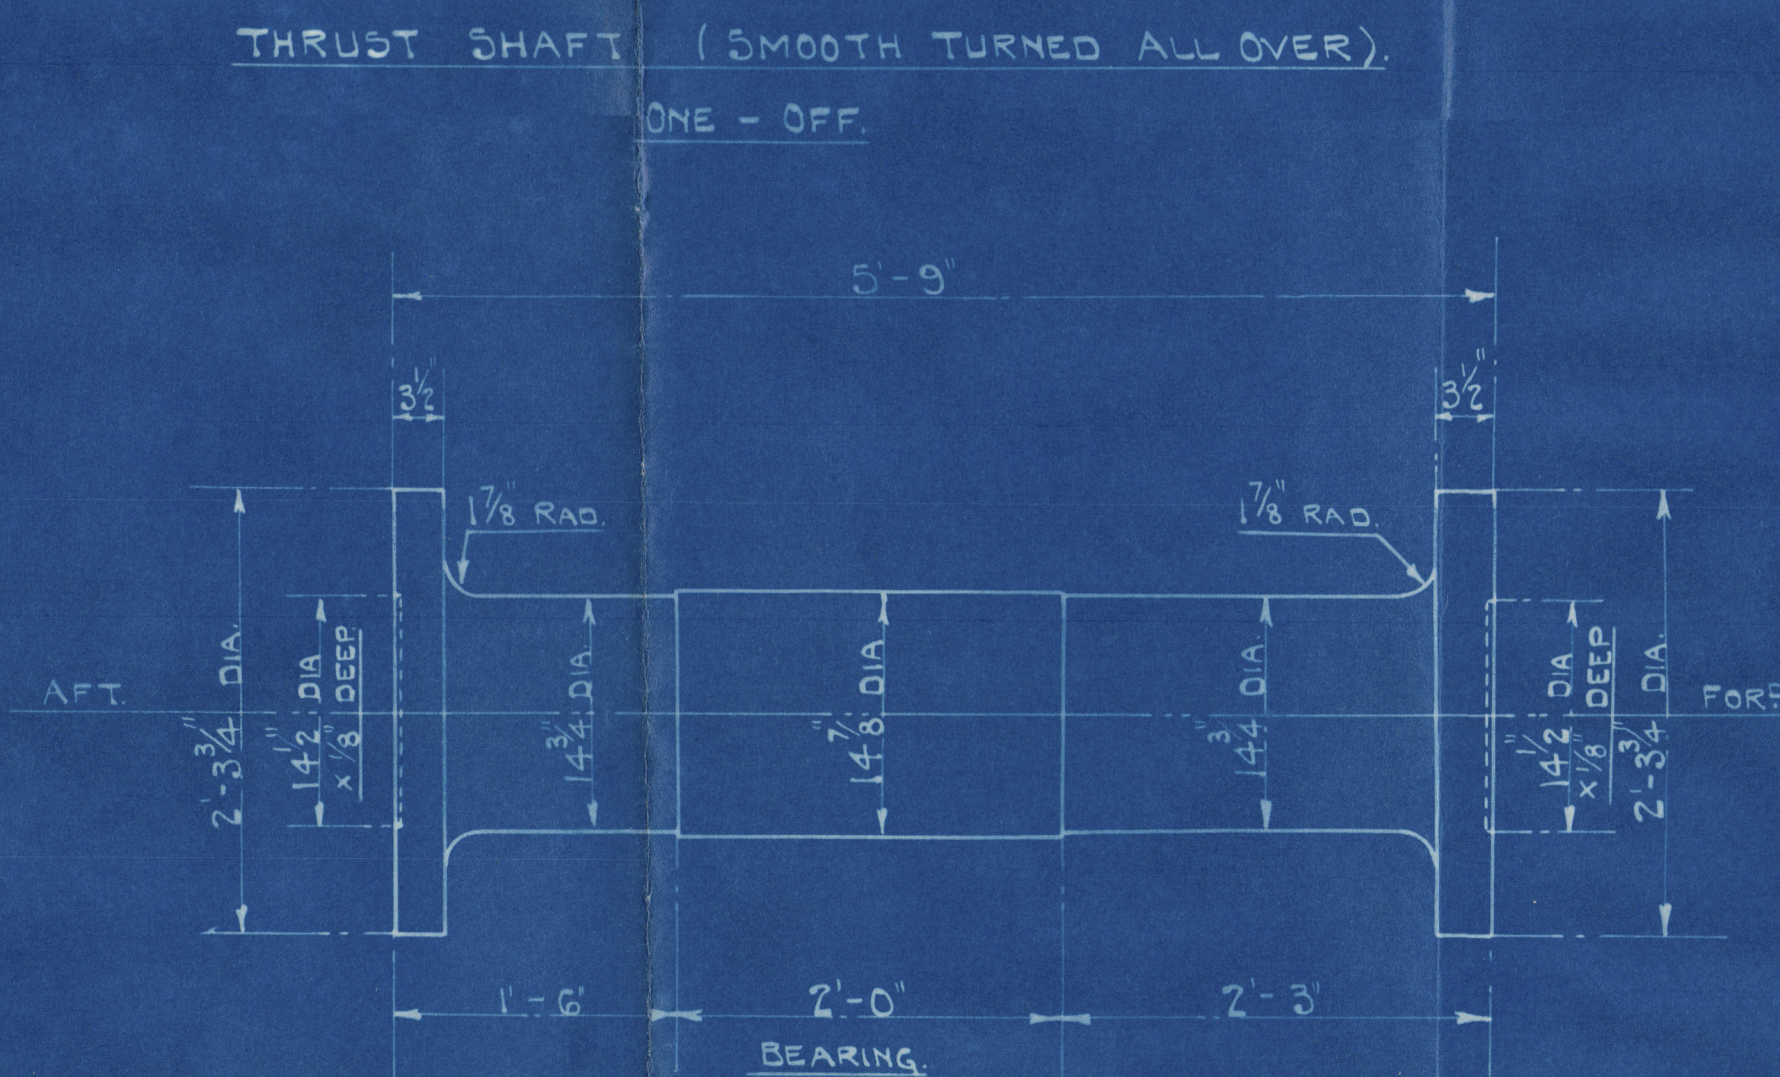
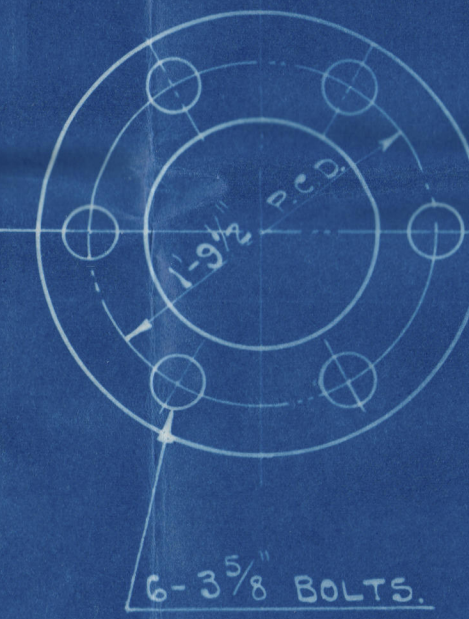


JOHN G. KINCAID & CO
LIMITED
ENGINEERS
GREENOCK.

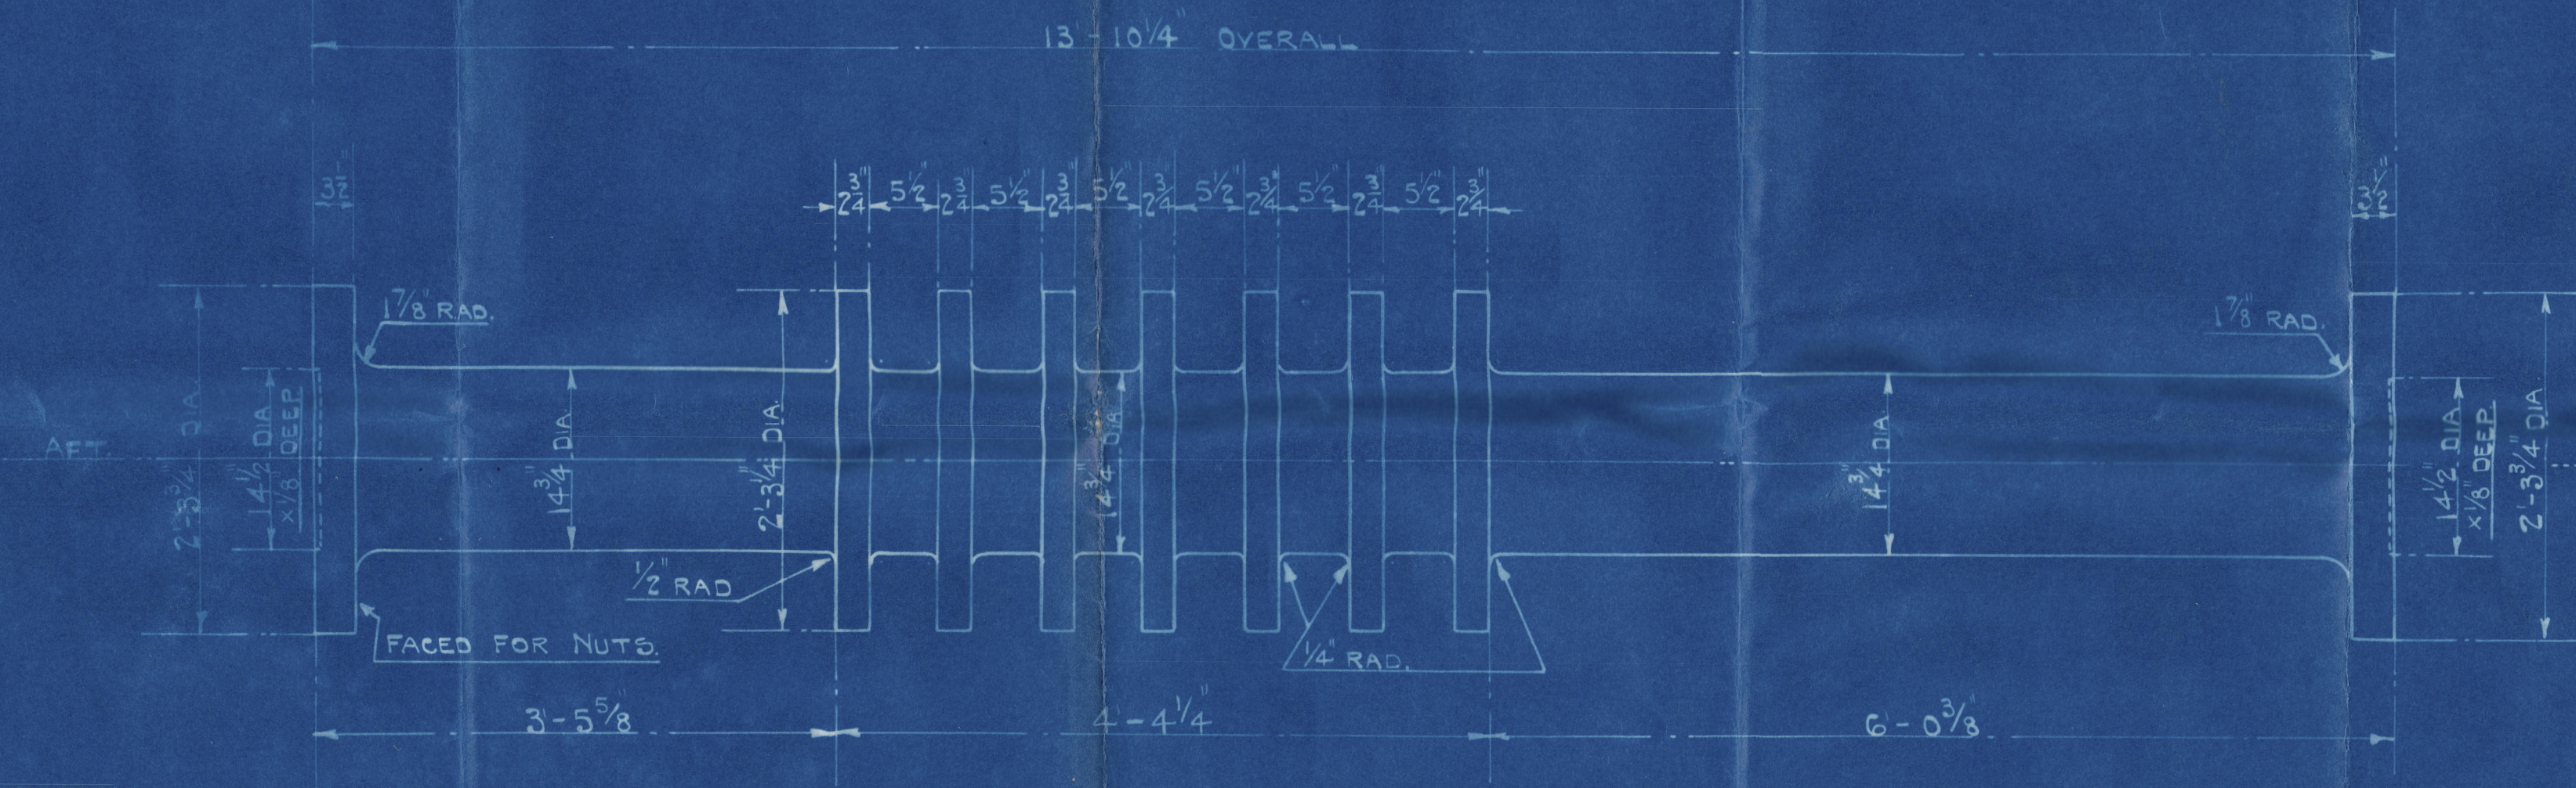

SURVEYS:- LLOYD'S & BRITISH CORPORATION
MATERIAL:- BRITISH MANUFACTURE.

SHAFTING.
ENC. N° 672.

SCALE:- 1" = 1 FT. 14TH MARCH, 1930.

inquire 25'-43 1/2"-7 1/4" 22000^{lb} 148"

*Rule Thrust-Crank 14" 28
Turned 13.6
Propeller 15.1*

14800 17/3/30

DRC. NO. 7351.

7351.
M.C.R.
14TH MARCH, 1930.

W436 0185

RETAIN



© 2019

Lloyd's Register
Foundation

Kincaid 642

Shaftey ✓

Greenock Dockyard ^{S.} 8420

P.D. "Neseda"
Lph. List Entry Report N° 19932.

JOHN G. KINCAID & Co. LTD.
(DRAWING OFFICE)
15 MAR 1930
ENGINEERS & BOILERMAKERS
GREENOCK.

ENCLOSURE
NO 815
"JUSTSO"

RETAIN



© 2019

Lloyd's Register

W436-0185 Foundation