

STRINGER PLATE 54" BREADTH FURTHER SEE PROFILE ✓
" " IN WAY OF LONG BRIDGE AND ✓
AT ENDS AS PER PROFILE
FOR DECK PLATING SEE PROFILE. ✓
DECK PLATING ALONG OPENINGS SEE PROFILE ✓
" " IN WAY OF LONG BRIDGE SEE PROFILE ✓
BEAMS ON EVERY FRAME 8' 9" x 3 1/2" x .30" ✓
HALF BEAMS ON EVERY FRAME 6' 8" x 3" x .54" ✓
BEAMS IN WAY OF LONG BRIDGE 8' 3" x .54" ✓
HALF BEAMS IN WAY OF LONG BRIDGE 7' 3" x .40" ✓
HATCH END BEAMS AND THROUGH BEAMS IN
ENGINE AND BOILER SPACE SEE PROFILE
RIVETS 1" 7/8" and 3/4"

STRINGER PLATE 32" BREADTH FURTHER SEE PROFILE
STRINGER ANGLE 3" x 3" x .32"
DECK PLATING .26"
BEAMS ONE EVERY FRAME 6" x 3" x .40"
RIVETS 3/4"
WOOD SHEETING 2 1/2" P. PINE

STRINGER PLATE 3" BREADTH FURTHER SEE PROFILE ✓
STRINGER ANGLE 3" x 3" x .32" ✓
DECK PLATING .26" ✓
BEAMS ON EVERY FRAME 18" x 3" x .44" ✓
ON UNDER WINDLASS 18" x 3" x .44" ✓
RIVETS 3/4" ✓
WOOD SHEETING 2 1/2" P. PINE. ✓

STRINGER PLATE 48" BREADTH FURTHER SEE PROFILE
FOR DECK PLATING SEE PROFILE ✓
BEAMS ON EVERY FRAME 5'8" X 3" X .44" ✓
HALF BEAMS ON EVERY FRAME 5'7" X 3" X .40" ✓
HATCH END BEAMS SEE PROFILE ✓
RIVETS 7/8" AND 3/4" ✓

55. NO. 483. SCALE $\frac{1}{2}''=1'$

LLOYDS CLASS 100A.1.

LENGTH BETWEEN LLOYDS PERP.	33' 2"
BREADTH MOULDED	48'-6"
DEPTH	24'-6"
LENGTH OF POOP	30'-1 1/2"
" " BRIDGE	211'-7"
" " FORECASTLE	24'-2 1/2"
HEIGHT OF POOP	7'-6"
" " BRIDGE	"
" " FORECASTLE	"

B/D = 7/3 L X (B+D) = 24.736 ✓
d = 21'-2 1/2 D TO MAINDECK = 13.54 ✓
1/2 " BRIDGEDECK = 10.38 ✓

BRIDGE 211.6 X 7.5 X 7.5 = 1190.25 ✓
POOP 30.2 X 7.5 X 7.5 = 169.88 ✓
FORECASTLE 24.2 X 7.5 X 7.5 = 135.56 ✓
CABIN 34.75 ✓
SALOON 20.50 X 7.5 X 7.5 = 228.12 ✓
CASING 20.50 ✓

PLATING NUMBER 24236.00 ✓
EQUIPMENT NUMBER 26012.89 ✓

Technical drawing of a ship's hull section, showing internal structure and dimensions. The drawing includes a cross-section of the hull with various components labeled and dimensioned.

Dimensions and Labels:

- 4" x 4" x 48
- 6" x 6" x 44
- 4 1/2"
- CORNER KNEE 4' x 3' x 50'
- KNEE 4 1/2' x 3 1/2' x 54"
- FLANGE 3"

Material List:

1 STREAM ANCHOR	42	"	EXC
1 KEDGE	5 1/4	"	"
2 STUD CHAIN CABLE	270	"	FATHO
1 STEEL WIRE	90	"	"
1 " "	120	"	"
2 " "	90	"	"
2 HAWSERS	90	"	"

Other Labels:

- ATCH COVERS LAID LONGITUDINAL

COAMING .38" PLATING .38" ✓
STIFFENERS 5 1/2" x 3 1/2" x .34" 30" APART
BRACKETS AT TOP AND HEEL ✓
RIVETS 3/4" ✓

COAMING .41" PLATING .38" ✓
STIFFENERS 58" x 3 1/2" x .64" 30' APART ✓
BRACKETS AT TOP AND HEEL ✓
RIVETS 3/4" ✓

COAMING. 42" PLATING. 39" ✓
STIFFENERS 5 6 1/2" x 3 1/2" x .40" ✓
BRACKETS AT TOP AND HEE- ✓
RIVETS 3/4" ✓

PLATING .24" ✓
STIFFENERS L $3\frac{1}{2}$ " x $2\frac{1}{2}$ " x .28" ✓
BRACKETS AT TOP AND HEEL ✓
RIVETS $\frac{3}{4}$ " ✓

CENTRE GIRDER 40"x.48" 1/4 LAMIDSHIPS TO .38" AT ENDS BS.58" ✓
INTERCOSTALS .36" " " " 34" " " 46" ✓
MARGIN PLATE INCR. TO 36"x.42" IN BS.52 ✓
FLOOR PL. ON EVERY FR. AND EVERY 3RD FR. AS PER PROFILE ✓
" " AND BRACKETS 36" 1/4 LAMIDSHIPS TO 34" AT ENDS BS.46" ✓
MIDDLE LINE STRAKE INCR TO 48"x.46" TO .38" AT ENDS BS.54" ✓
TANK TOP PLATING .38" 1/4 LAMIDSHIPS .34" " " .54 ER. ✓
CENTRECORDER BUTTS LAP TREBLE 7/8 RIVETS ✓
RIVETS IN TANK TOP 3/4" IN BOILER SPACE 7/8 ✓
" " FLOORS AND BRACKETS 3/4" AND 7/8 ✓
CEILING 1" THROUGHOUT. *See H9 Para 809*

FRAME SPACE $24\frac{1}{2}$ " IN PEAKS $24\frac{1}{2}$ " ✓
FRAMES $5'10" \times 3\frac{3}{4}" \times 54'$ ✓
" IN FORE PEAK $5'6\frac{1}{2}" \times 3\frac{3}{4}" \times 40'$ ✓
" " AFTER " $5'6\frac{1}{2}" \times 3\frac{3}{4}" \times 40'$ ✓
" " ENGINE AND BOILER ROOM INCR TO $5'10\frac{1}{2}" \times 3\frac{3}{4}" \times 56'$ ✓
IN LIEU OF WEB FRAMES

DOUBLE RIVETED 1/2 L SINGLE AT ENDS

" DOUBLE " AT ENDS ✓

SINGLE FROM PR. 59 TO PR 132 ✓

8 RIVETS $\frac{3}{4}$ " \times 3" \times 14" IN 62, 50

UPPERDECK BEAMS	32 x 28 x 50
" HALF BEAMS	" x " x "
" IN BRIDGE	30 x 24 x 40
" BEAMS	" x " x "
" HATCHEND BEAMS IN WELLS	45 x 36 x 54
" UNDER BRIDGE	" x " x "
" THROUGH BEAMS IN E. AND B. ROOM	" x " x "
BRIDGEDECK BEAMS	28 x 24 x 40
" HALF BEAMS	" x " x "
" HATCHEND BEAMS	45 x 39 x "
" THROUGH BEAMS IN E AND B. ROOM	32 x 28 x 50
POOPDECK BEAMS	10 x 16 x 40
" POORCASTLE DECK BEAMS	24 x 19 x 40
" UNDER WINDLASS	30 x 24 x 40
PANTING BEAMS IN FORE PEAK	26 x 40
" AFTER "	" x 54
" HOLD	28 x 54

FROM FRAME 132 TO COLL BULKHEAD




100

100

INTERCOSTAL UNDER ENGINE

SCHEEPSWERT VOORHEEN JAN SMIT C₂

ALBLASSERDAM.

②


W437-0083

ⁿ
S^h Christiansborg

Rott 12138

M S

Midships Section

RETAIN

RETAIN




© 2019

Lloyd's Register
Foundation

Guider 3058

Dr. S

483

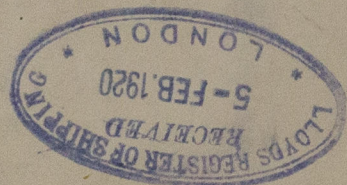

B. Smith



© 2019

Lloyd's Register
Foundation

W437-0083

RETAIN

RETAIN



© 2019

Lloyd's Register
Foundation