

9/12/26




TO PASS LLOYD'S SURVEY FOR 180 LBS WORK PRESS.  
& TESTED IN THE PRESENCE OF LLOYD'S OWNERS SURVEYOR.  
TO BE FITTED TO MESSRS SMITH'S DOCK CO. 33, N. 818, B. 19.

TOTAL HEATING SURFACE 4554.86 FT.  
GRATE (5-G BAR) 120.00

STEEL MATERIAL  
TENSILE OF SHELL & GIRDER PLATES 28-32 TON  
" FURNACE & FLANGED " 26-30 "  
" MAIN STAYS 28-32 "  
" SCREW & RIVET BARS, 26-30 "  
TUBES LAP WELDED IRON.

2 OFF  
SCALE (IN)=1 FOOT.

Should be 3 1/2"  
and 2 3/4"  
See Section 14  
Clause 8.

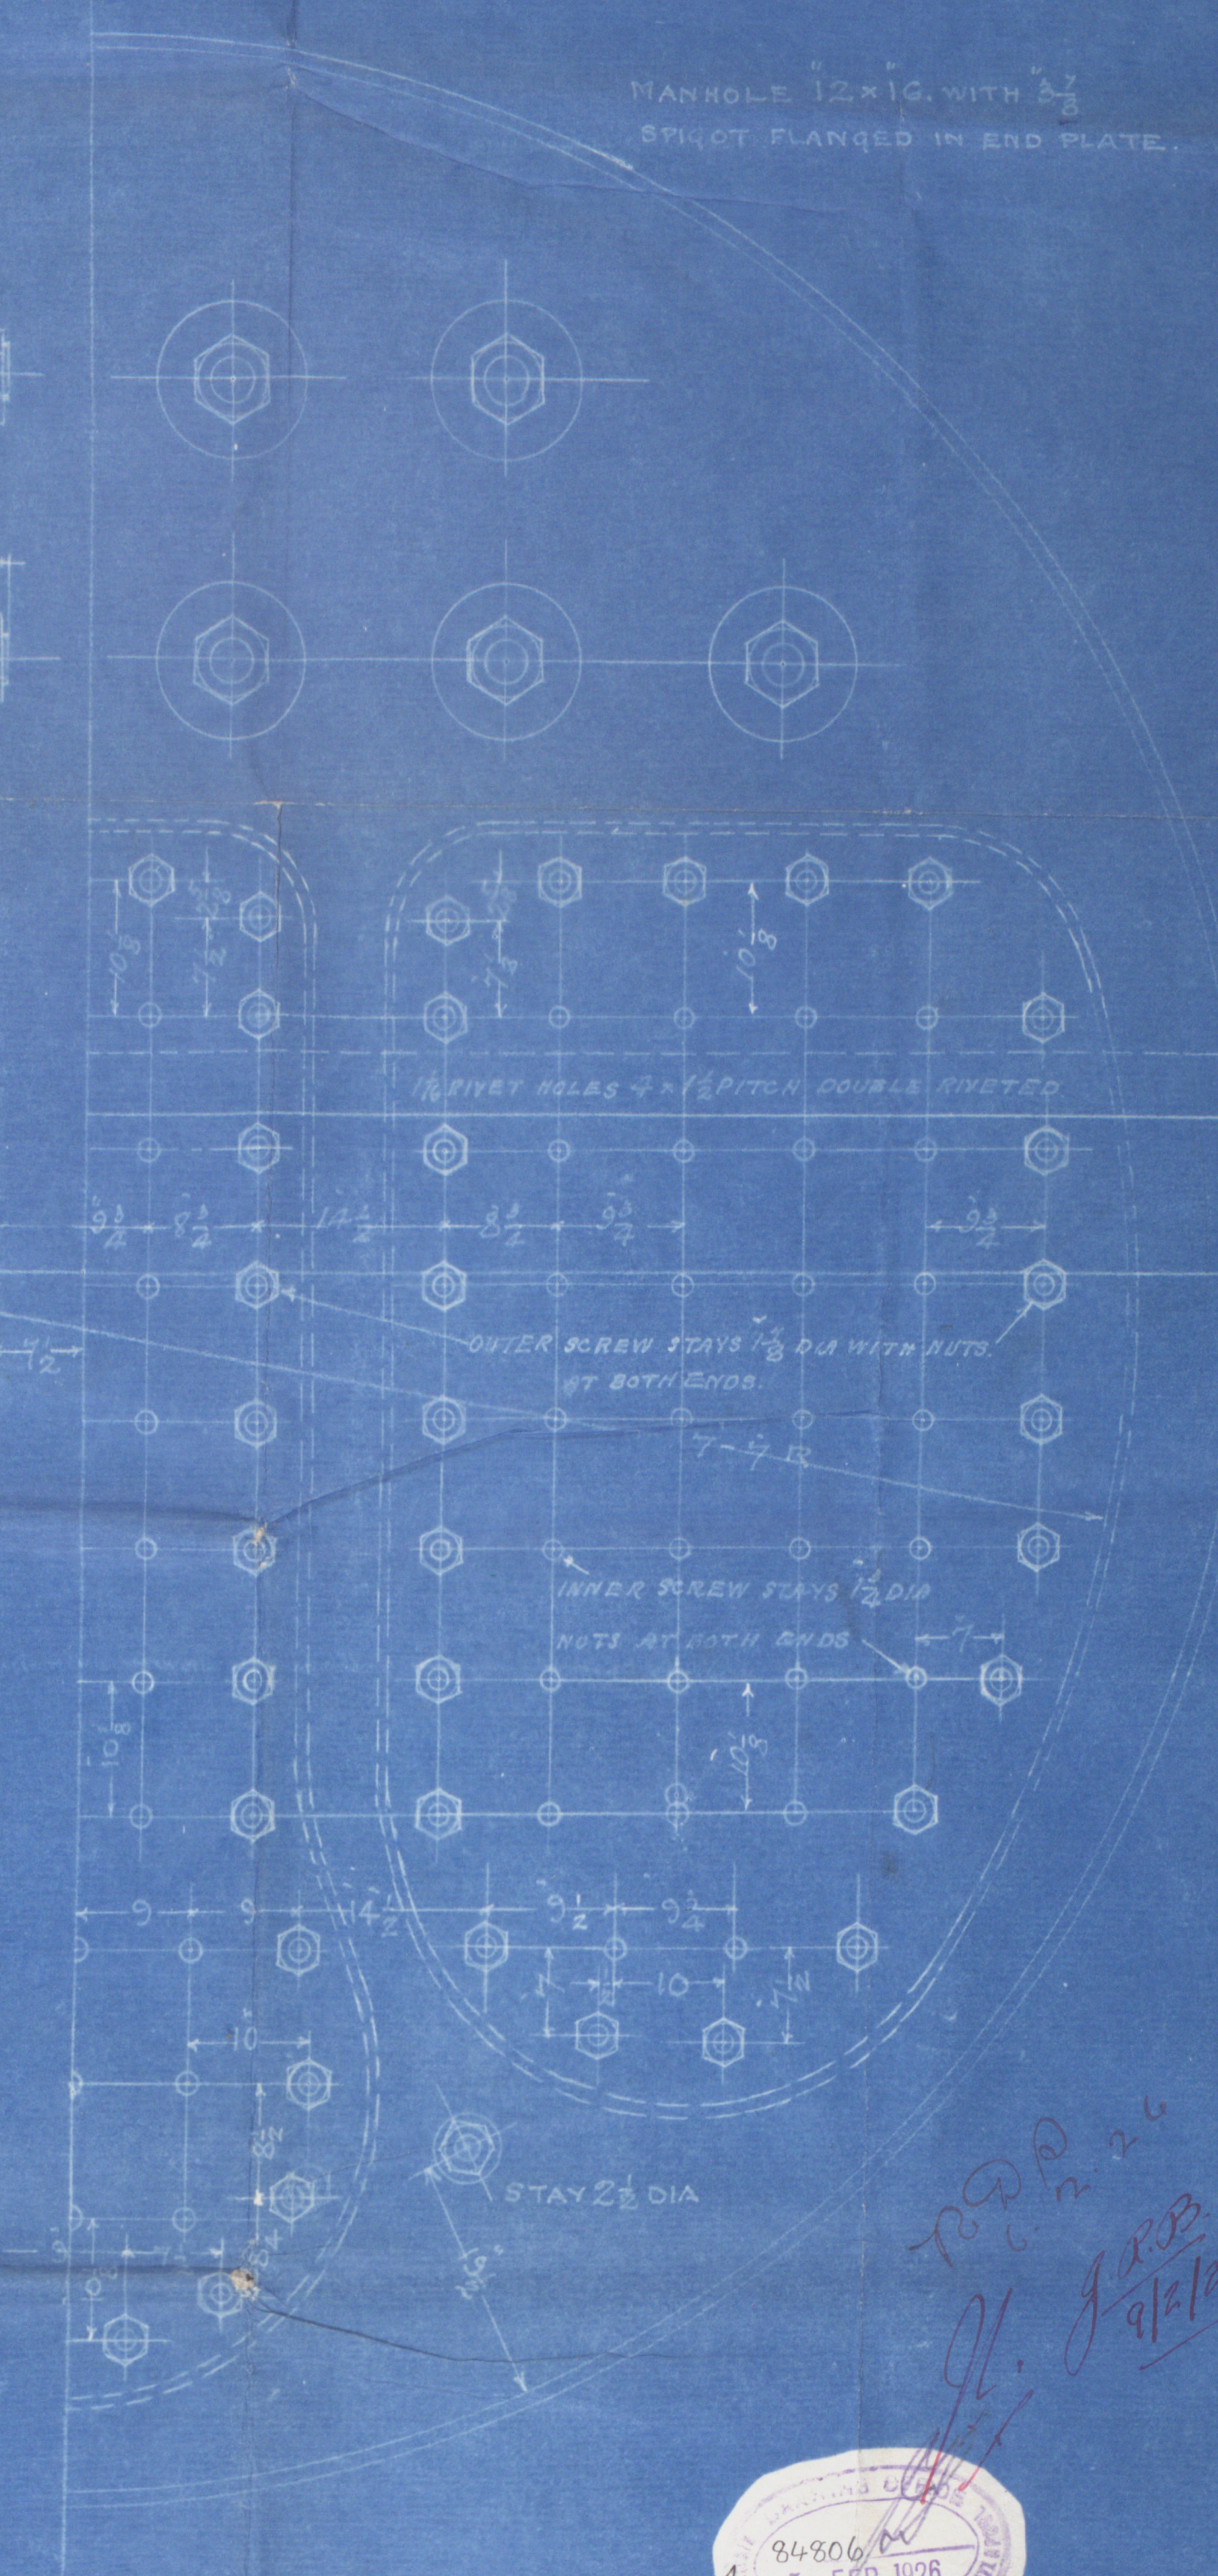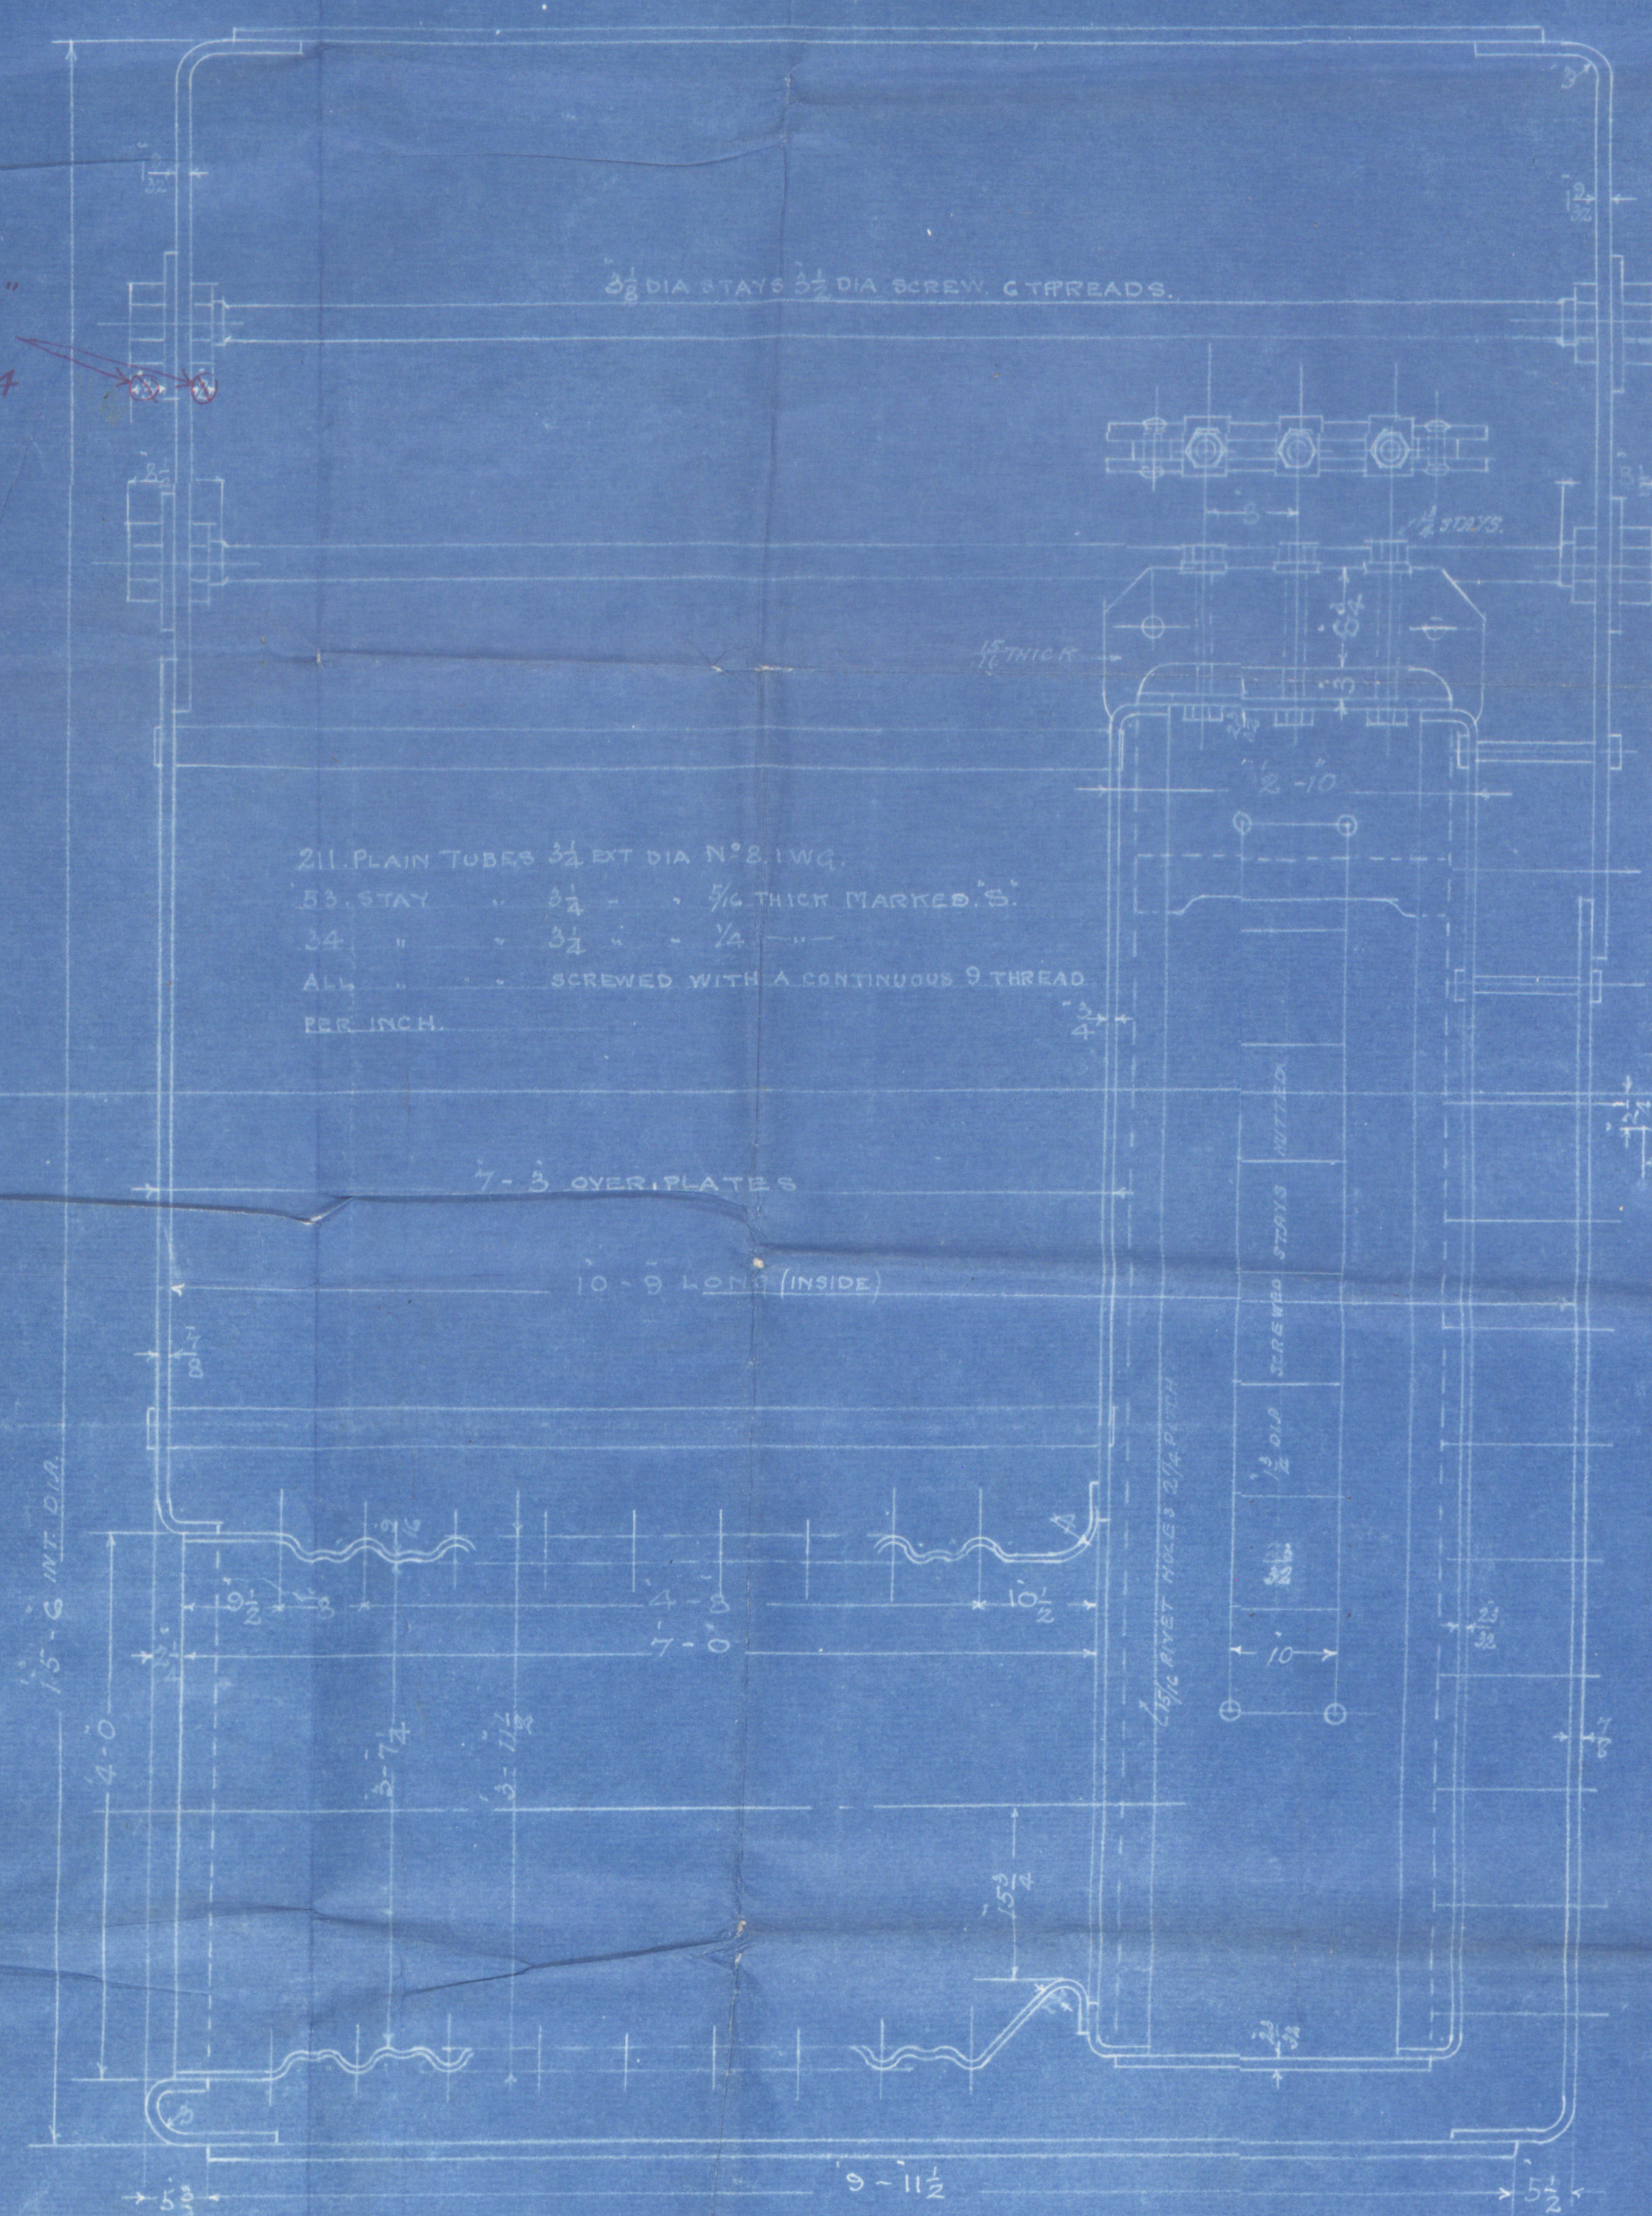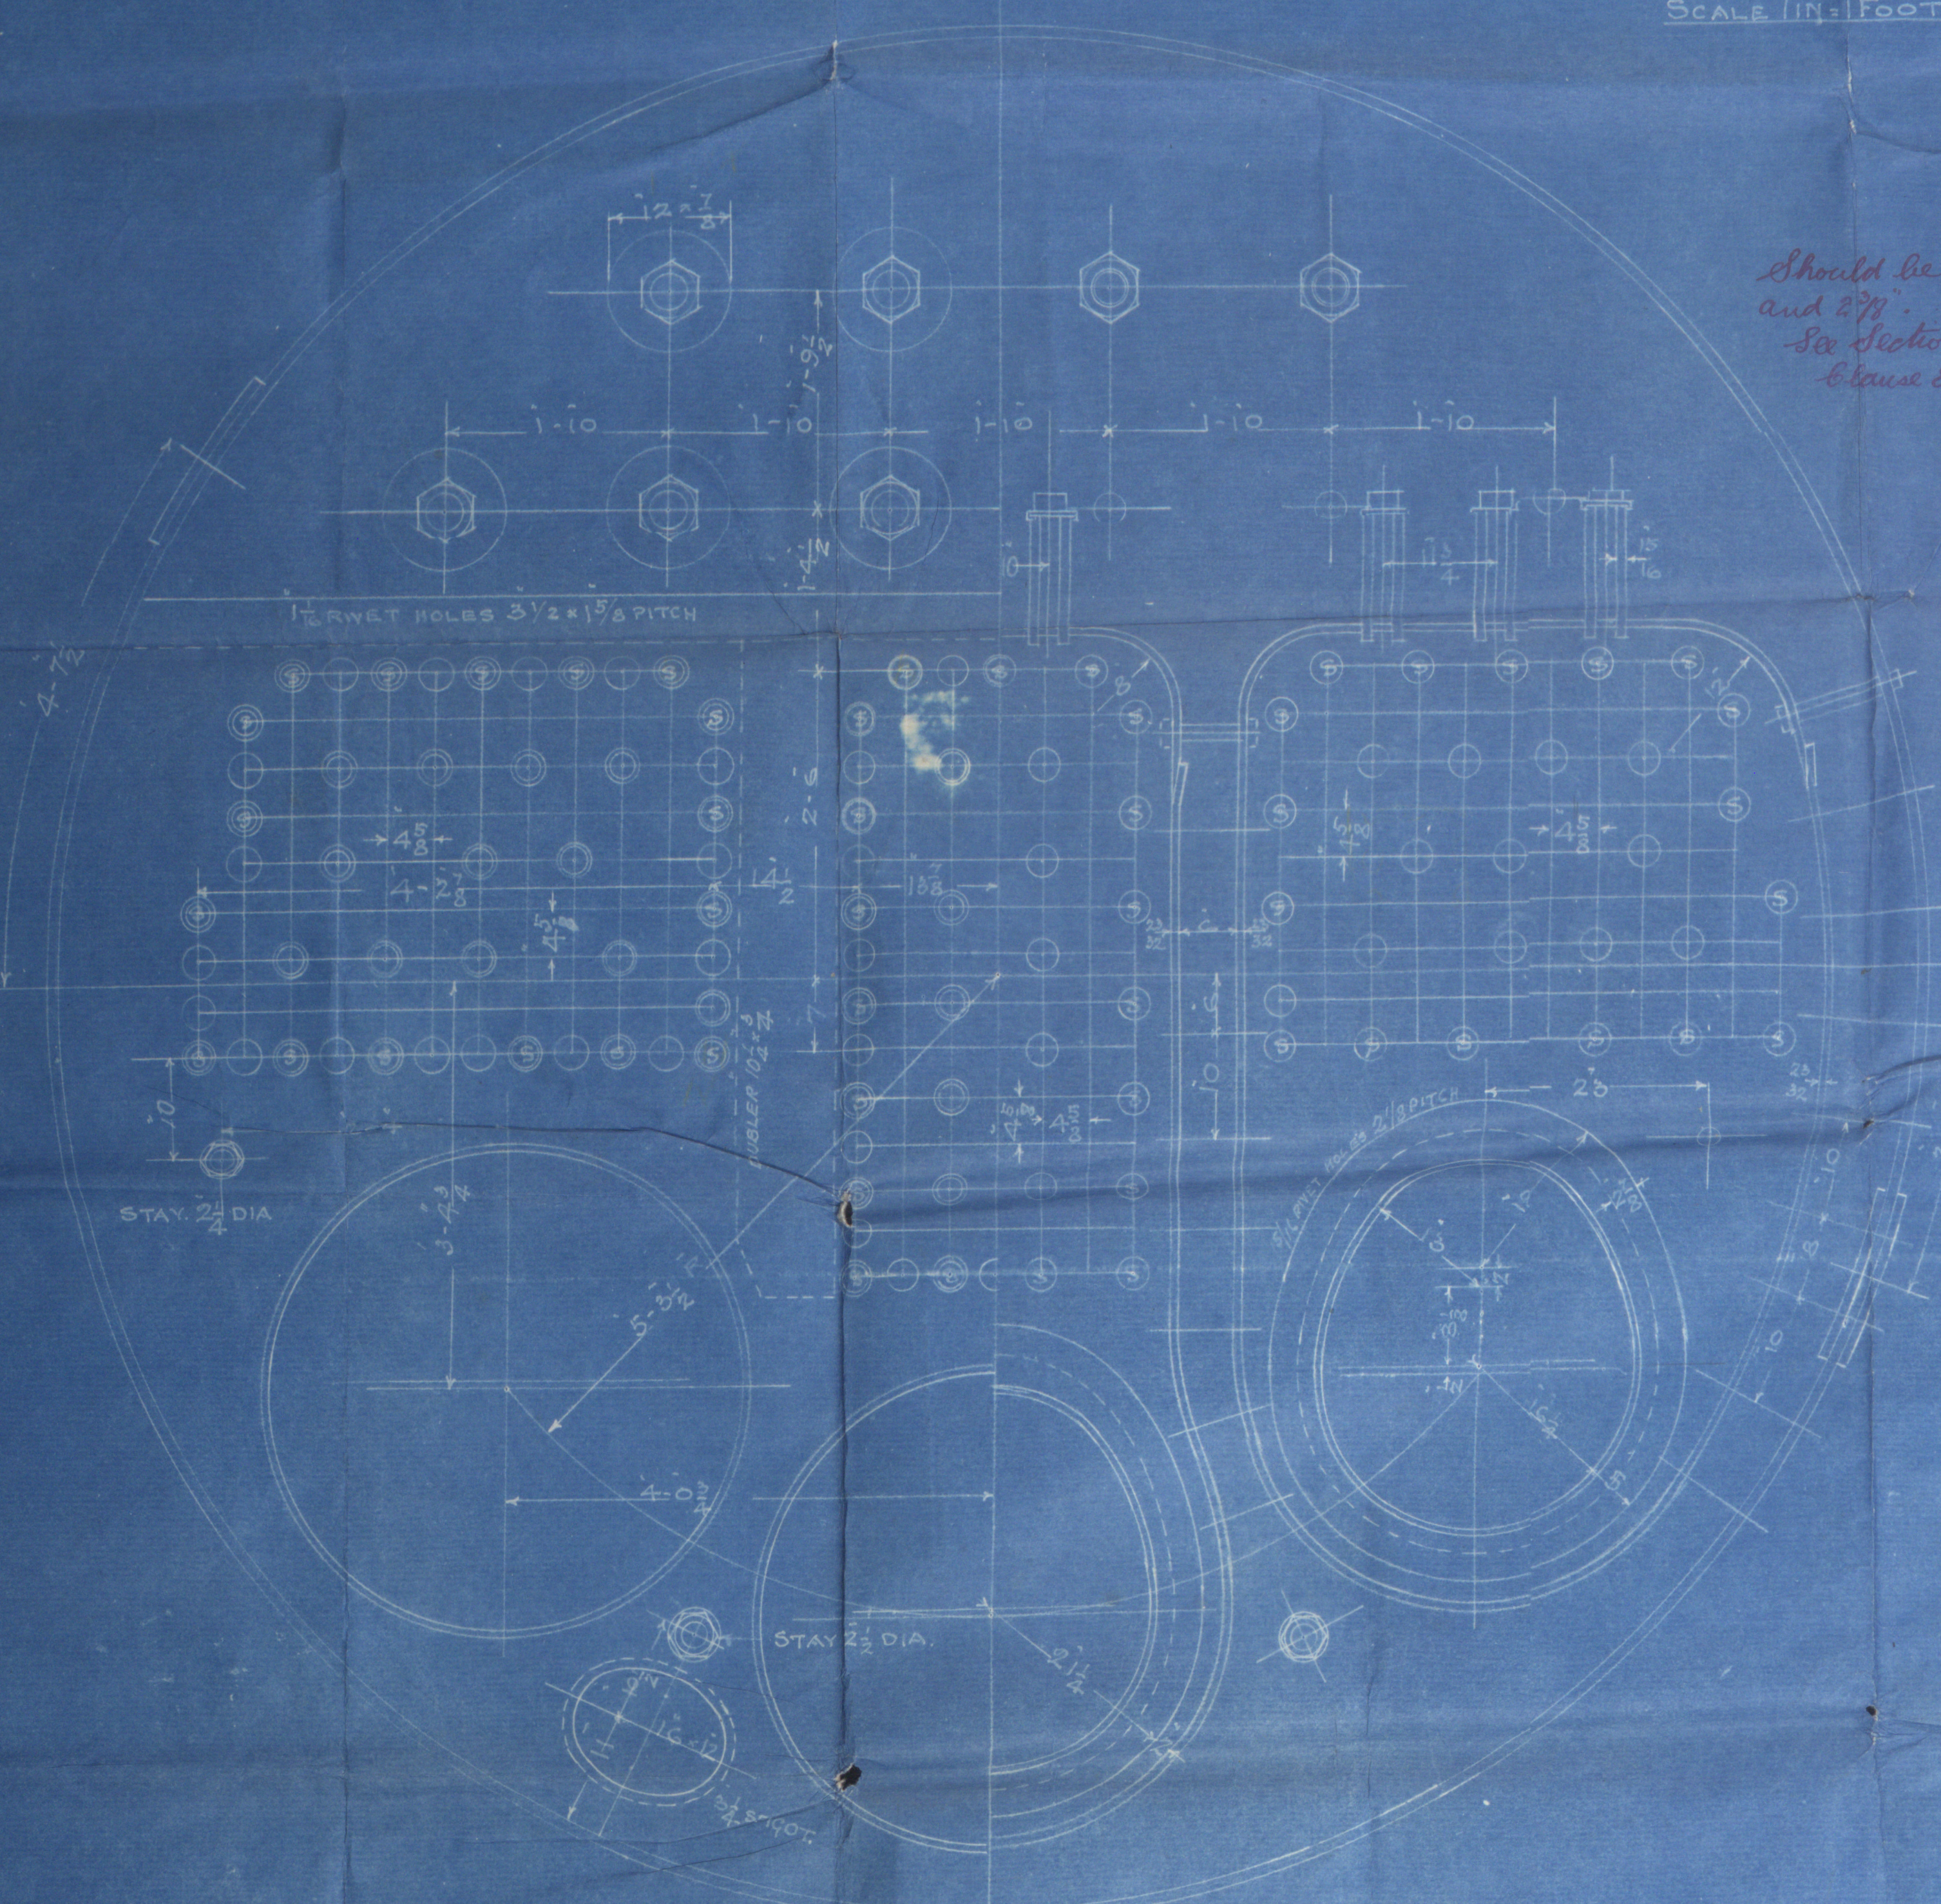

MANHOLE 12x10, WITH 1/2"  
SHOT PLANGED IN END PLATE.

BOILERS NO D 167 S

TO PASS LLOYD'S SURVEY FOR 180 LBS WORK PRESS.  
& TESTED IN THE PRESENCE OF LLOYD'S OWNERS SURVEYOR.  
TO BE FITTED TO MESSRS SMITH'S DOCK CO. 33, N. 818, B. 19.

9/12/26





W437-0178

No 3687  
Lloyd's Seat  
320 lbs  
W.P. 180 lbs  
21.7.26 RDS

D 168  
"Santa" s/s

No 3683  
Lloyd's Seat  
320 lbs  
W.P. 180 lbs  
21.5.26 RDS

D 167



Lloyd's Register  
Foundation



MAIN BOILERS

RICHARDSONS

WESTGARTH & CO LD

Nos D 167 - 168

SMITHS DOCK CO LD

SS Nos 818 - 819

*Wp Rpt N: 16402 - 818*

*16452 - 819.*

*Please return  
for duplicate  
Chevy Chase*

S.S. Kingston  
M.D.B. RPT. No. 1

13527

RETAIN

LR

Lloyd's Register  
Foundation