


From S. S. "Hungarian" of Glasgow  
Greenock Report No. 4613.

Rec 18/10/78

18/10/78

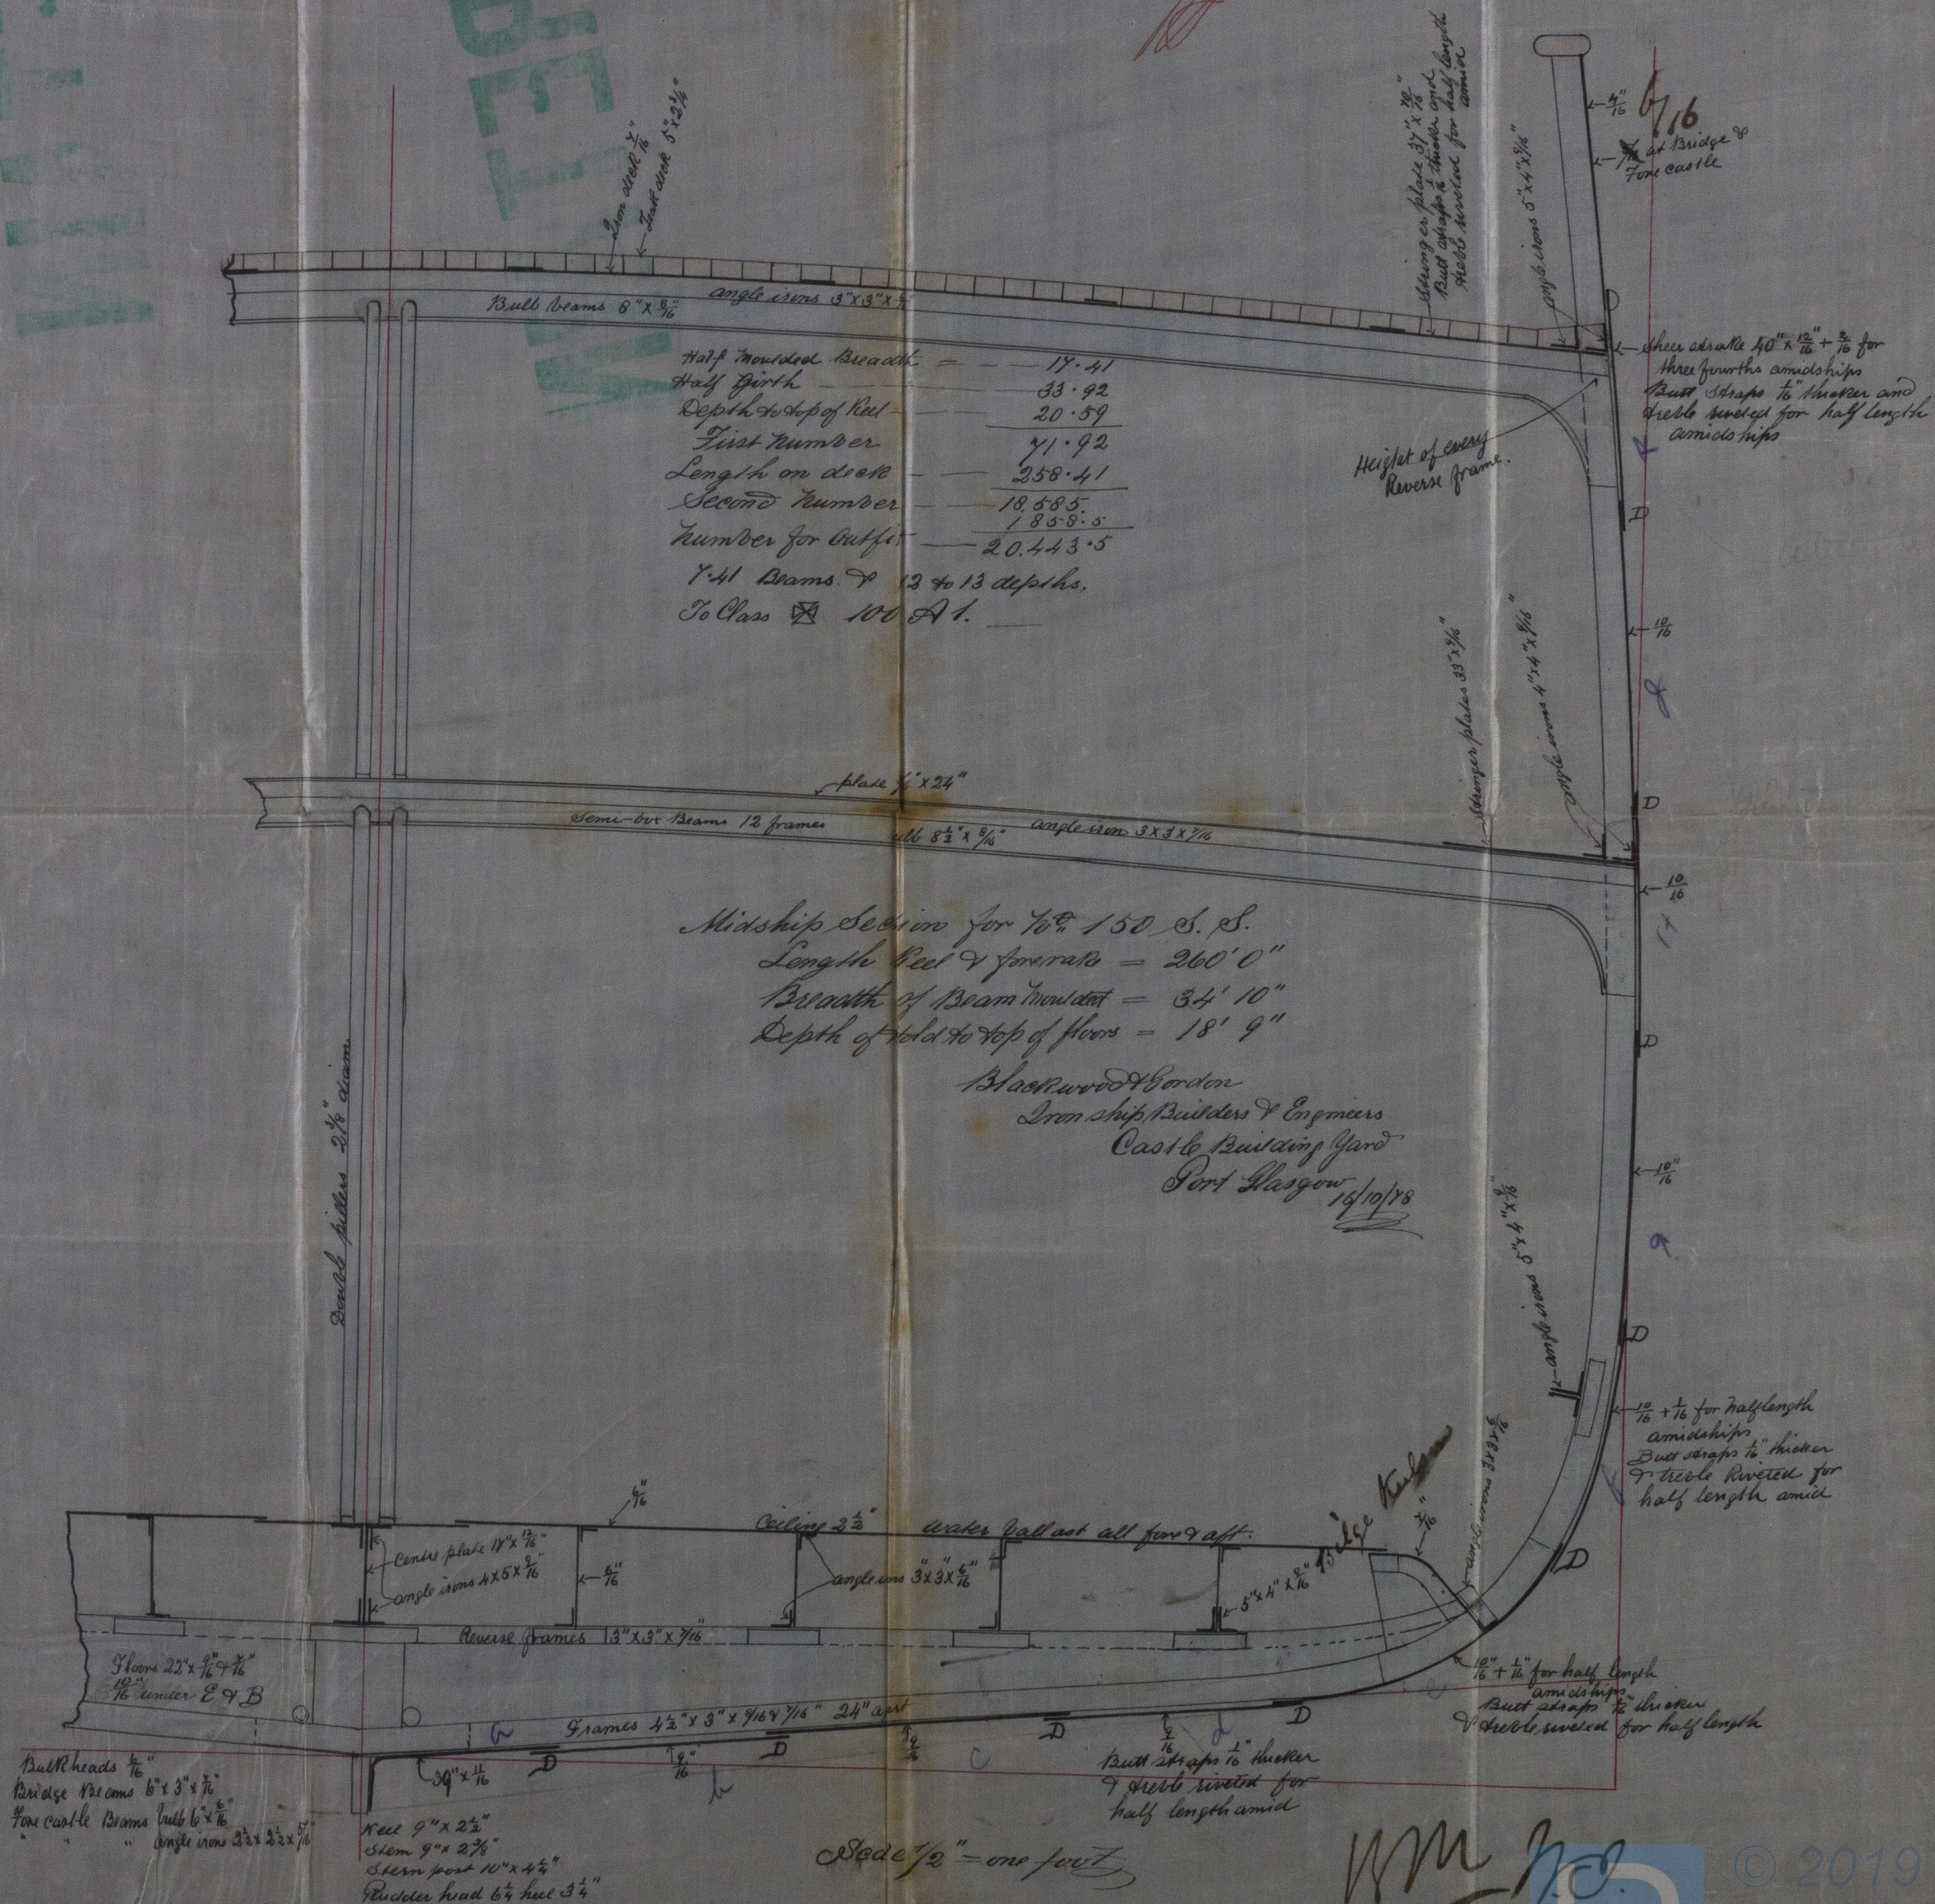

Side  $\frac{1}{2}$ " = one foot

WM H.O.  
18/10/78

Lloyd's Register  
Foundation


W437-0199



*Middle Section*

RETAIN

RETAIN

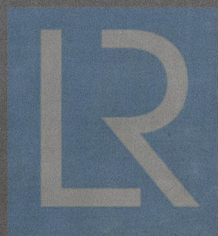

© 2019

Lloyd's Register  
Foundation