

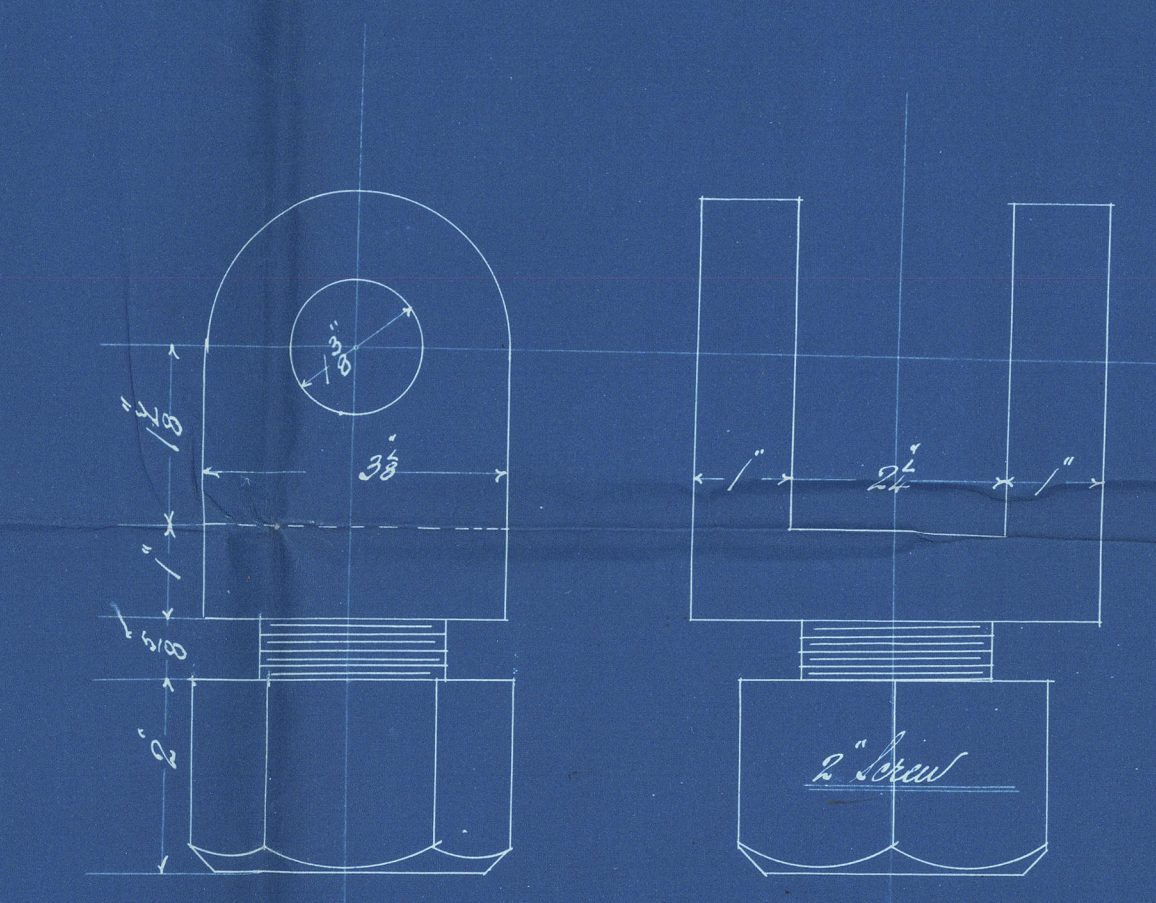
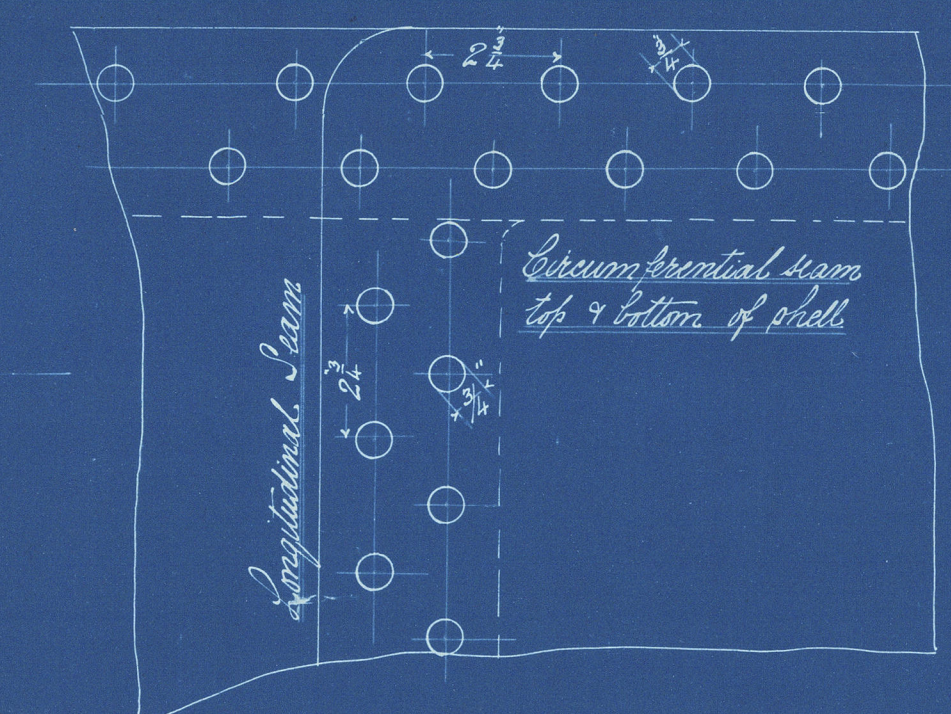
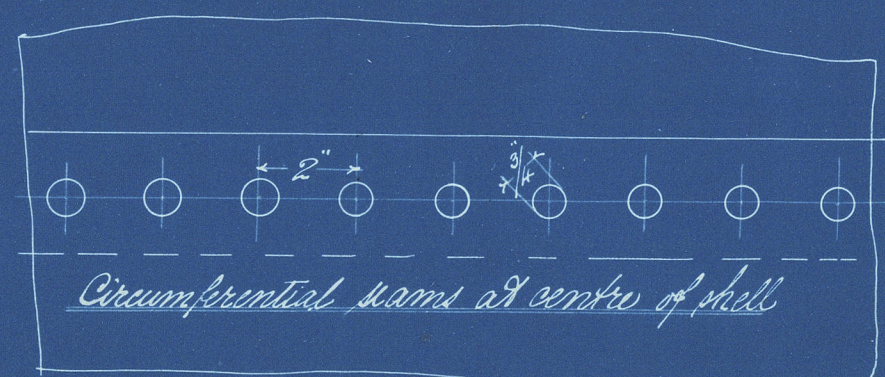
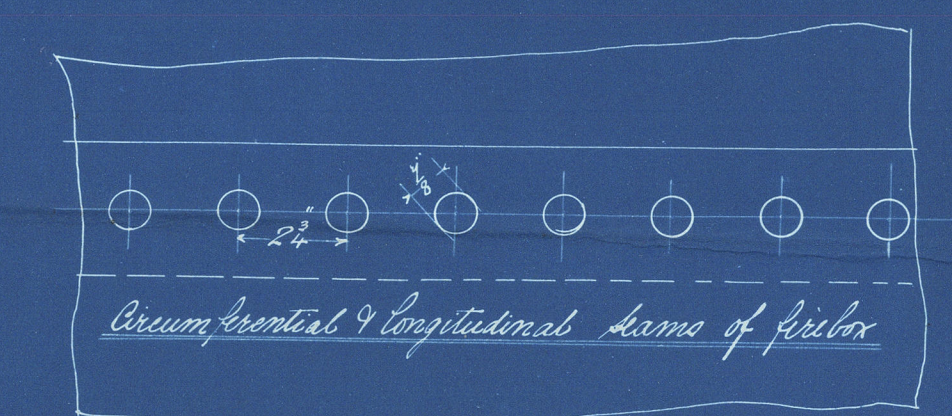
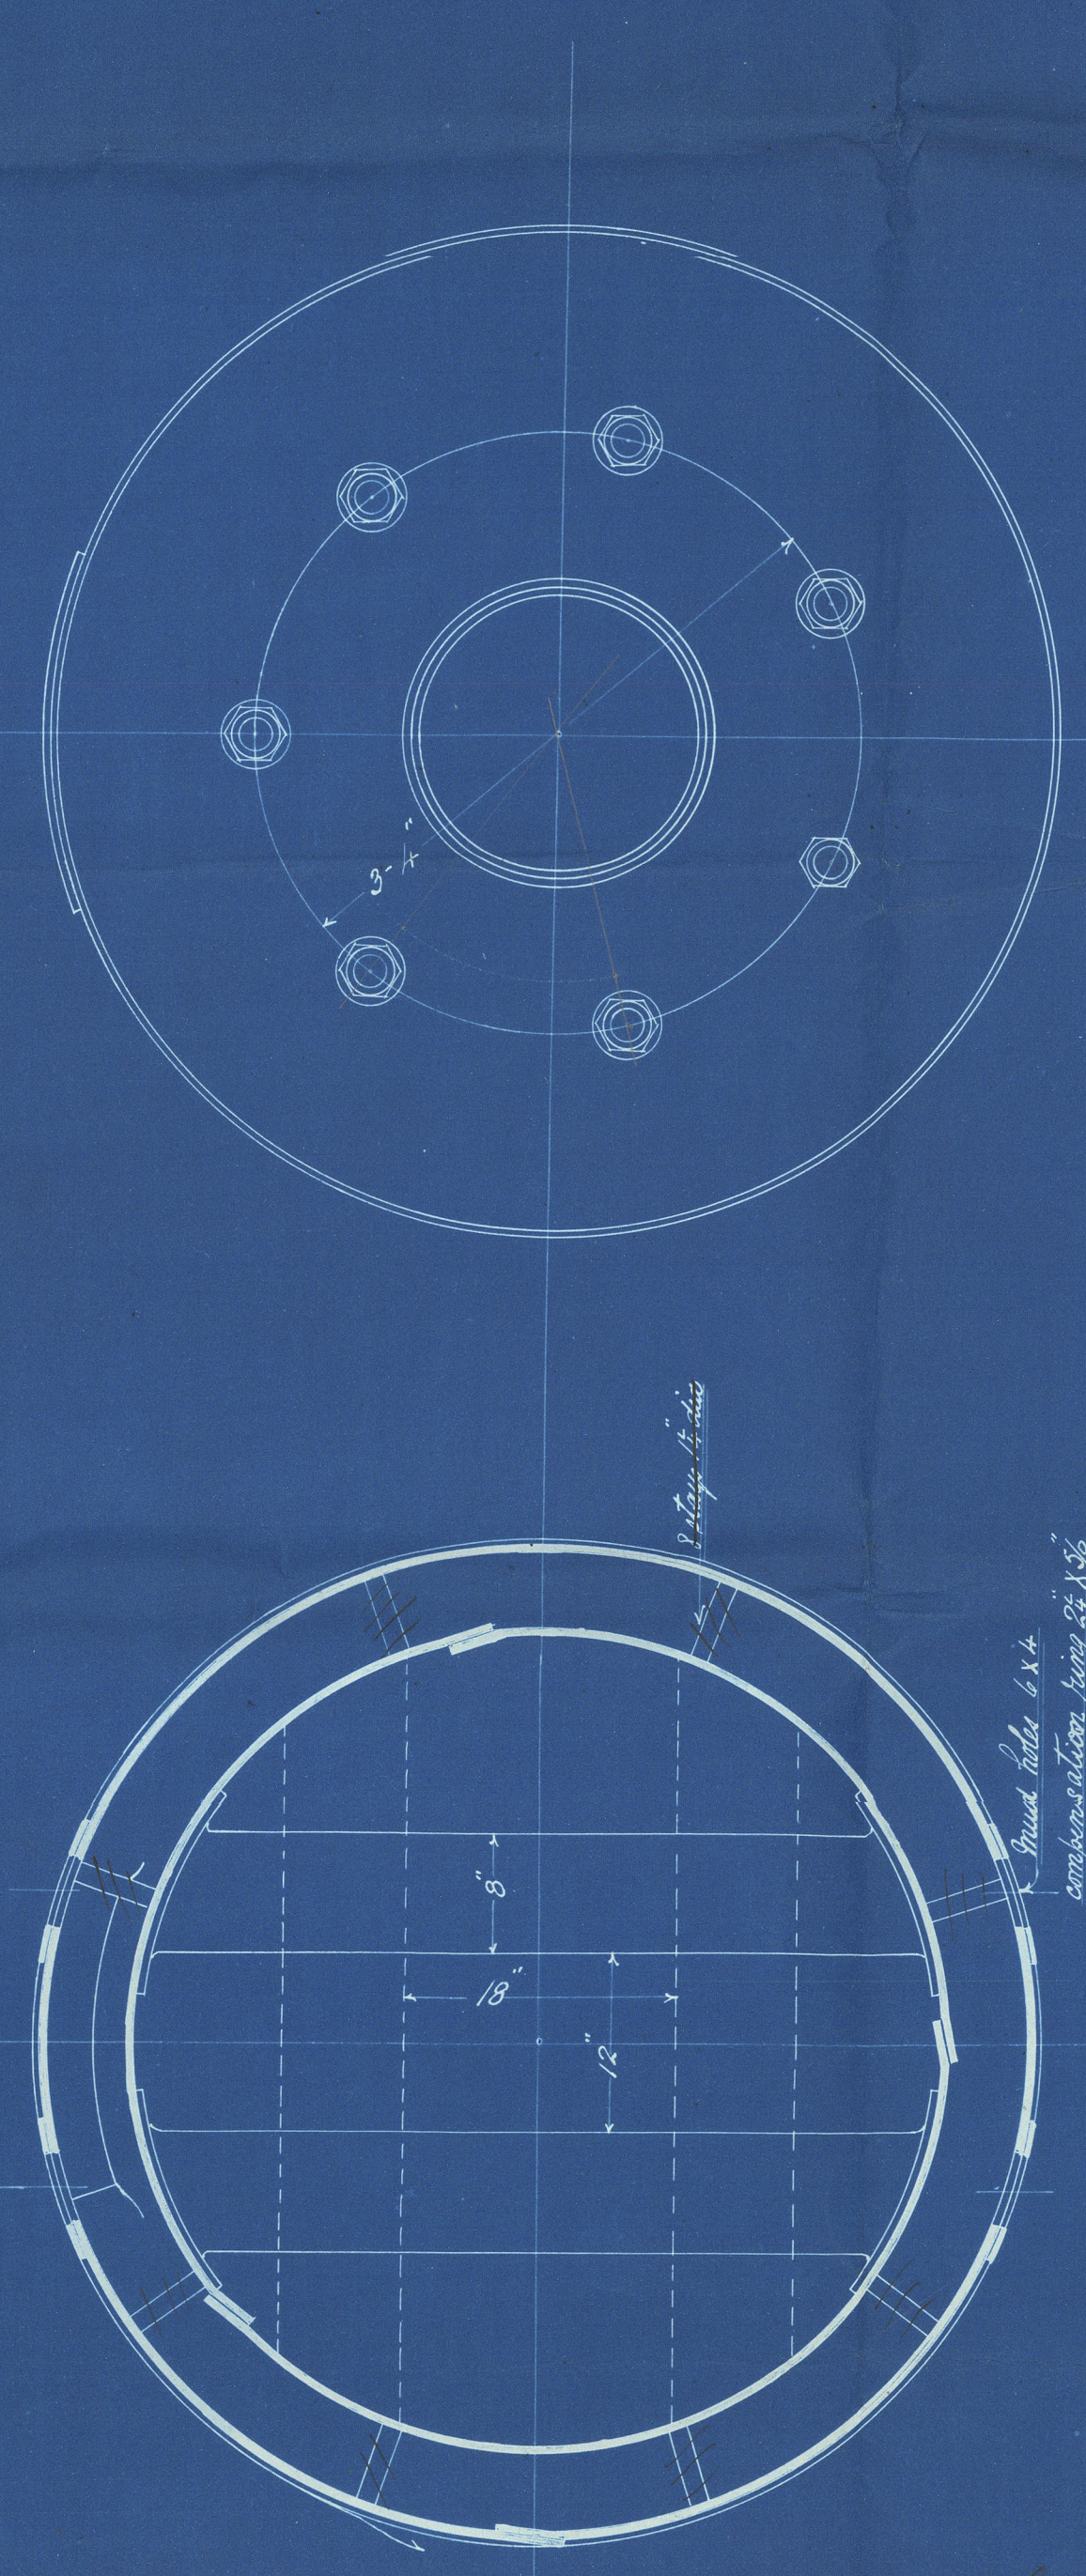


111 23.9.91

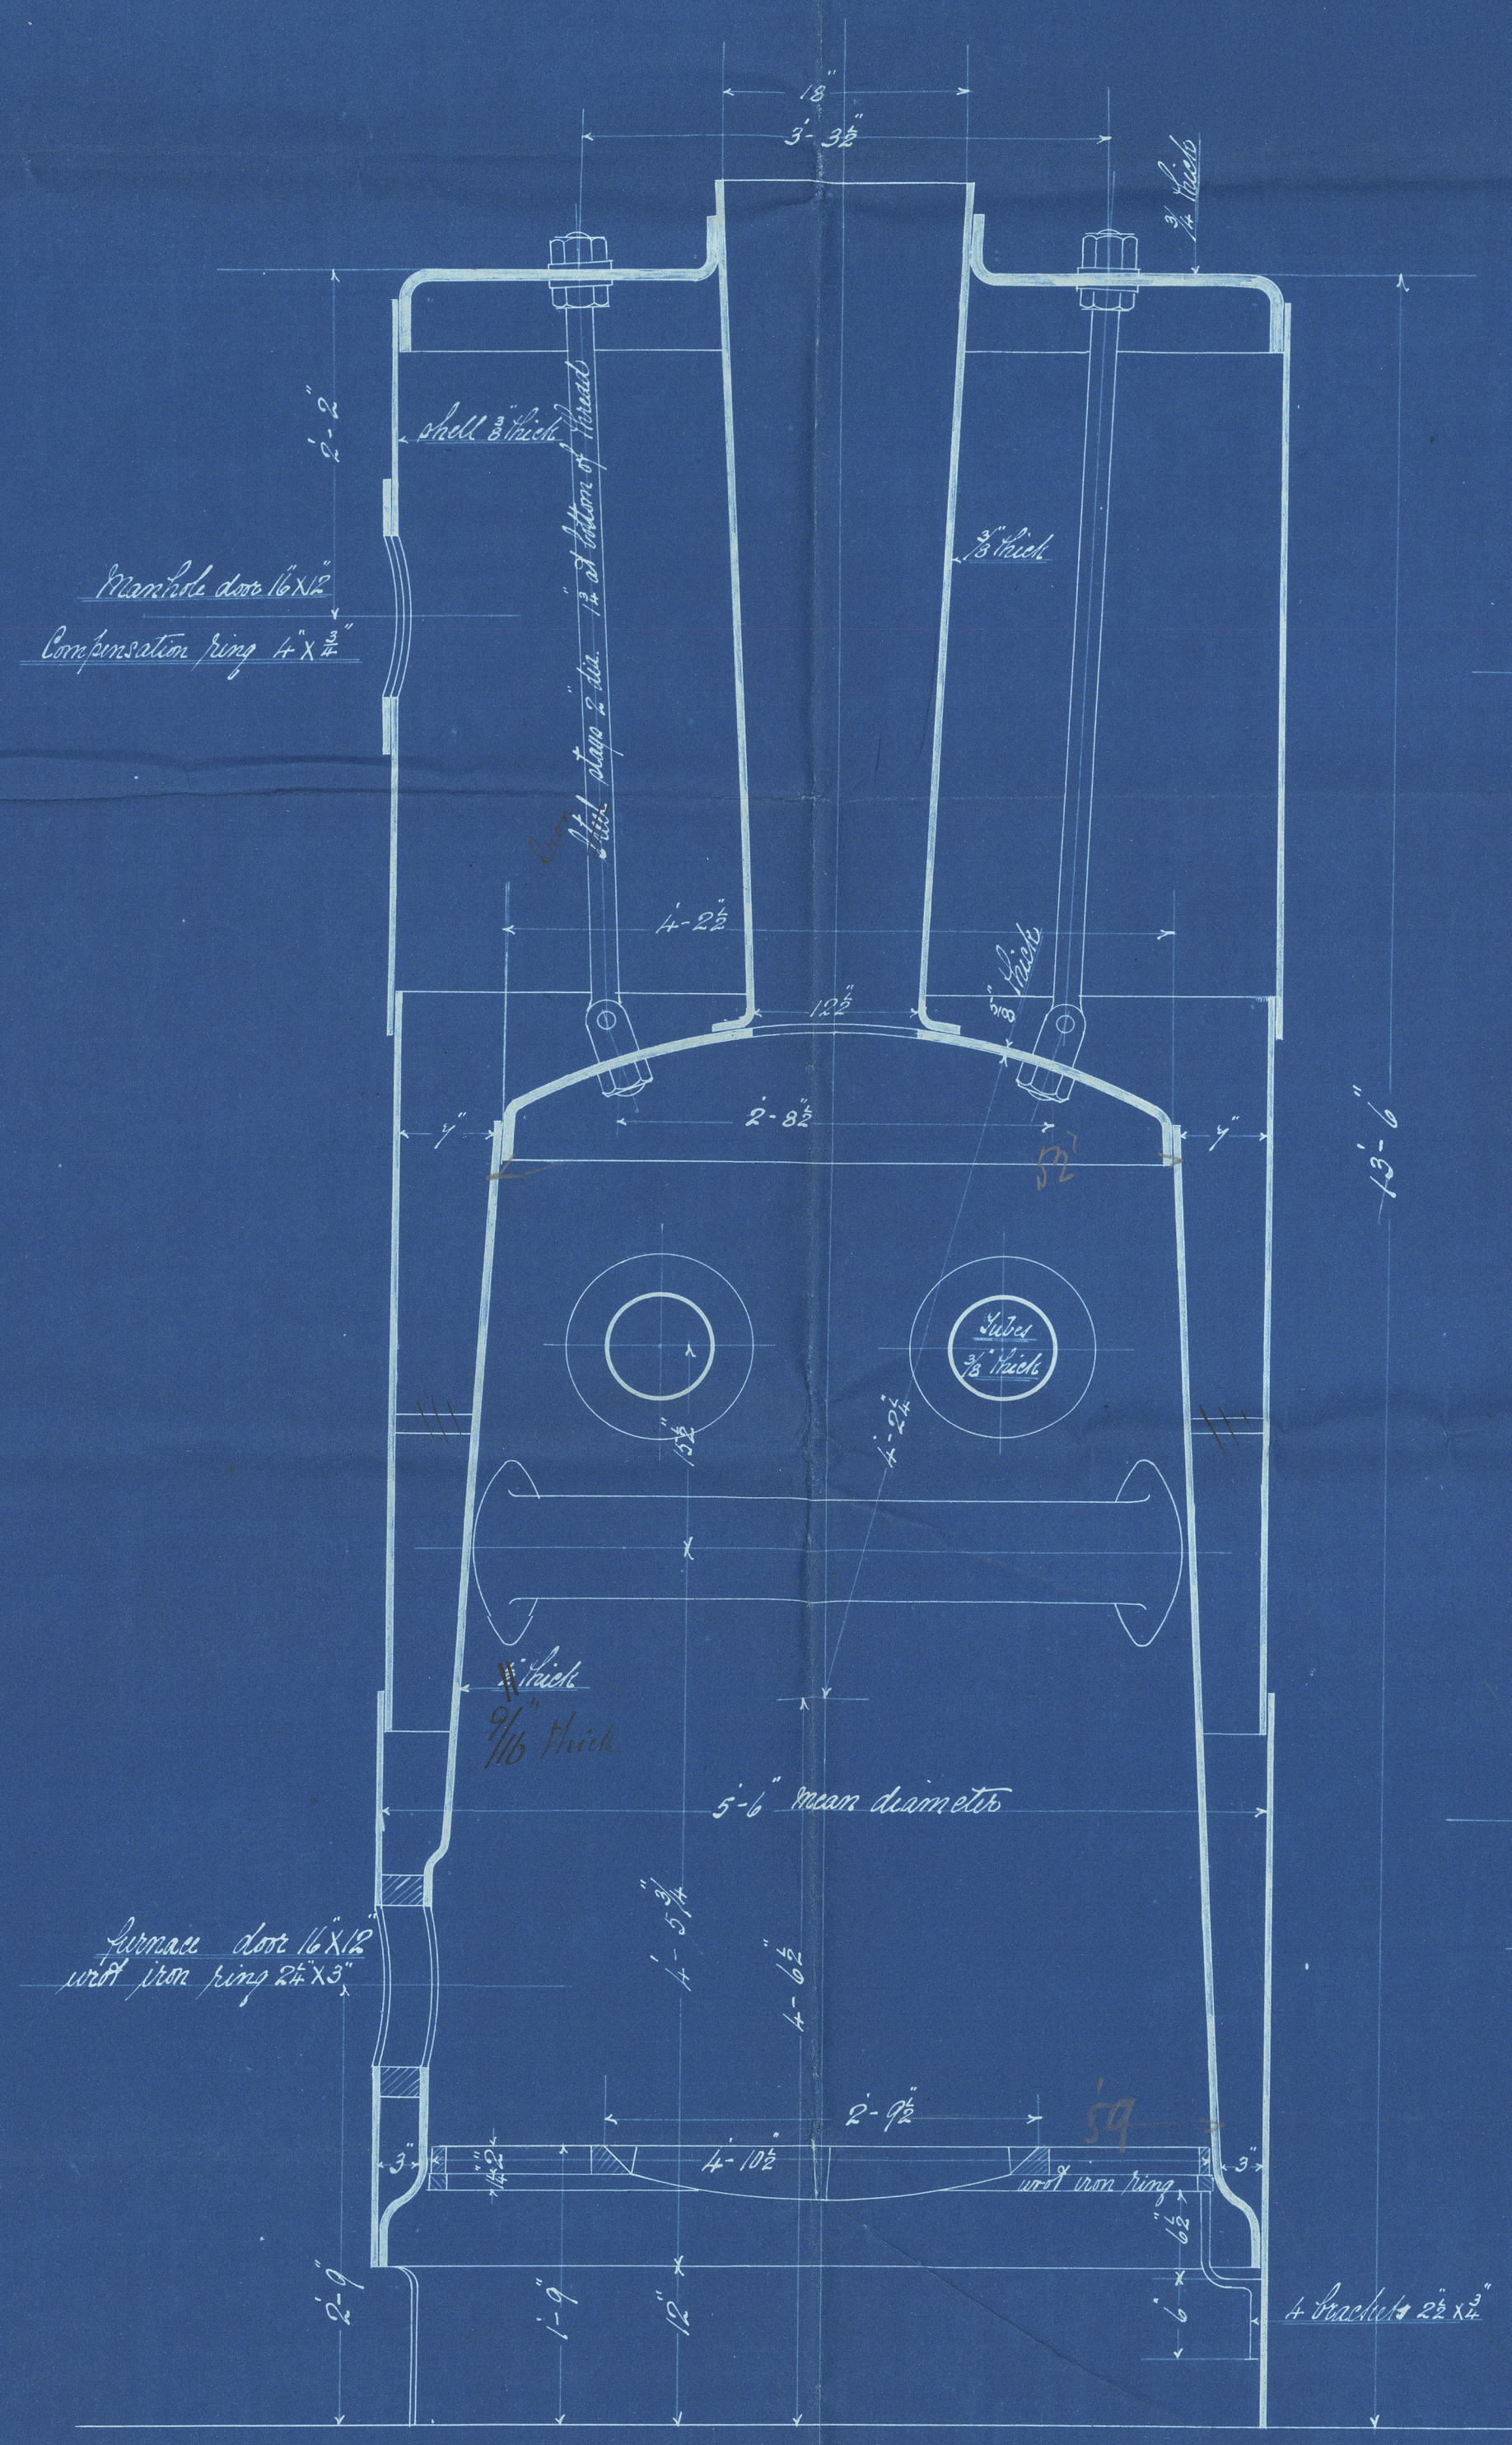

8 off half size

— DONKEY BOILER No 338 FOR S.S. HUNGARIAN —
 — ALL OF STEEL — WORKING PRESSURE 80 LBS PER SQ IN —
 — 1" = ONE FOOT — 19th SEPT 1891 —

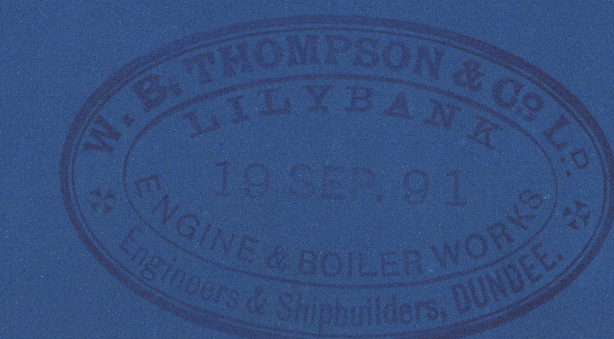

Fire box plate to be made 7/16 inch thick, with no screwed stays, or 1/2 inch thick, with 1/4" screwed stays, pitched 15x15, when the furnace is not supported by cross stays, and fire hole ring.
 W.A.
 23.9.91

Dundee
 Report No 5453

M.B.L.

Donkey Boiler

No 338

for.

S. S. "Hungarian"

W. G. Thompson & Co.
Ld.

Dundee

Report No 5455.

No 624.
Lloyds Test.
160 lbs.
Hf. 1/3/92

RETAIN



© 2019

Lloyd's Register
Foundation

W437-0278