

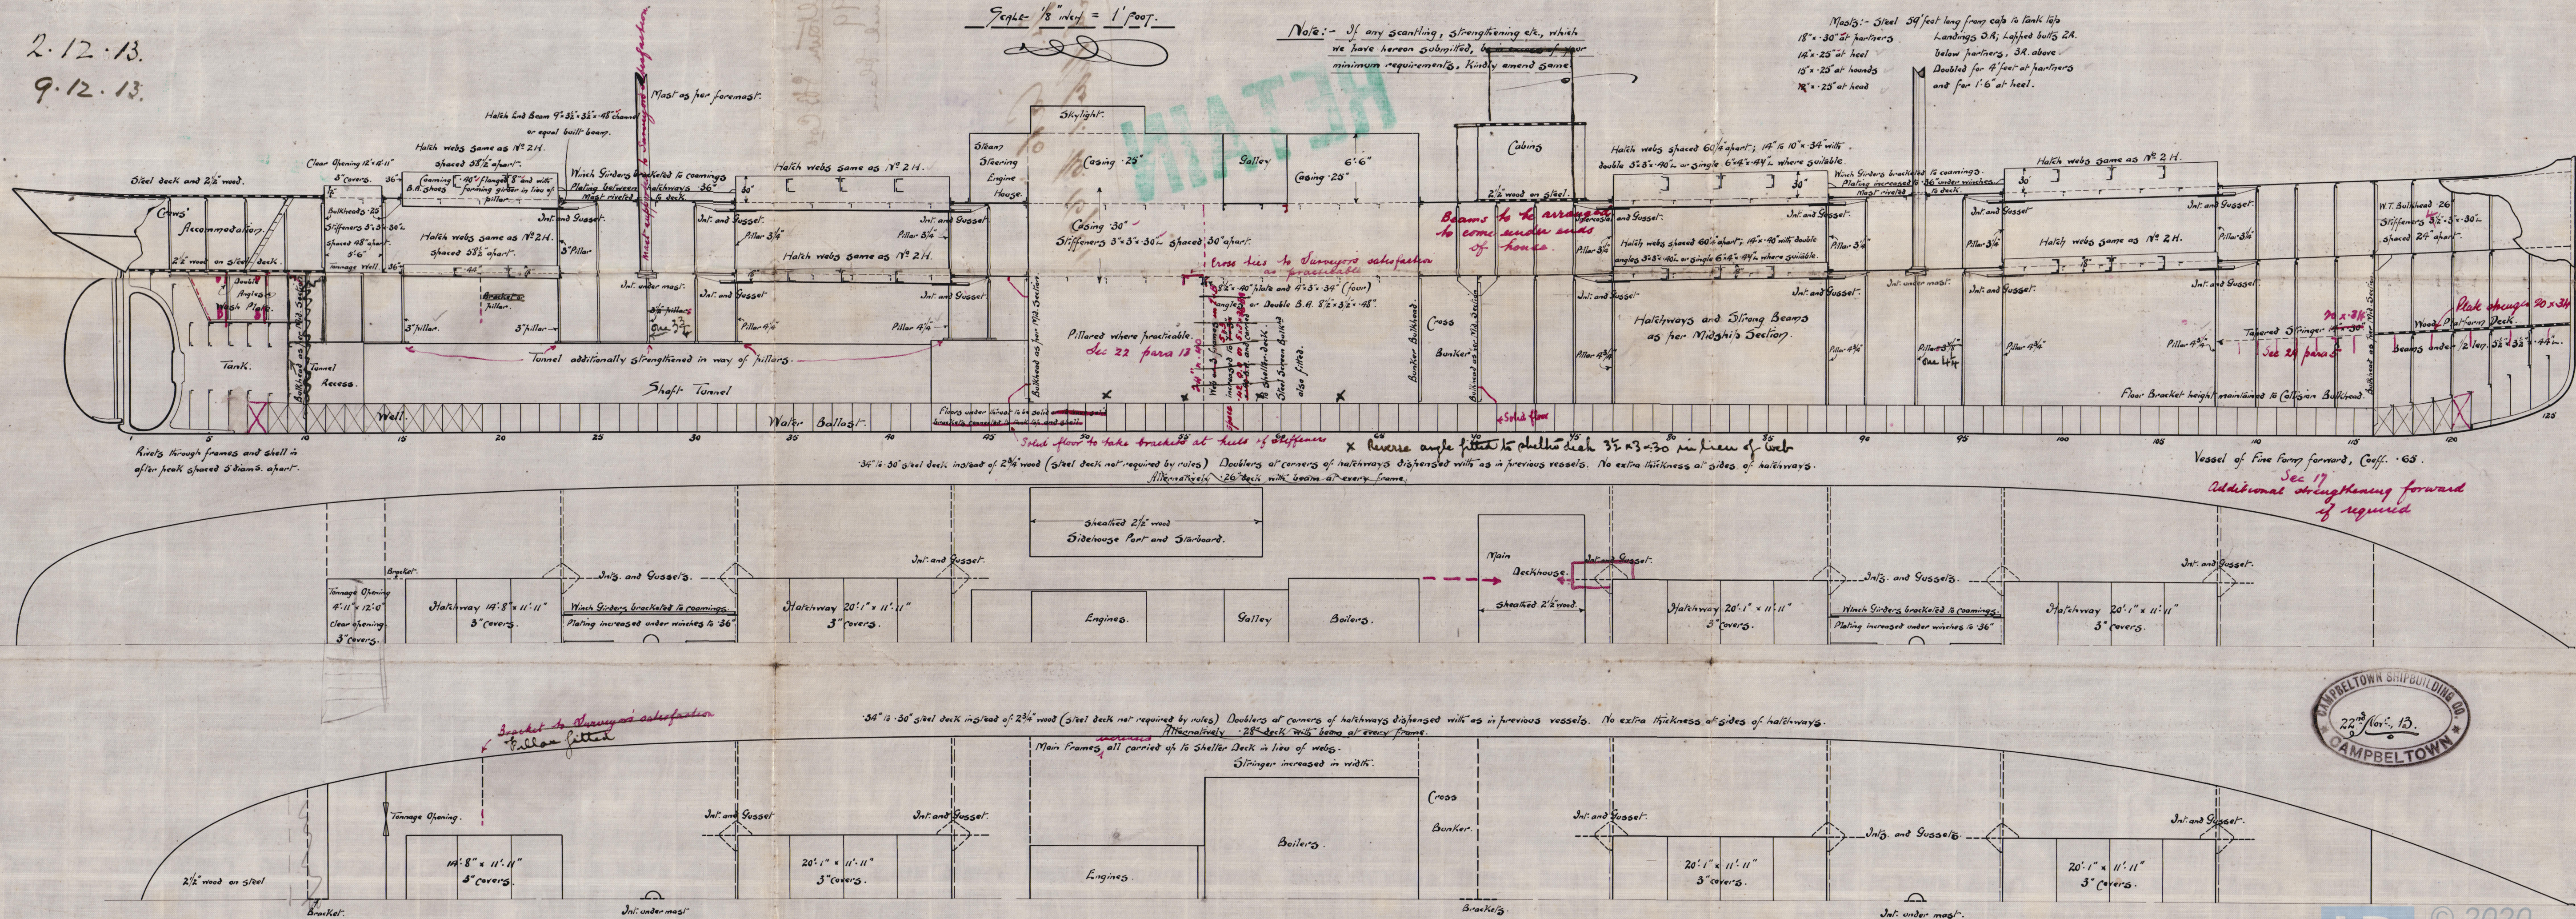
5/5. No 99 (230' B.P. x 30.45' M.L.D. x 14' and 21' 0" M.L.D.)

Scale  $\frac{1}{8}$ " inch = 1' foot.

Note:- If any scantling, strengthening etc., which we have heron submitted, ~~be in excess of your~~ minimum requirements, kindly amend same.

Mast 3:- Steel 59 feet long from cap to tank top  
18" x 30" at partners Landing 3R; Lashed bulk 2R.  
14" x 25" at heel below partners, 3R. above.  
15" x 25" at hounds Doubled for 4' feet at partners  
12" x 25" at head and for 1' 6" at heel.

2. 12. 13.  
9. 12. 13.

A circular ink stamp from the Campbelltown Shipbuilding Co. The outer ring of the stamp contains the text "CAMPBELTOWN SHIPBUILDING CO." at the top and "CAMPBELTOWN" at the bottom, separated by two small stars on the left and right. In the center of the stamp, the date "22<sup>nd</sup> Nov. 13." is handwritten in a cursive script.

© 2020

Lloyd's Register  
Foundation

W439-0091

2.12.13.



Campbeltown SB Cos.  
No 99  
Longitudinal Plan

Is. Cato  
Greenock Report. No. 16701

RETAIN



© 2020

Lloyd's Register  
Foundation

LW439-0091