

No 1115.
MIDSHIP SECTION.
SCALE 1" = 1 FOOT

LENGTH.....157'-2"
BREADTH.....26'-0" MLD.
DEPTH.....12'-0" MLD.

EQUIPMENT N°

HULL = 5972 ✓
RAISED QUARTER DECK 57'-4" x 3'-2" = 184 ✓
FORECASTLE 24' x 6'-6" x 75 = 120 ✓
ENGINEERS HOUSE 46'-7" x 6'-6" x 5 = 152 ✓
CASING }
MESS ROOM }
6428 ✓

CLASS 100 A1 LLOYDS.

LLOYDS NUMERALS


DEPTH MLD 12-00
BREADTH MLD 26-00
38-00 TRANS N° ✓
LENGTH B P 157-16
5972 = LONG N° ✓
 $\frac{L}{D} = 13-09$ ✓ $\frac{L}{B} = 10-82$ ✓

IN WAY OF RAISED QUARTER DECK

DEPTH MLD 15-2
BREADTH MLD 26-00
41-2 TRANS N° ✓
 $\frac{L}{B} = 10-34$ ✓
 $\frac{L}{D} = 13-11$ ✓

EQUIPMENT

2 BOWER ANCHORS EACH 10 1/4 CWTs STOCKLESS ✓
1 " " 8 3/4 " " ✓
1 STREAM " 3 1/2 " " EX STOCK ✓
1 KEDGE " 1 1/2 " " ✓
150-160 FATHOMS 1 1/2" STUD CHAIN CABLE ✓
60 " 2 1/4" STEEL STREAM WIRE ✓
75 " 2 1/2" " " " ✓
1 HAWSER 90 FATHOMS 5 1/2" ✓

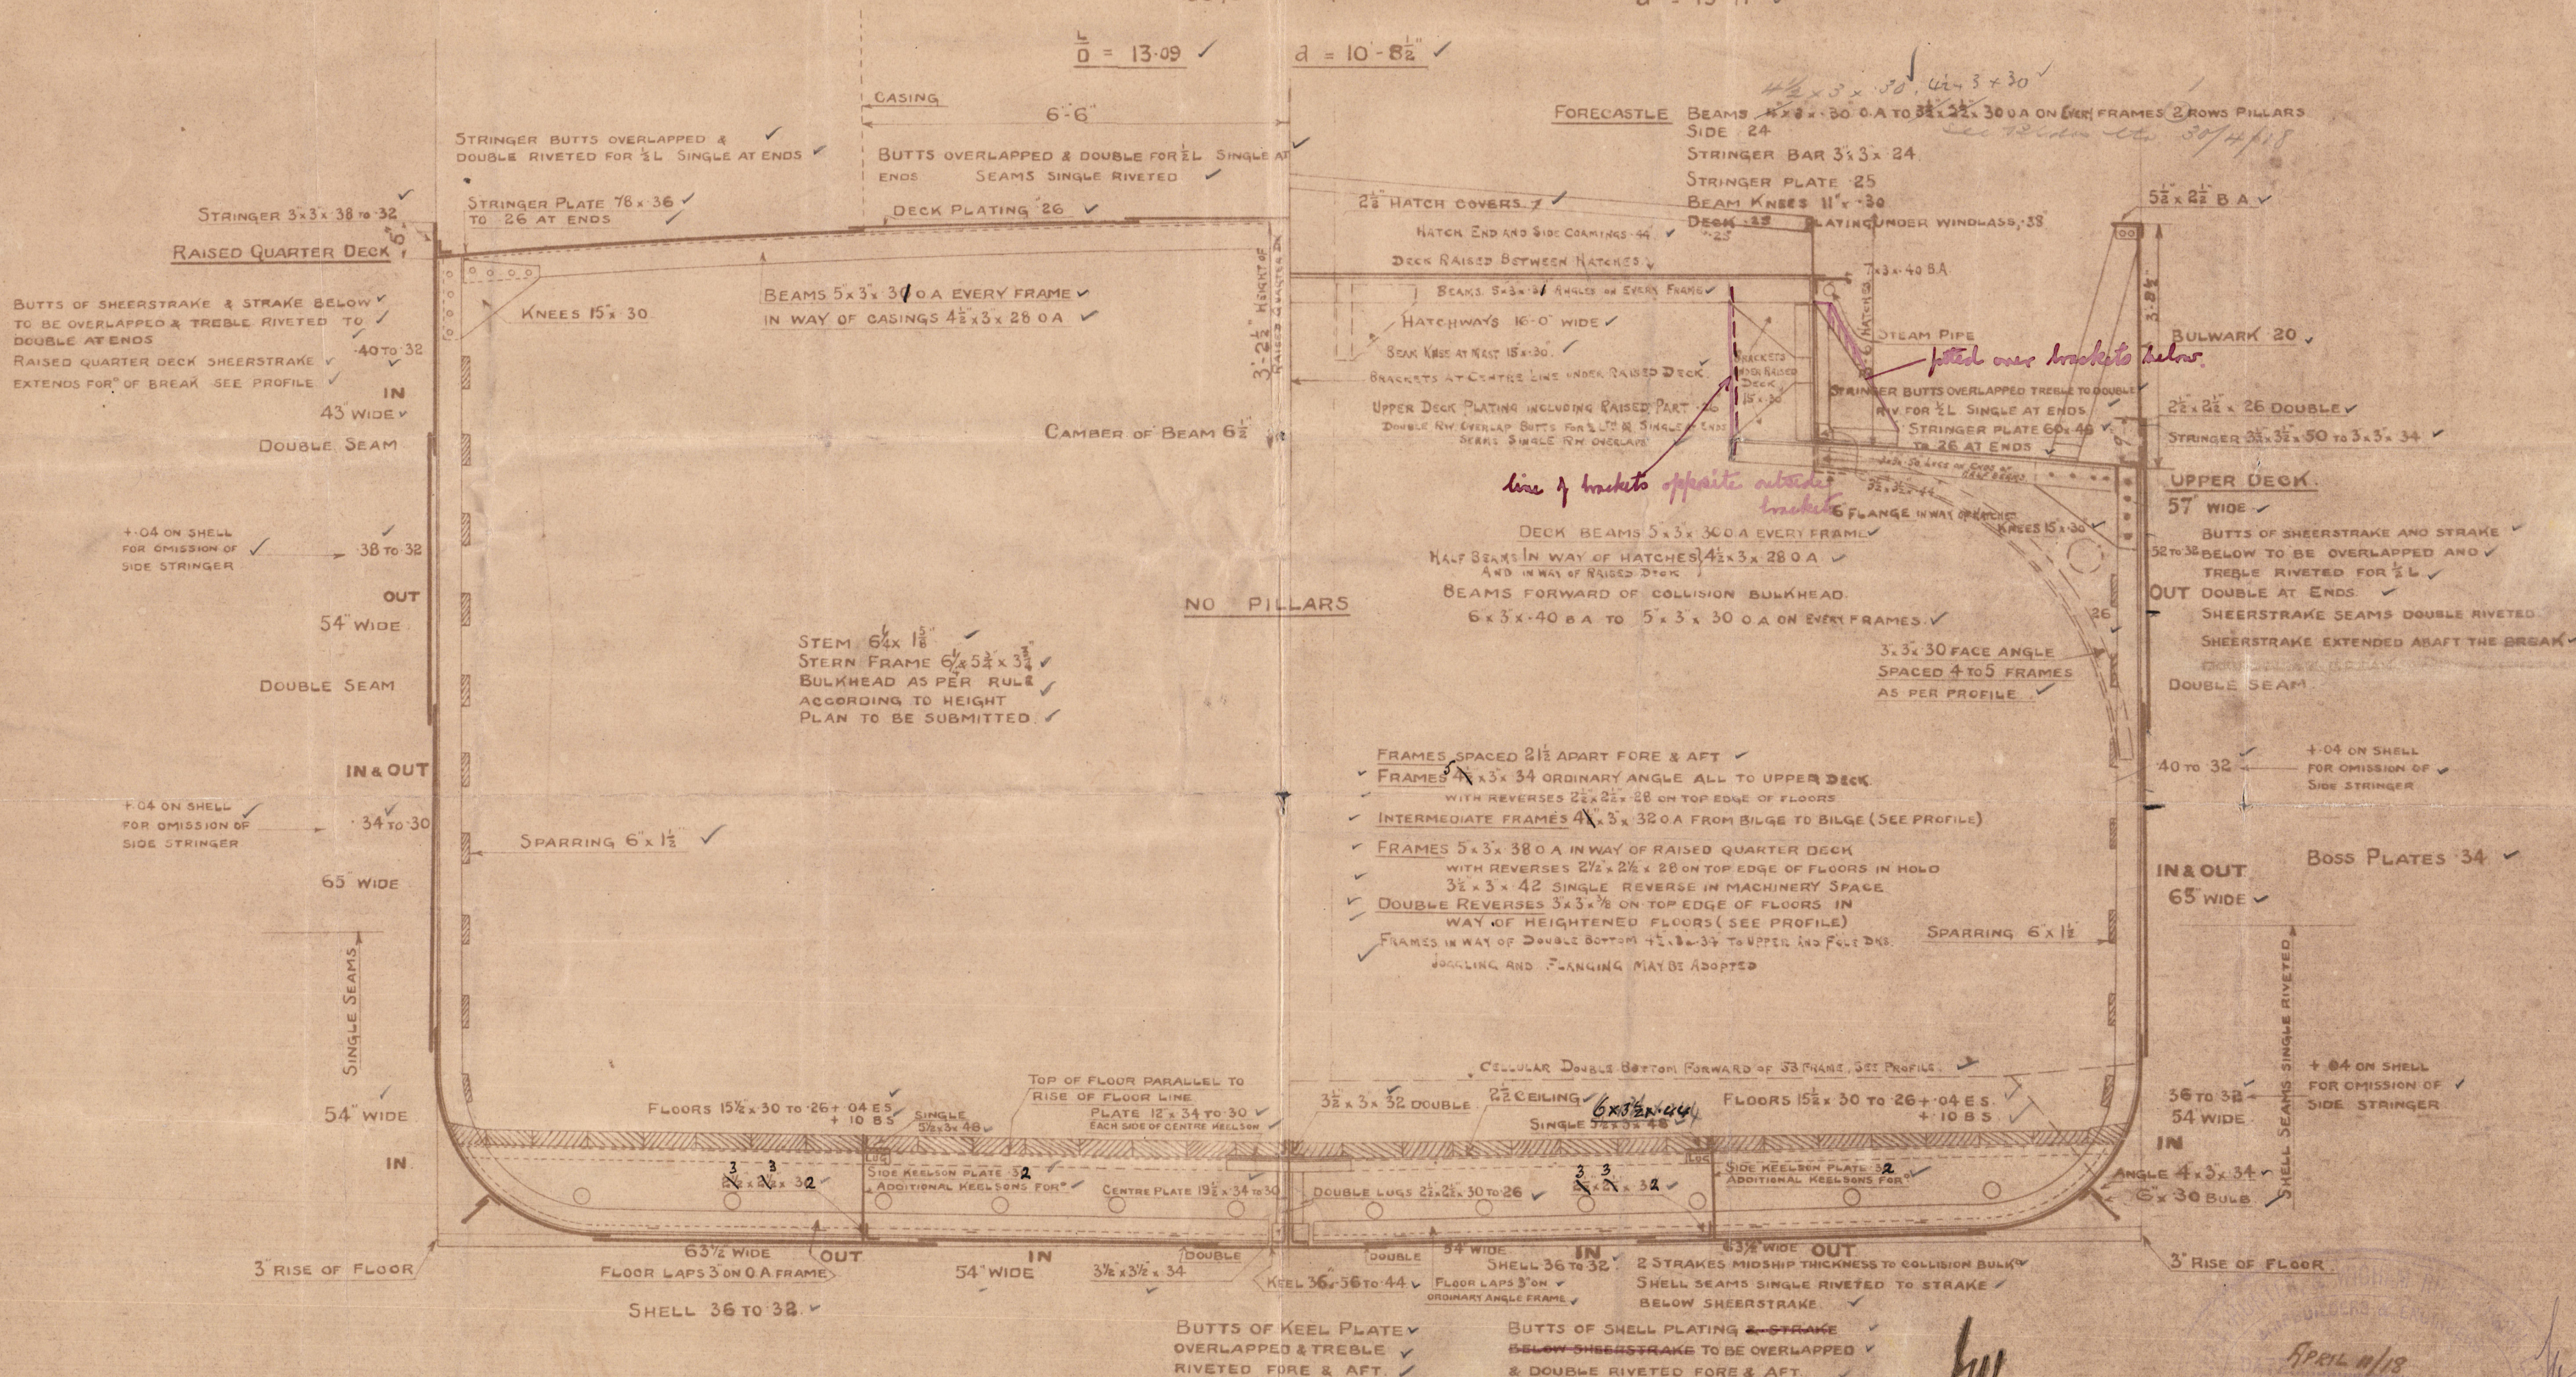

for
13.4.18

No. 1

SWAN HUNTER & WIGHAM
RICHARDSON LTD

SS No. 1115

STANDARD. C.S. TYPE

Middlesex Section

S.S. WAR. TAMAR
NEWCASTLE ON TYNE.

Report No. 71840.

Border Firth

RETAIN

© 2020



Lloyd's Register
Foundation

W439-0152


RETAIR

ATTACHED TO
17538



© 2020

Lloyd's Register
Foundation

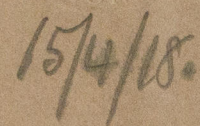

MIDSHIP SECTION.

SCALE $\frac{1}{2}'' = 1$ FOOT

LENGTH.....157'-2"
BREADTH.....26'-0" MLD
DEPTH.....12'-0" MLD

EQUIPMENT N°

HULL		=	572	✓
RAISED QUARTER DECK	37-4 x 3-28	=	184	✓
FORECASTLE	24 T x 6-6 x 75	=	120	✓
ENGINEERS HOUSE				
GASING	46-7 x 6-6 x 5	=	152	✓
MESS ROOM				

CLASS 100 A1 LLOYDS

LLOYDS NUMERALS

IN WAY OF RAISED QUARTER DECK

DEPTH MLD 12.00
BREADTH MLD 26.00
38.00 TRANS N° ✓
★
LENGTH BP 157.16
5972 = LONG^t N° ✓

DEPTH MLD 15 2
BREADTH MLD 26 00
41 2 TRANS N° ✓
 $\frac{L}{D} = 10\ 34$ ✓
 $d = 13-11''$ ✓

EQUIPMENT

2	BOWER ANCHORS EACH	10 $\frac{1}{2}$	CWTS STOCKLESS	✓
1		8 $\frac{1}{2}$		
1	STREAM	3 $\frac{1}{2}$	EX STOCK	✓
1	KEDGE	1 $\frac{1}{2}$		
150	150 FATHOMS	1 $\frac{1}{2}$	STUD CHAIN CABLE	✓
60		2 $\frac{1}{2}$	STEEL STREAM WIRE	✓
75		2 $\frac{1}{2}$	TOW LINE	✓
1	HAWSER	90	FATHOMS 5 $\frac{1}{2}$	✓

13.4.18