


Office

SECTIONS MARKED * ARE NEW GERMAN STANDARD.

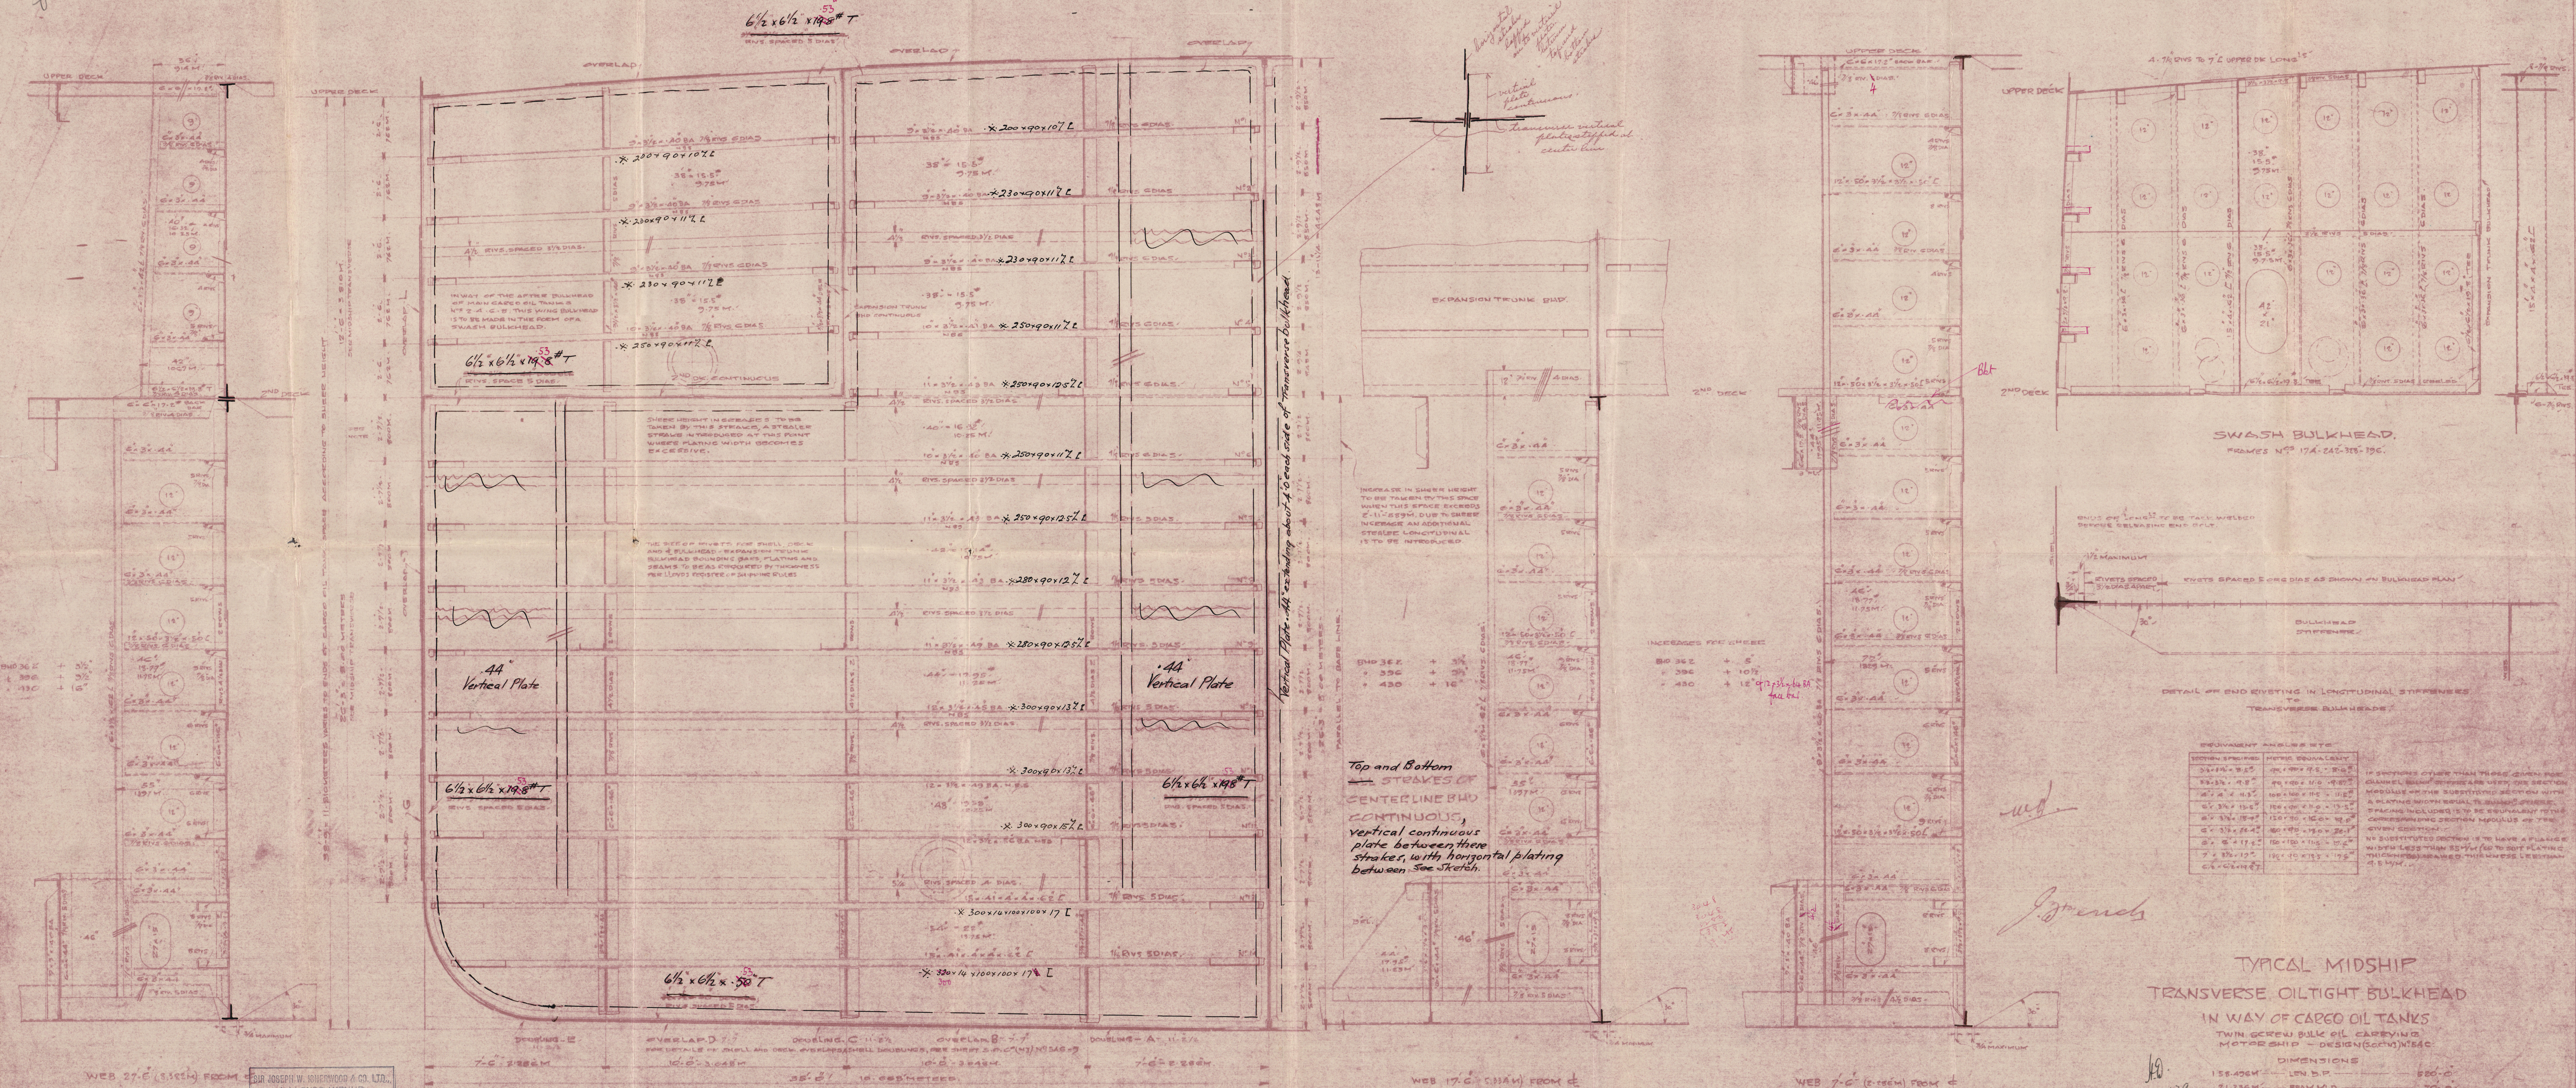

Top and Bottom STRAKES OF CENTERLINE BULKHEAD CONTINUOUS, vertical continuous plate between these strakes, with horizontal plating between. See sketch.

COMMON SPECIFICATIONS	METRIC EQUIVALENT
TYPICAL MIDSHIP TRANSVERSE OILTIGHT BULKHEAD IN WAY OF CARGO OIL TANKS TWIN SCREW BULK OIL CARRYING MOTORSHIP - DESIGN (600)154C

DIMENSIONS	
LEN. B.P.	520'-0"
BEAM MLD	70'-0"
DEPTH TO UPPER DECK	38'-5"

From Vulture
Yapack
Sol. No. 1624-5. Plan No. 7706
16-11-29.

FOR ENCLOSURE TO
DATE 6-11-29

APPROVED STANDARD OIL CO. (N) MARINE DEPARTMENT 22 DEERMAN WAY N.Y.C.
RECEIVED BY SIE J. WISHERWOOD & CO. LTD. 17 BATTERY PLACE NEW YORK CITY
SIGNED [Signature] 7/1/29

REGISTERED FOUNDATION W 44-0020

G. Asherwood.

1624-5

Typical Midship Sec + Traps Bld etc

~~163~~

Henrich V. Reidemair

Brun. 1306.

Bremer Vulkan's 694.

W/44-0020



© 2021

Lloyd's Register
Foundation