


alpha

SIR JOSEPH W. ISHERWOOD & CO. LTD.,
4, LLOYD'S AVENUE,
LONDON, E.C.3.
FOR ENCLOSURE TO
DATE 18.11.29
Genl. Vulkan
Vegorack,
Tel. No. 1624-5. Plan No. 7683
18.11.29.

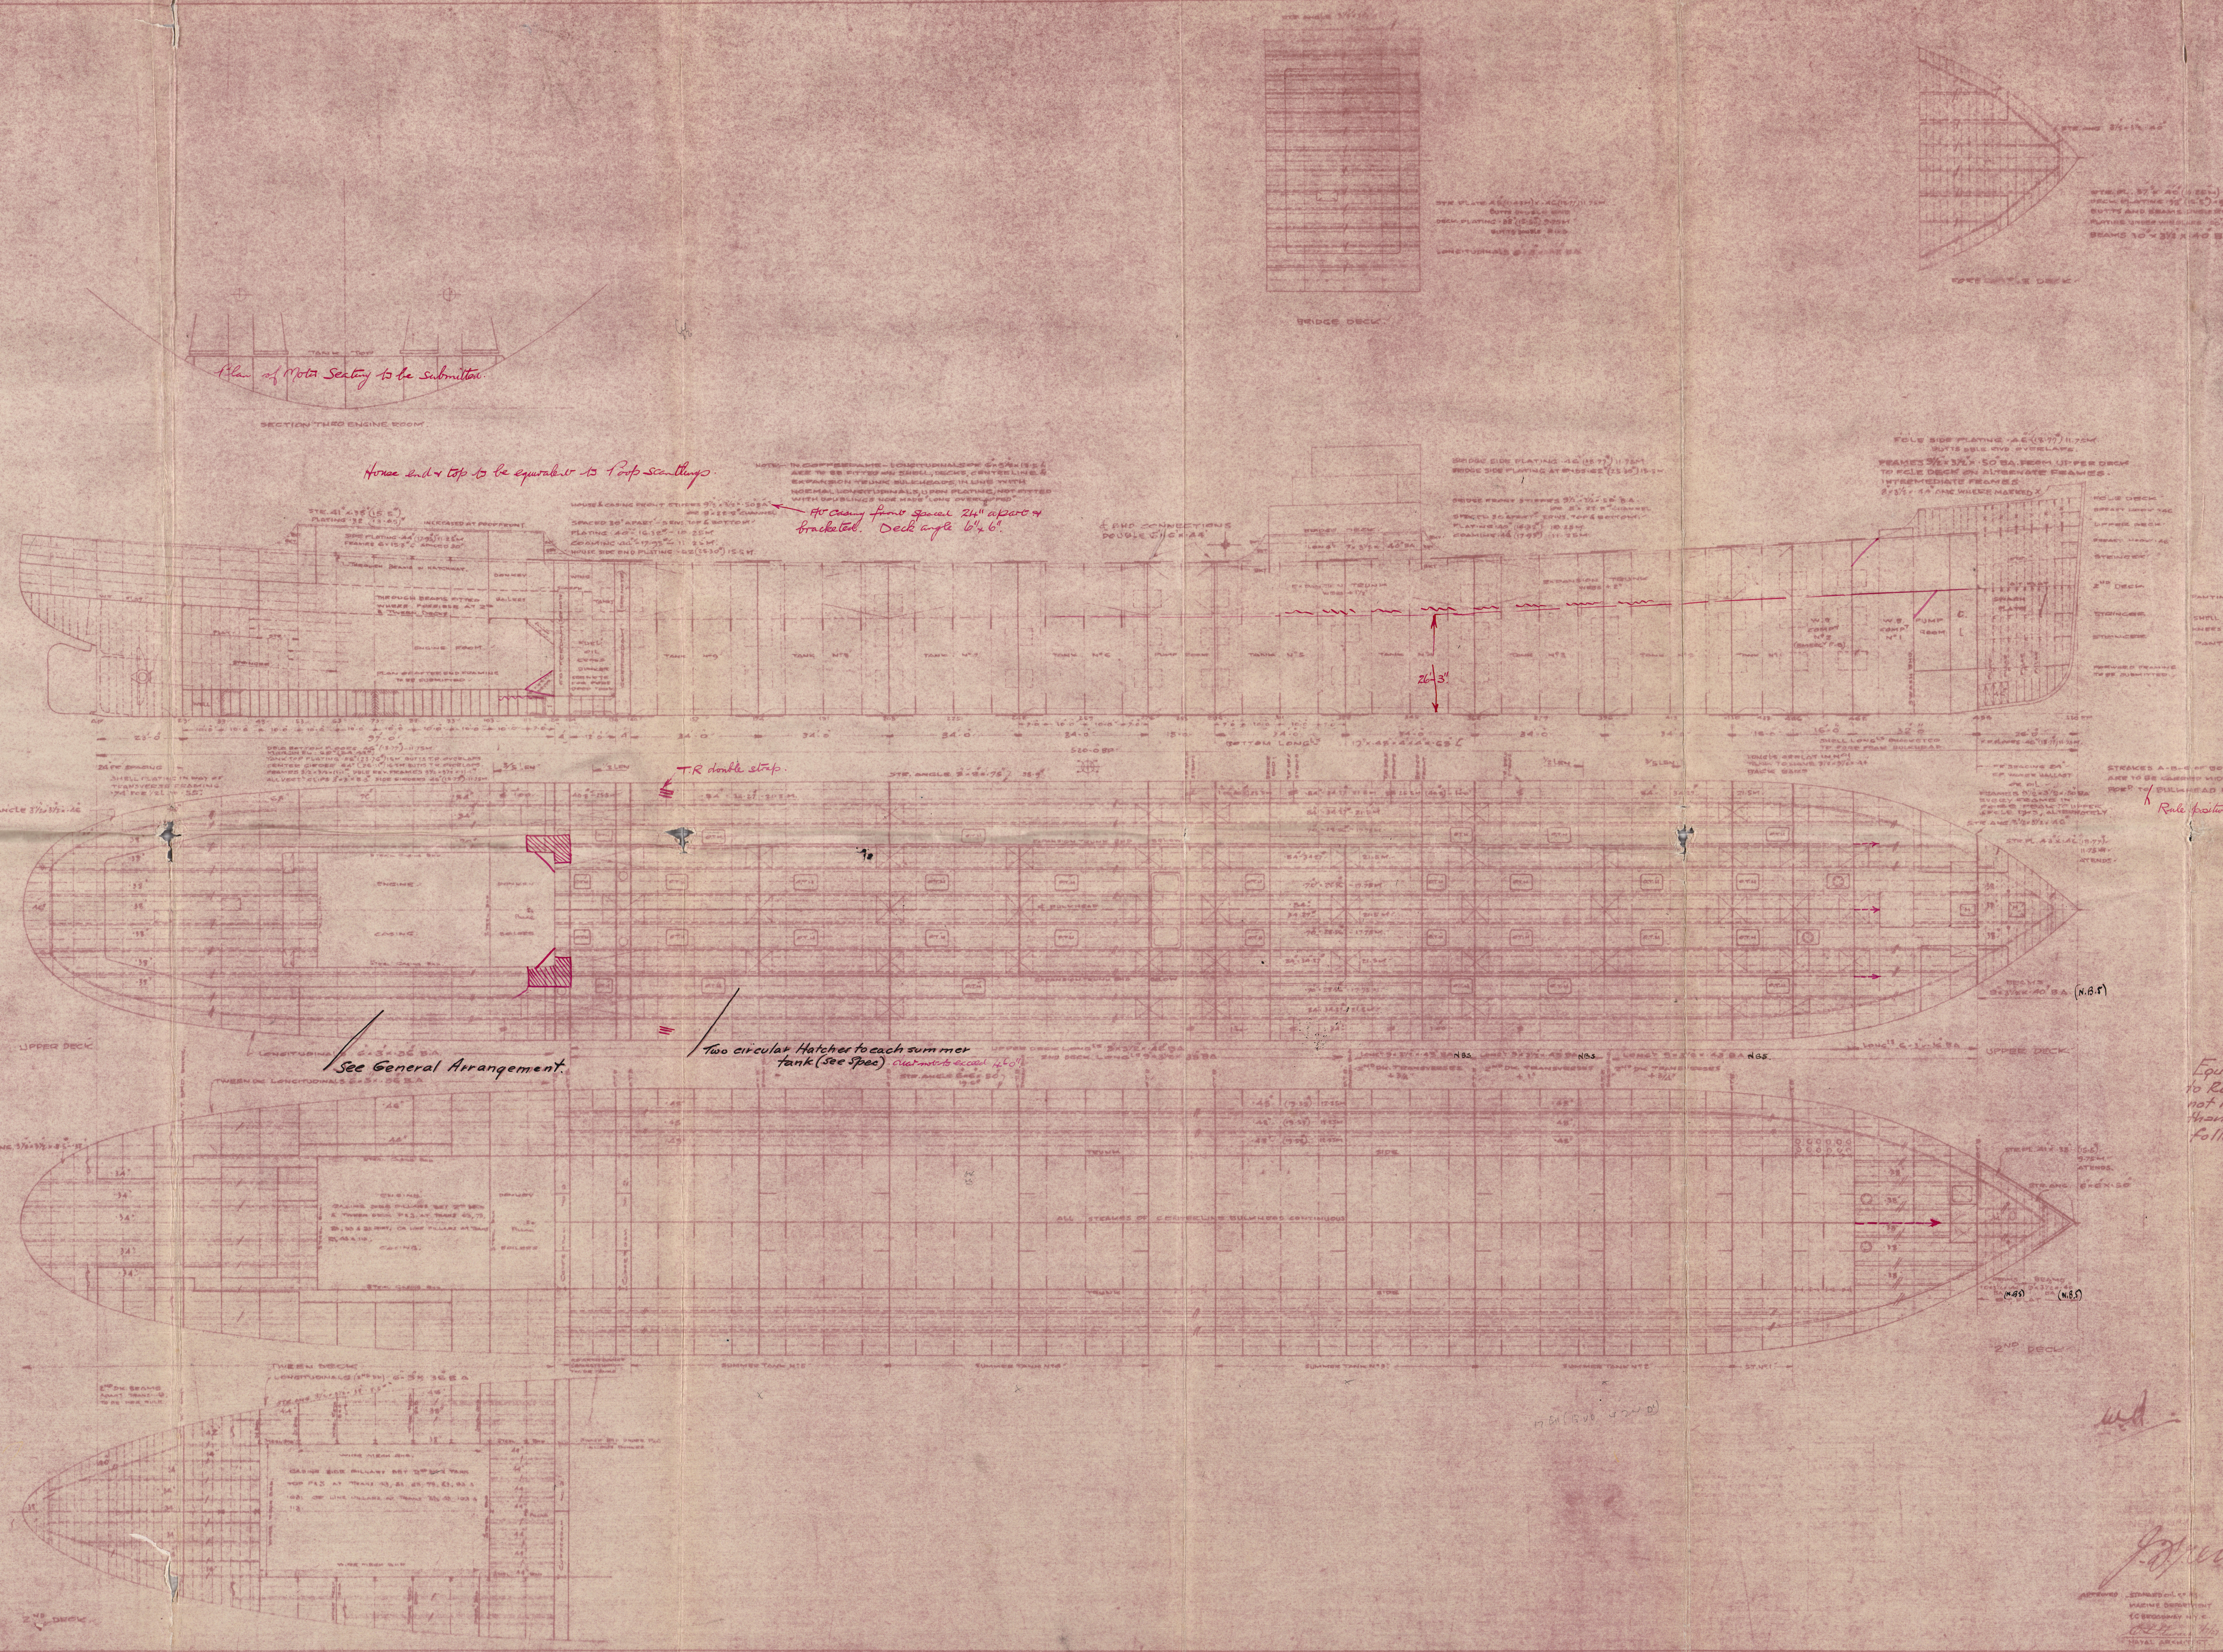

EQUIPMENT NUMBERS

L(8+9)	52550
CELE	48577
BRIDGE	48578
POOPHOUSE SHEET	54775
ART HOUSE	45776
BRIDGE OF HOOD	45777
	57590-6

Equipment to Rule, and not less than the following

16 equipment to be submitted

Heinrich V. Reudeman
June 1906

CLASSIFICATION PROFILE AND DECK PLANS.

TWIN SCREW BULKHEAD CARRYING MOTORSHIP DESIGN SOCIETY'S

DIMENSIONS

188' 0"	188' 0"
11' 11"	11' 11"
11' 11"	11' 11"

ISHERWOOD'S BRACKETLESS SYSTEM (PATENT)

18.11.29

Heinrich

Isherwood.

1624/5

Class Profile + PK Plans

GEN BOX NO 163