


REVISED DETAIL OF BASEPLATES & JOINTS FOR 4'-6" DIA. & 5'-0" DIA. CLARKSON BOILERS.

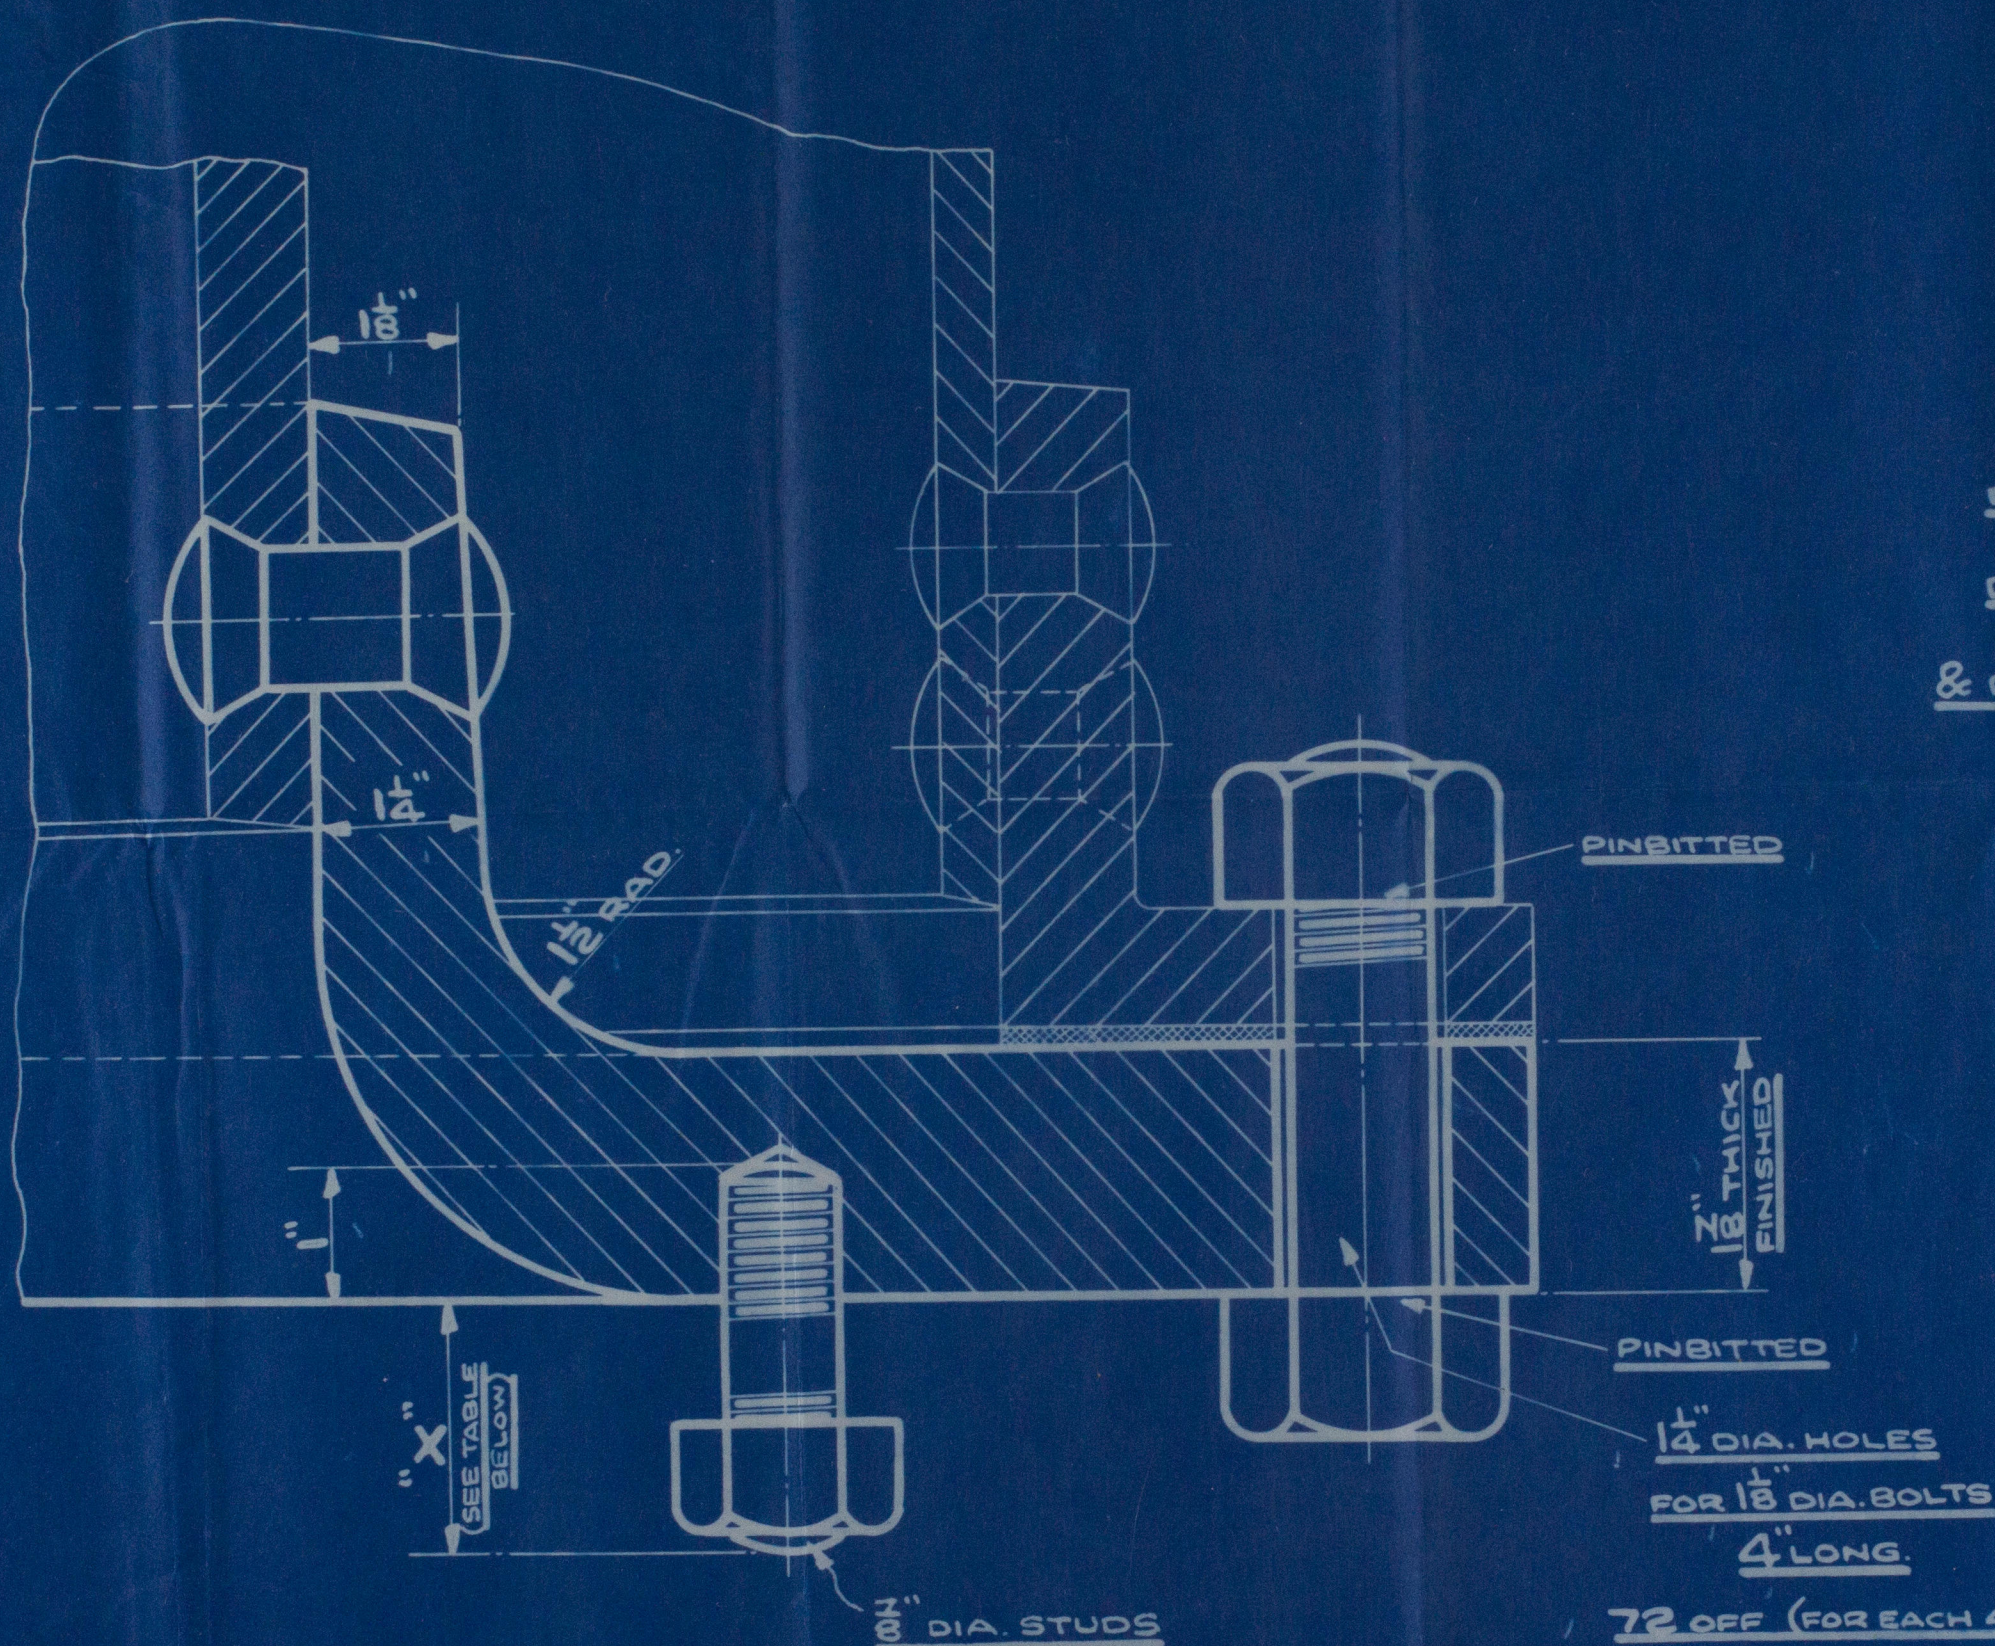

ORDER NO	DIA. OF BOILER	"X"
3208 & 3209	4'-6"	1 7/8"
2943 & 2944	5'-0"	1 7/8"
3126 & 3127	5'-0"	1 1/2"

28 OFF (FOR EACH 4'-6" BOILER)
30 OFF (" " 5'-0" ")

72 OFF (FOR EACH 4'-6" DIA. BOILER)
78 " (" " 5'-0" ")

ORDER NO	REQUIRED	REMARKS
2943 & 2944	5'-0" DIA. BOILERS (2 OFF) CONTRACT 410/411 {CANTIERE NAVALE}	THE CLARKSON THIMBLE TUBE BOILER CO LTD
3126 & 3127	5'-0" DIA. BOILERS (2 OFF) CONTRACT 408/409 {BREMER VULKAN}	" " " " "
3208 & 3209	4'-6" DIA BOILERS (2 OFF) CONTRACT 412/413 {KRUPPE}	" " " " "

FOR ORIGINAL DETAILS OF JOINTS SEE
DRAWING NO 10214.A. (5'-0" DIA. BOILERS)
& DRAWING NO 10221 (4'-6" DIA. BOILERS)



SCALE: 9"=1 FOOT

10/44-0028

17/9/30
N^o 102229

Sheffie

Spec. No. 425.

Davy Bros.

Boilers No. 3126 87.

Amended plan of
base plates.

Heinrich V. Riedman.

Bum 1306.

W44-0028



© 2021

Lloyd's Register
Foundation