

MIDSHIP SECTION.

N^os 437-8.

— Dimensions as per Rule —


LENGTH..... 363.00
BREADTH..... 50.79
DEPTH..... 28.75

— CLASS 100A.1. —

JOHN READHEAD & SONS, LD.,
SHIPBUILDERS &C.,
SOUTH SHIELDS.


— NUMERALS —
50.79 10.1 DEPTHS TO B.D.
28.75 12.6 " " U.D.
79.54 TRANS. NO. $\alpha = 25.33'$
363
28873 LONG. NO.

11. 10. 12
31. 1. 13

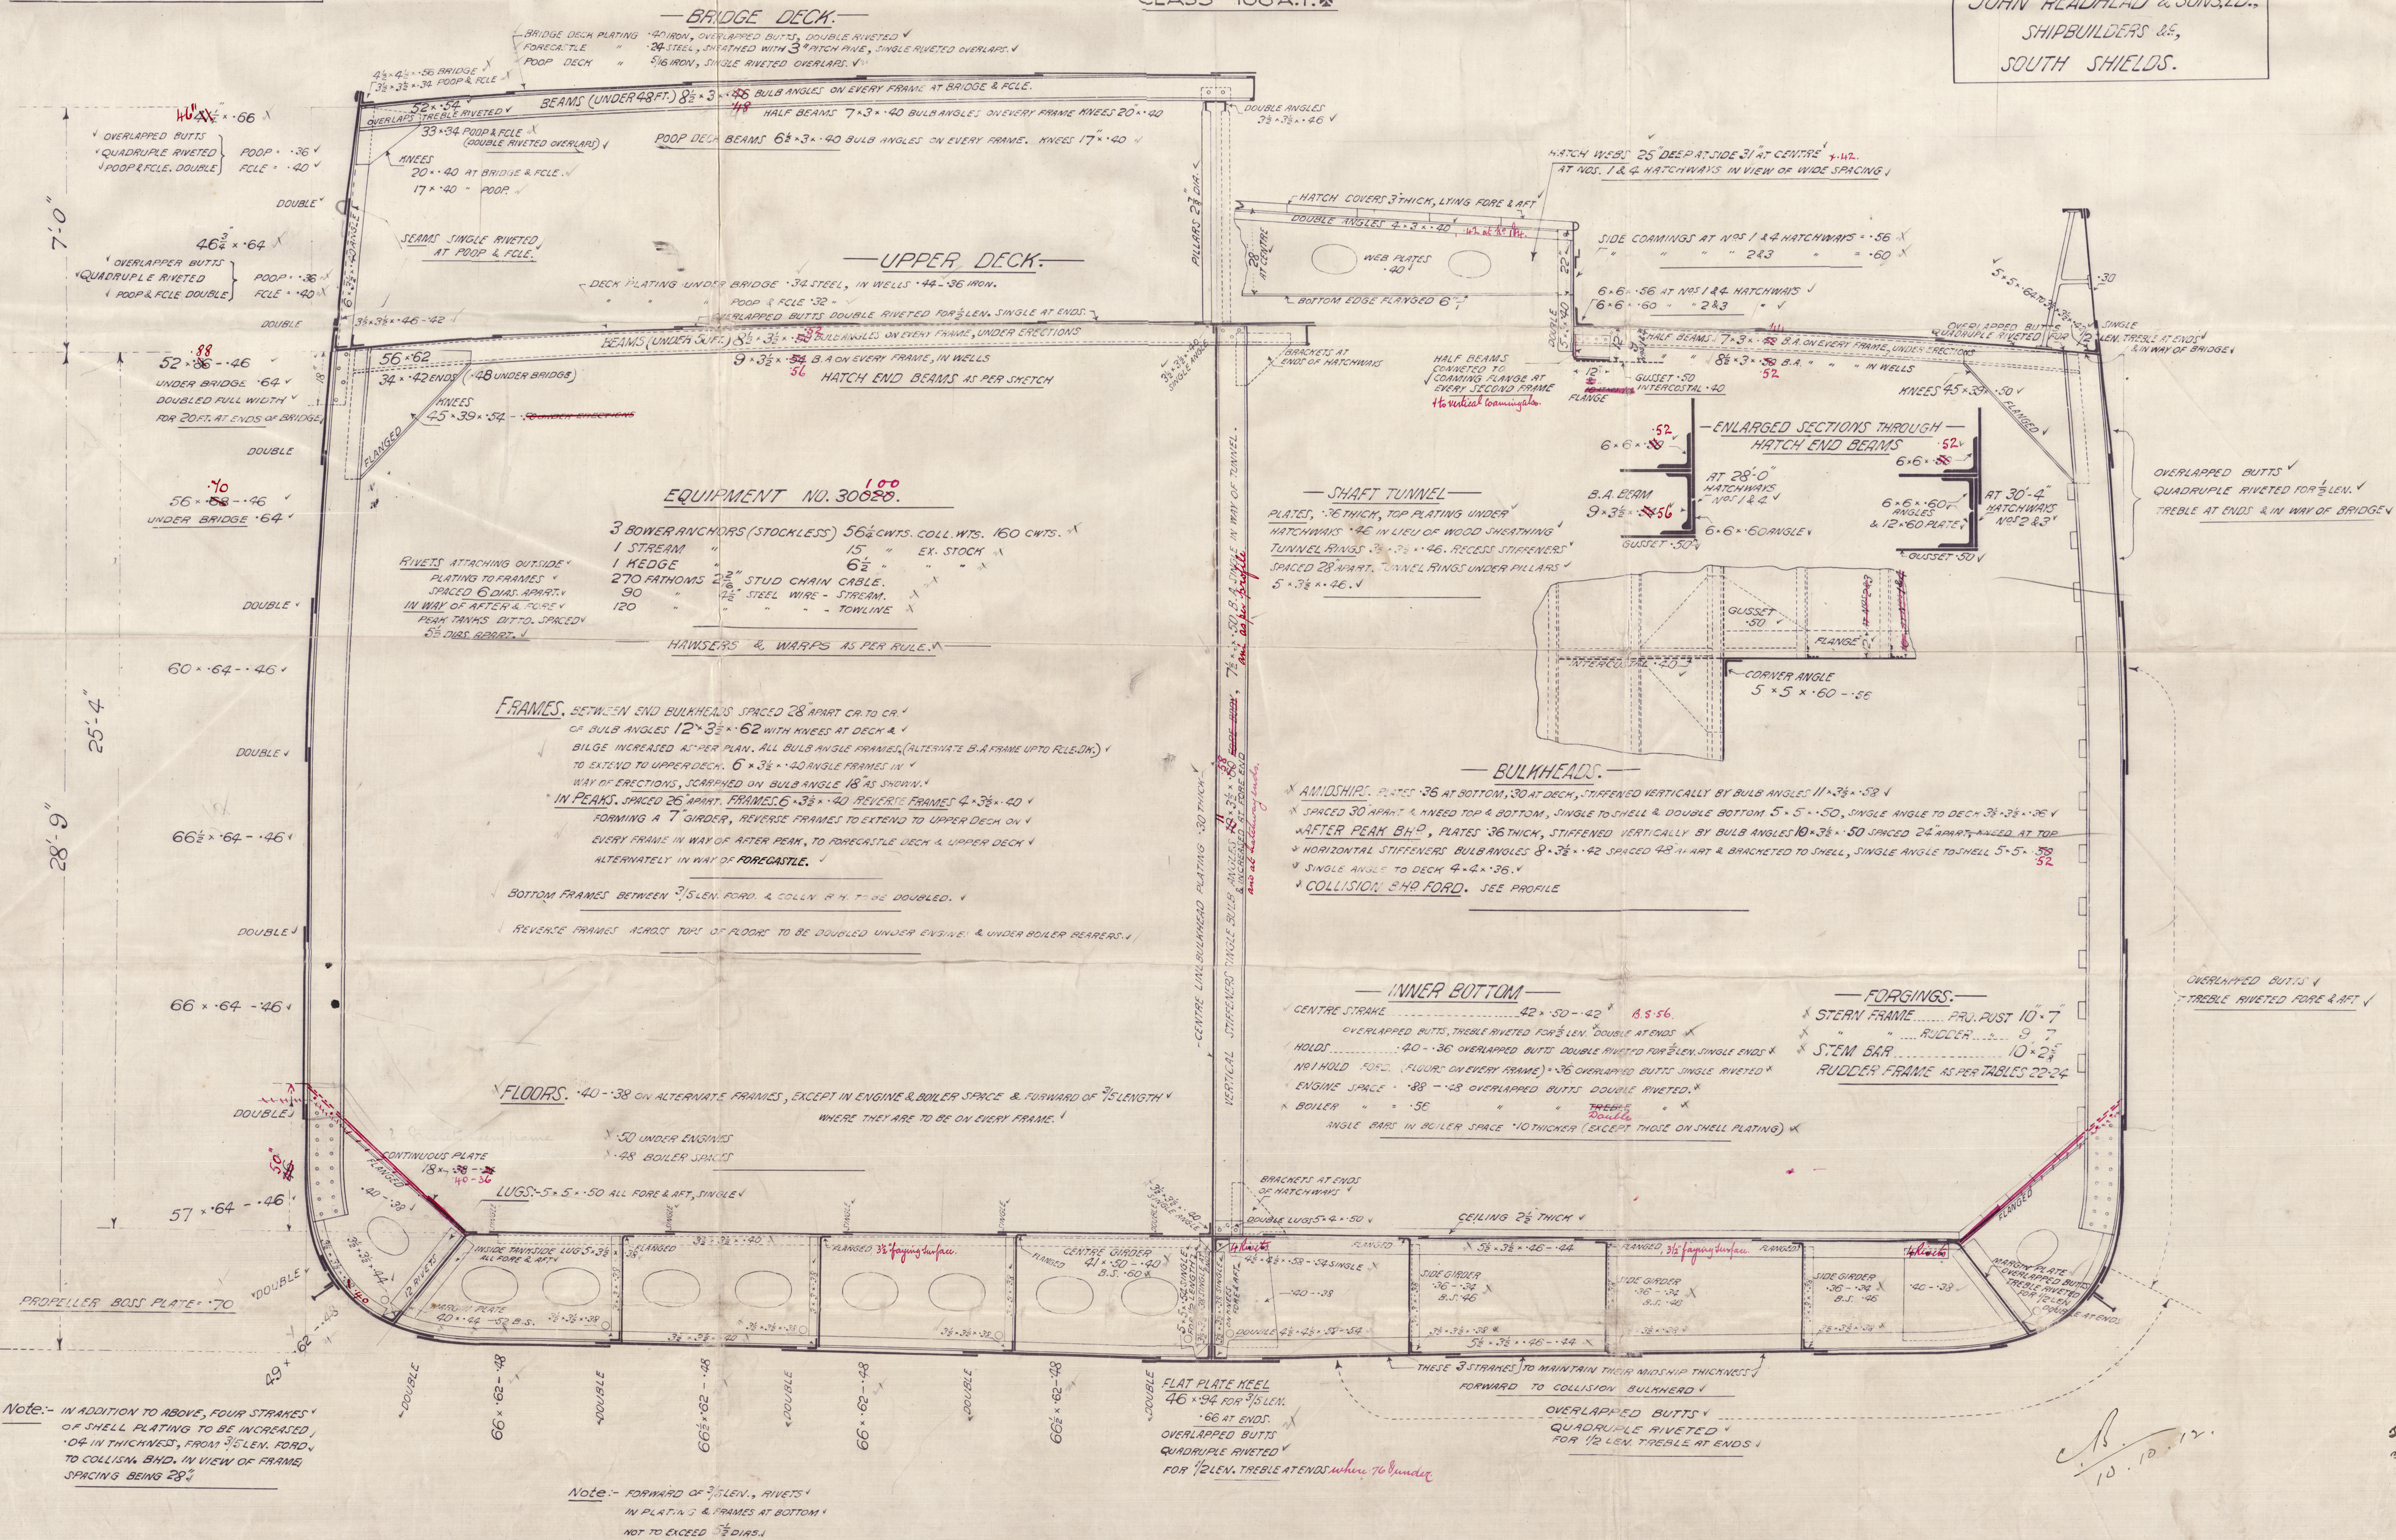

J Read head & Sons

No 43788

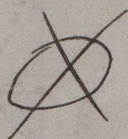


Section

437 S/s. "Brownian" Nwc. Rpt
No

NEWCASTLE-ON-TYNE

Report No 65202

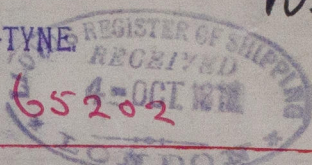


Hogland

438. SS.

ONWEN

NWC. RPT. 65453.

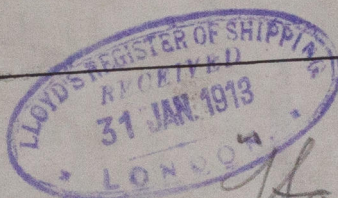

Hogland



W44-0093



© 2021

Lloyd's Register
Foundation