


SHIP NO. 575.  
S. S. "HENRY KESWICK".  
STEEL TWIN SCREW OCEAN GOING TOW BOAT.  
GENERAL ARRANGEMENT.

LENGTH OVERALL 173' 9"  
LENGTH BETWEEN PERP<sup>S</sup> 165' 0"  
BREADTH MOULDED 34' 0"  
DEPTH MOULDED 17' 0"  
SCALE 4"=ONE FOOT.

TONNAGE  
GROSS (INCLUDING LIGHT & AIR) 671 1/2 TONS  
UNDER DECK 535 3/4 TONS  
REGISTER NET 52 2/3 TONS

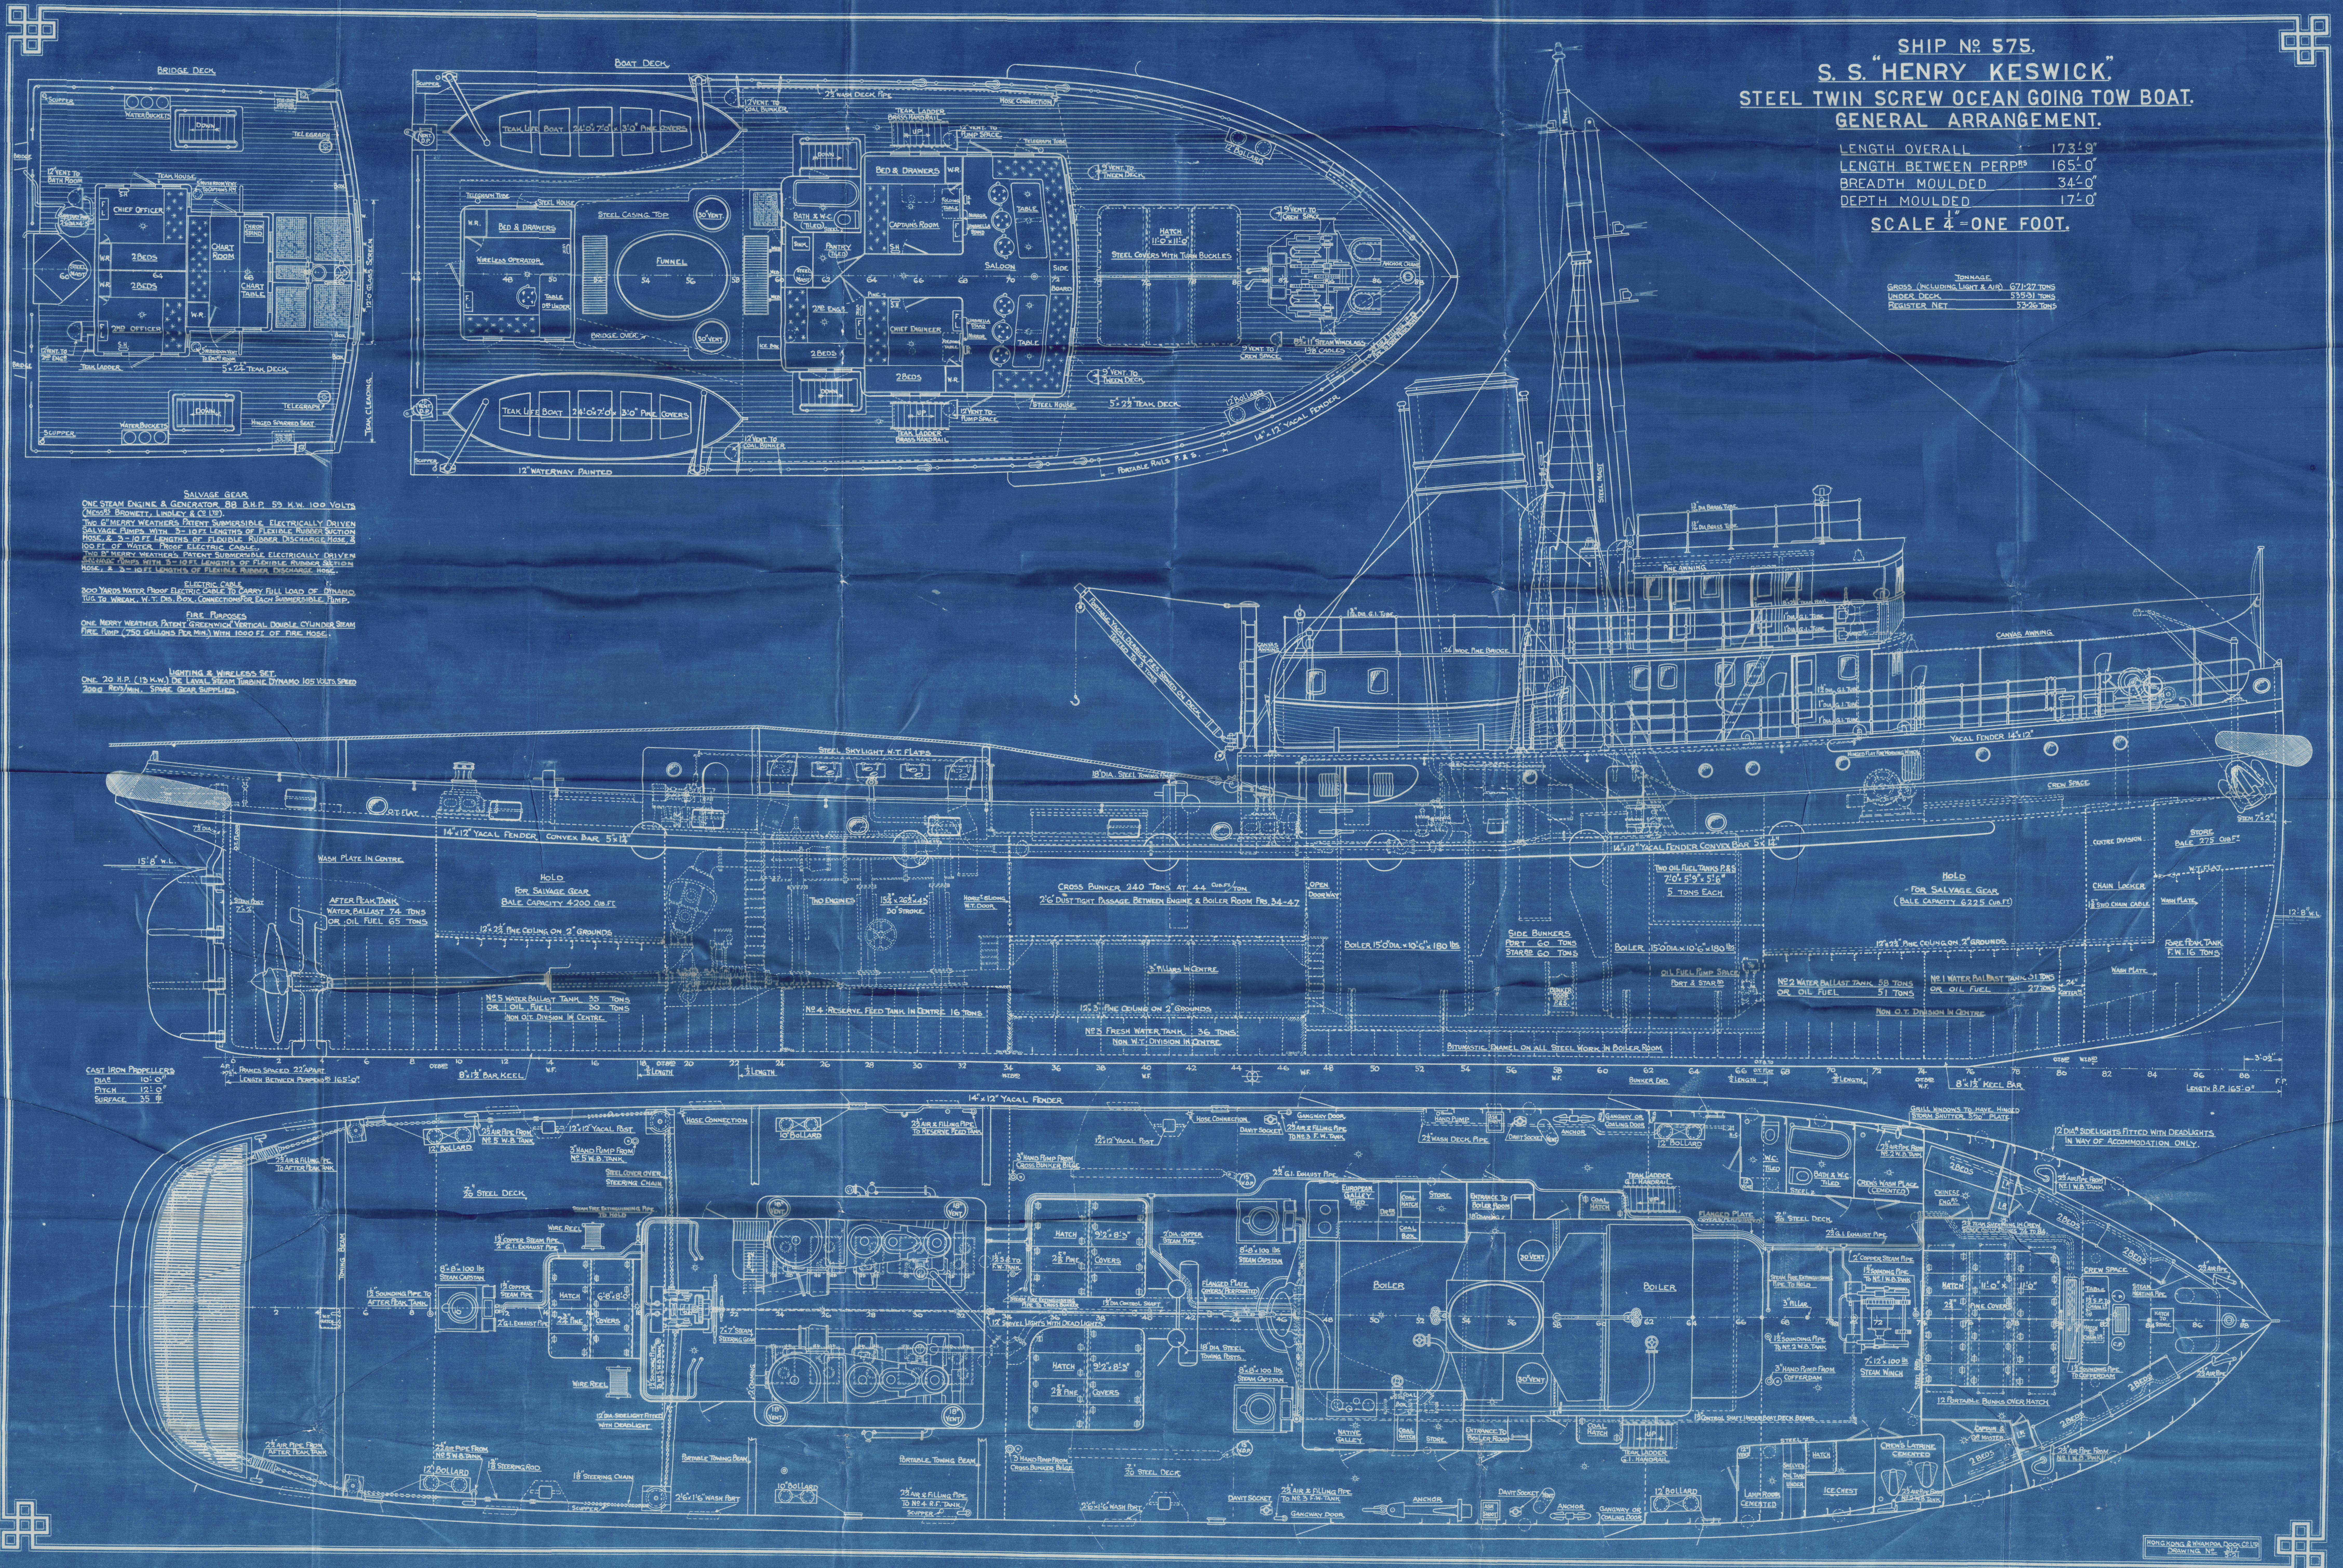

**SALVAGE GEAR**  
ONE STEAM ENGINE & GENERATOR, 50 H.P., 59 H.V. 100 VOLTS (MORSE, BROWN, LINDLEY & CO. LTD.)  
TWO 6" MERRY WEATHERS PATENT SUBMERSIBLE ELECTRICALLY DRIVEN SALVAGE PUMPS, WITH 3" 10 FT LENGTHS OF FLEXIBLE RUBBER DISCHARGE HOSE, & 3" 10 FT LENGTHS OF FLEXIBLE RUBBER DISCHARGE HOSE, & 100 FT OF WATER TIGHT PROTECTIVE CABLES, ELECTRICALLY DRIVEN  

**ELECTRIC CABLE**  
300 YARDS WATER PROOF ELECTRIC CABLE, TO CARRY FULL LOAD OF DYNAMO 100 TO 1000 W.T. D.S. BOX CONNECTIONS FOR EACH SUBMERSIBLE PUMP.

**FIRE PROTECTORS**  
ONE MERRY WEATHER PATENT SUBMERSIBLE VERTICAL CYLINDER BEAM FIRE PUMP (750 GALLONS PER MIN) WITH 1000 FT. OF FIRE HOSE.

**LIGHTING & WIRELESS SET.**  
ONE 20 H.P. (12 H.V.) DIE LAVAL STEAM TURBINE DYNAMO 105 VOLTS SPEED 2000 REV. MIN. SPARK GAP SUPPLY.

**CAST IRON PROTECTORS**  
DIA. 10" 0"  
PITCH 12" 0"  
SURFACE 35"



PROFILE & GEN. ARRT

AS. BUILT.

Turn Screw Lug. HENRY KESWICK


Hong Kong Whampoa Dock Co

Yard No. 575

Hg. Kg. 5138.

14/6/21

W44-0110

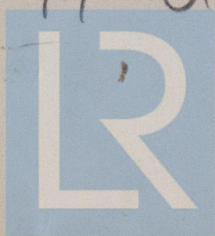

© 2021

Lloyd's Register  
Foundation