






# OERTZ - PATENT - RUDDER

FOR

SS. "IONIC STAR"

Speed under 12 knots

SCALE  $\frac{3}{4}$ " = 1 FOOT.

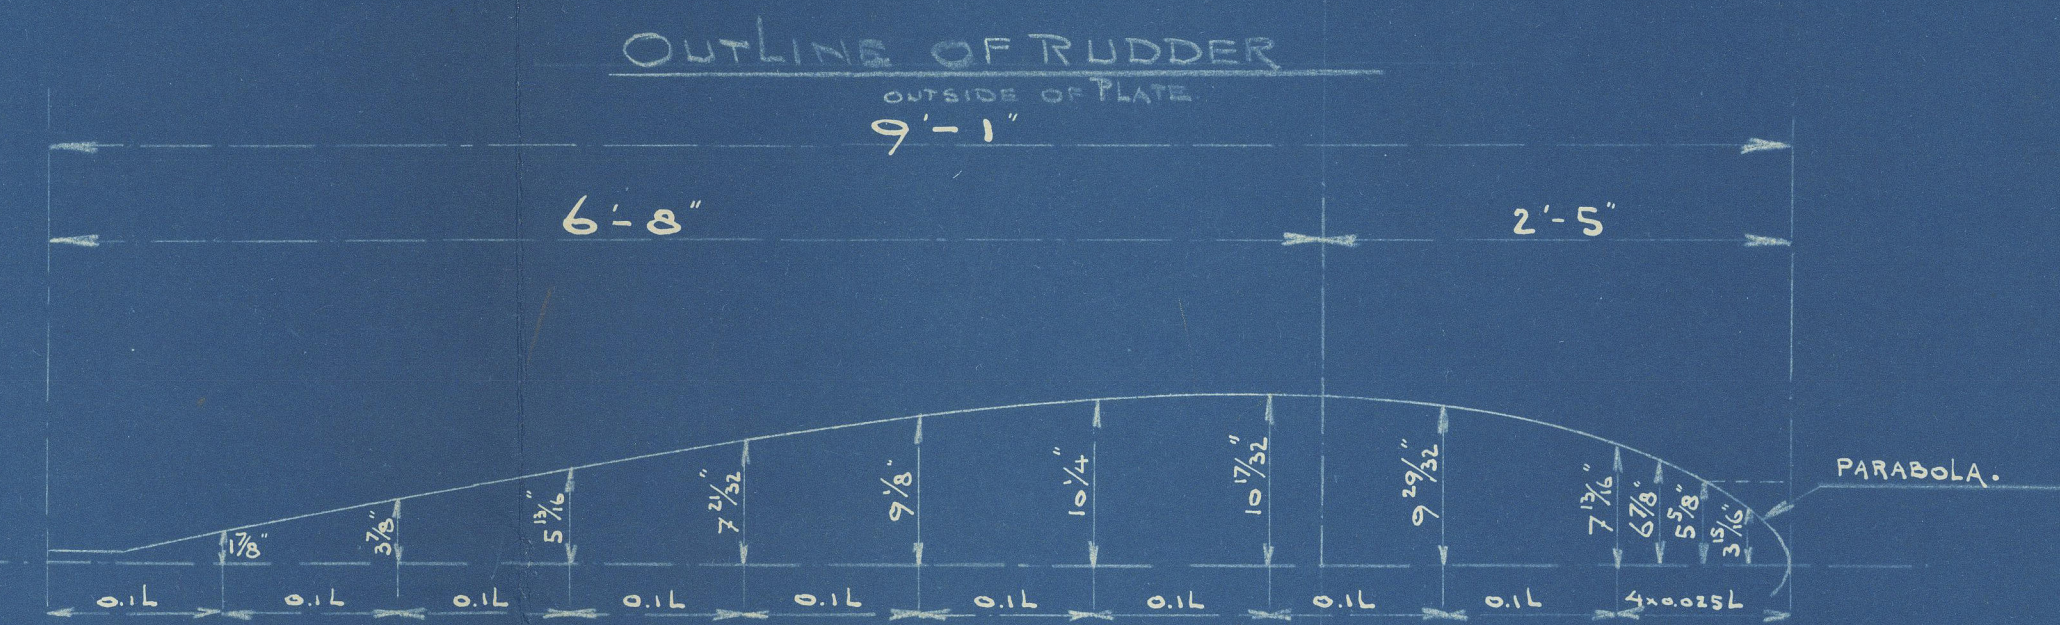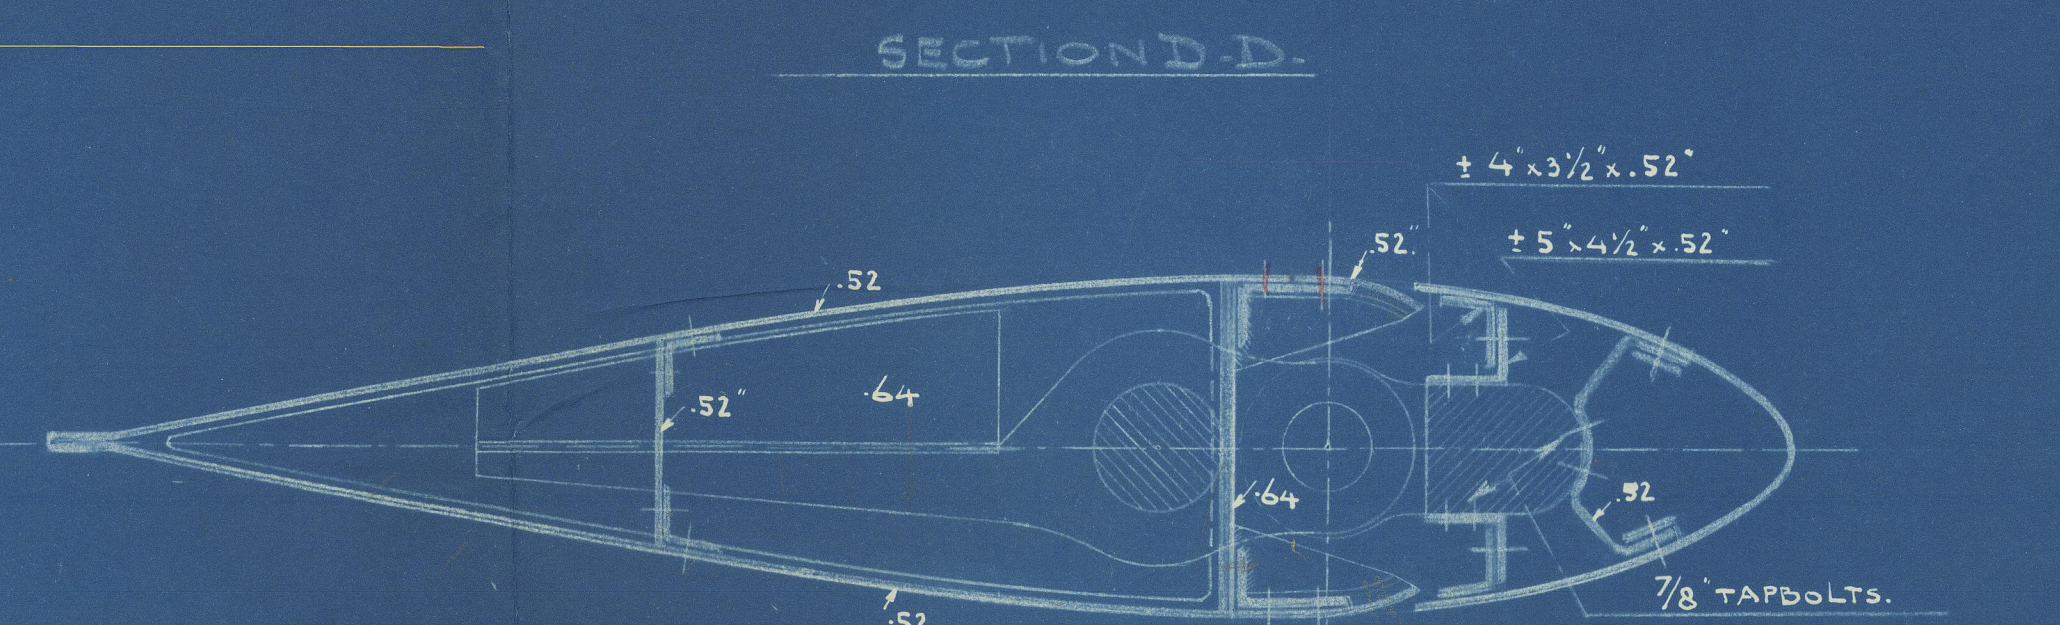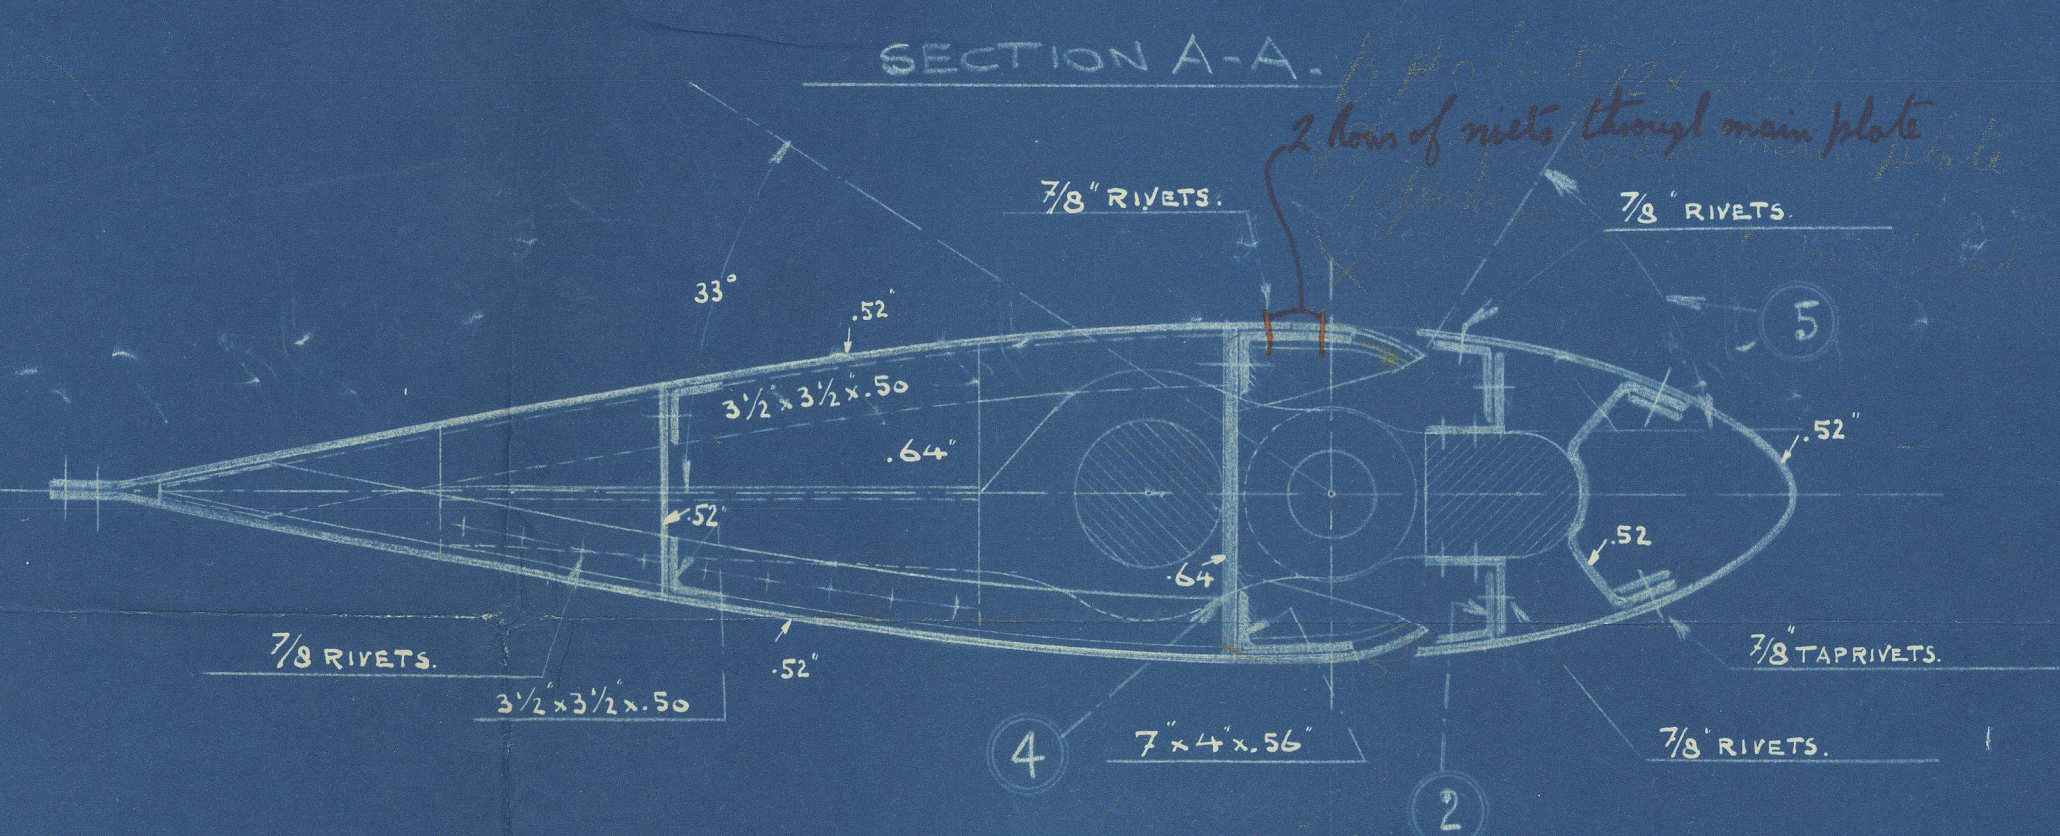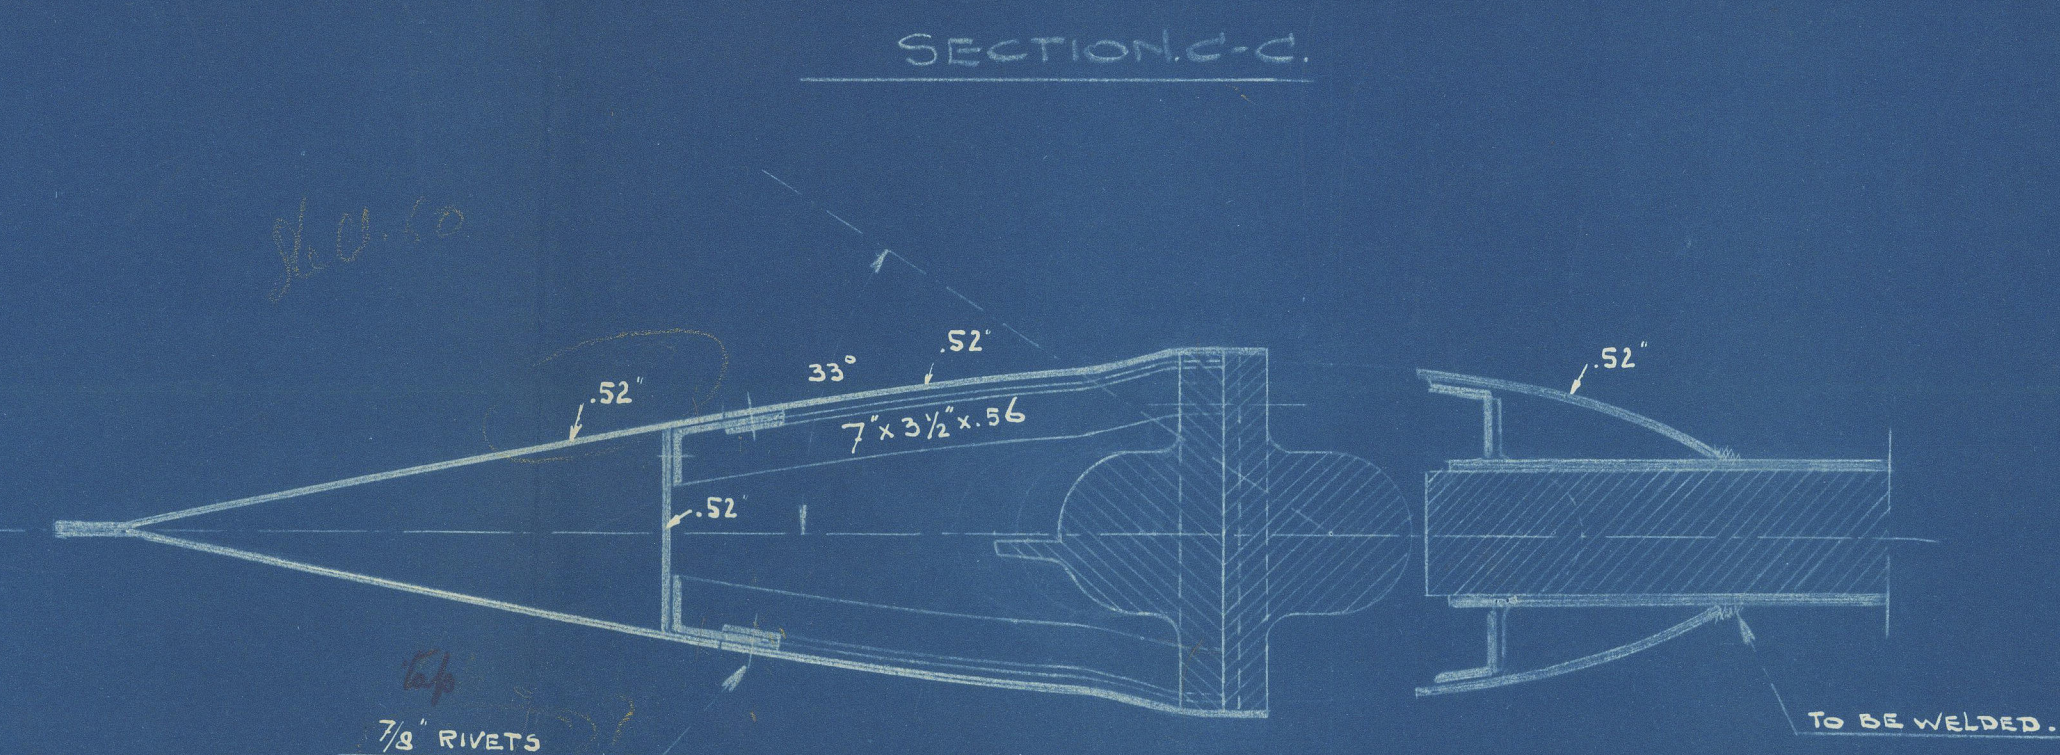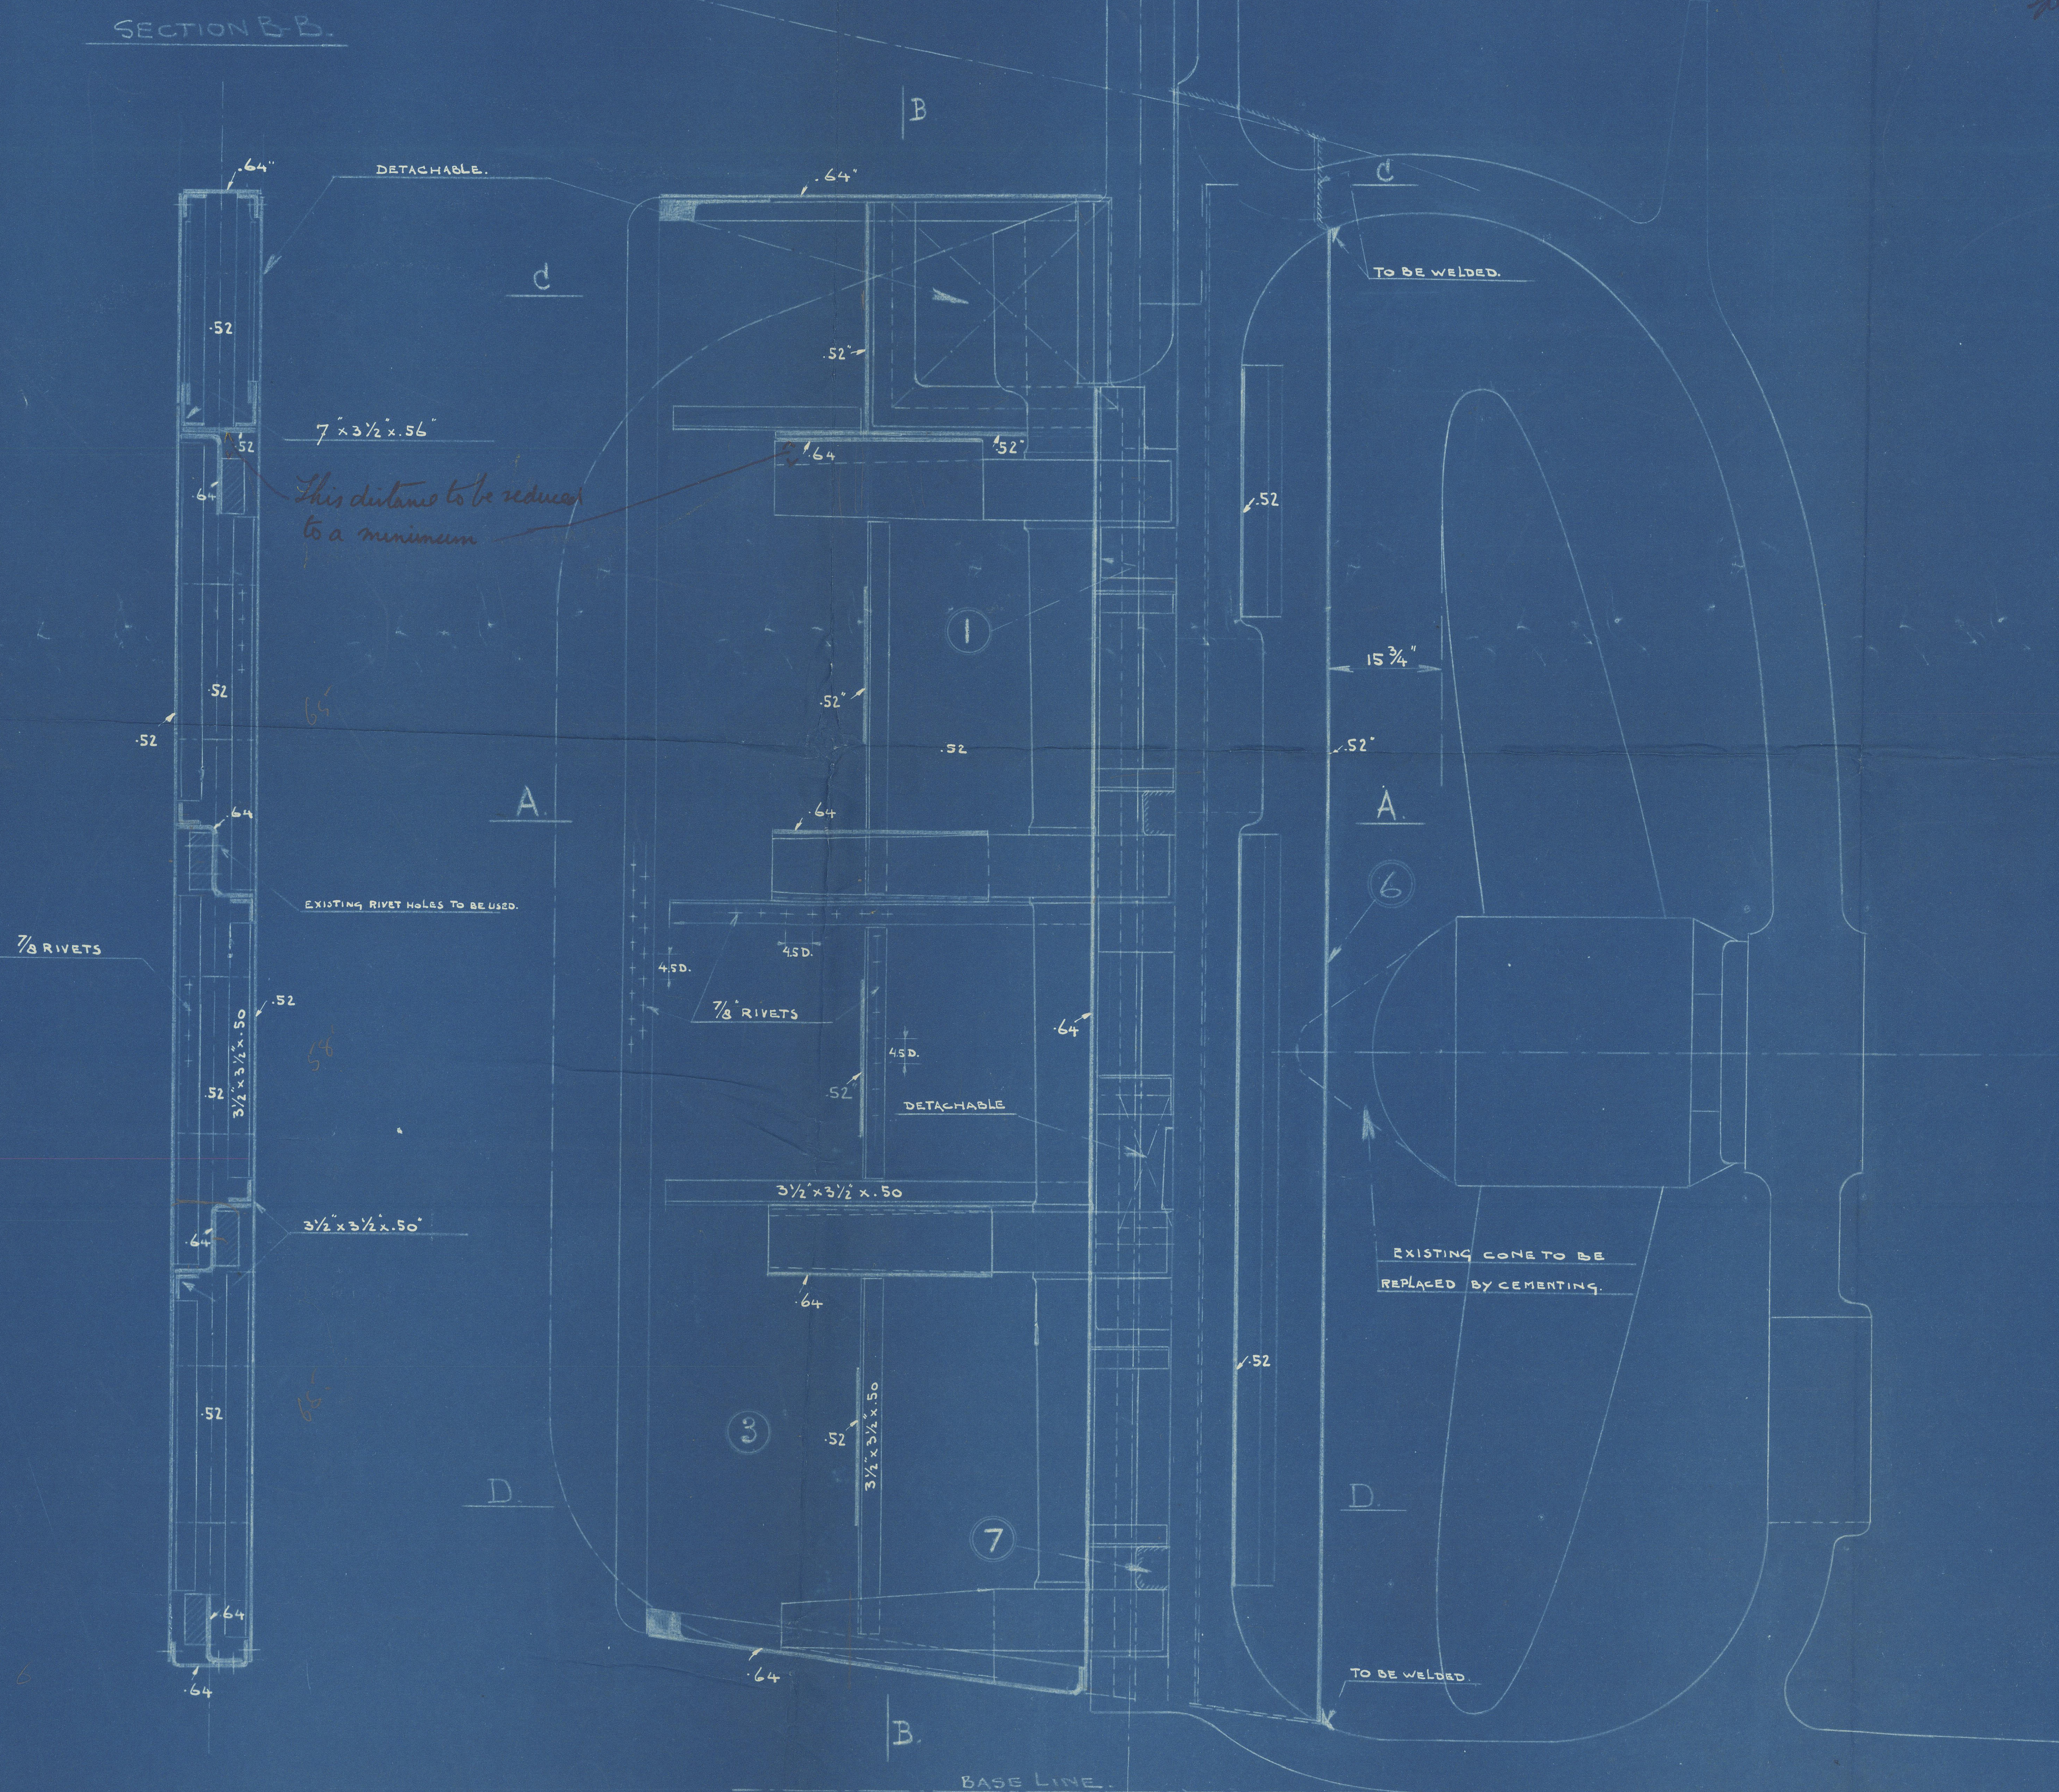



IONIC STAR  
EX  
RUBIERA

M.M. Box 440

RUDDER

WH40-0006



© 2021

Lloyd's Register  
Foundation