



931


POOP DECK.

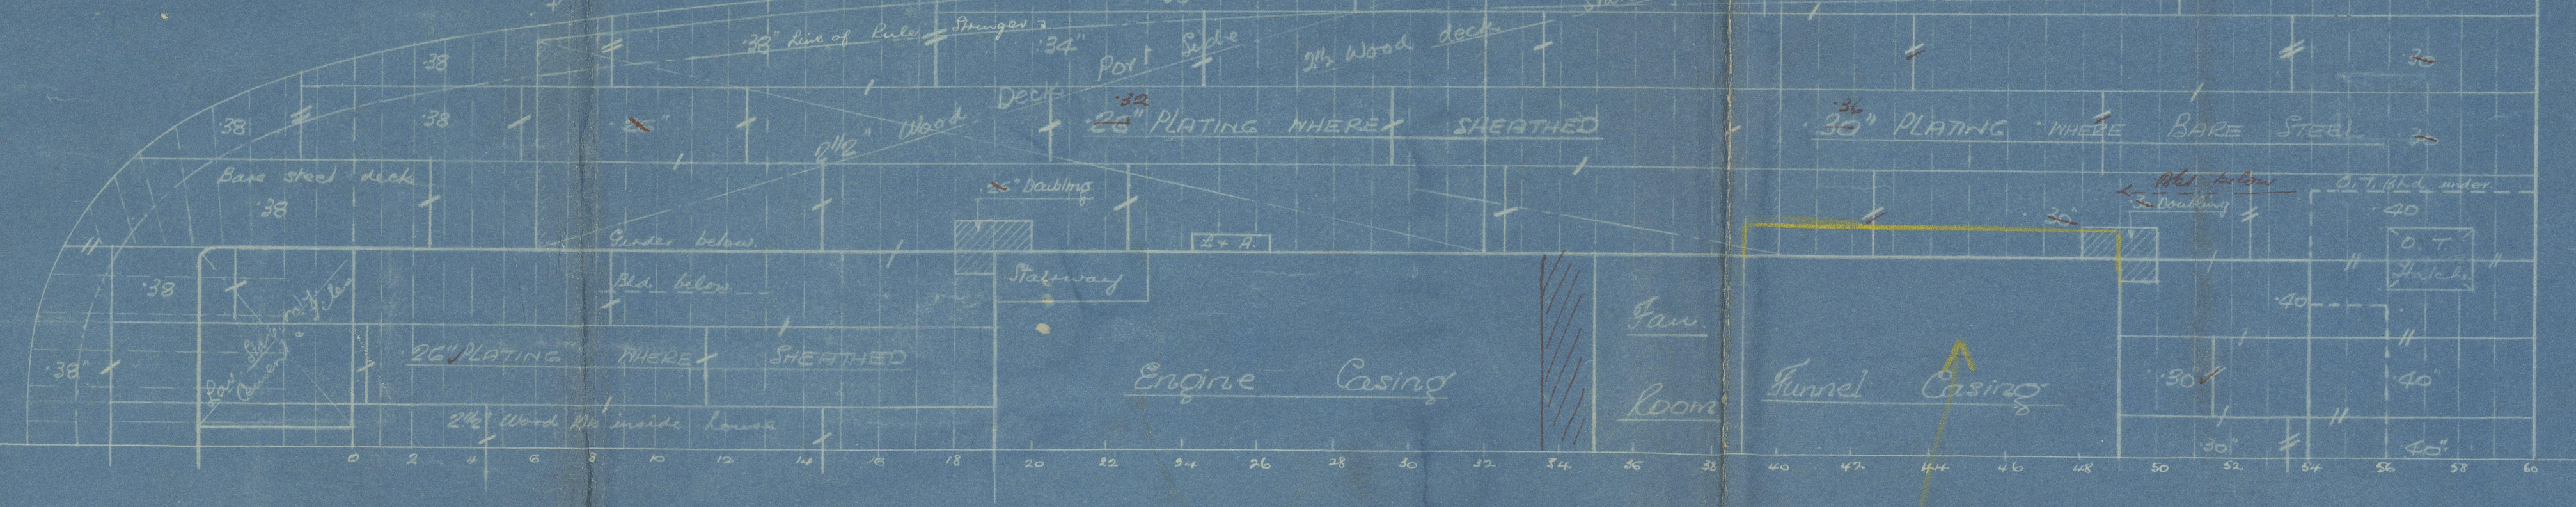


UPPER DECK.

 


MAIN DECK.

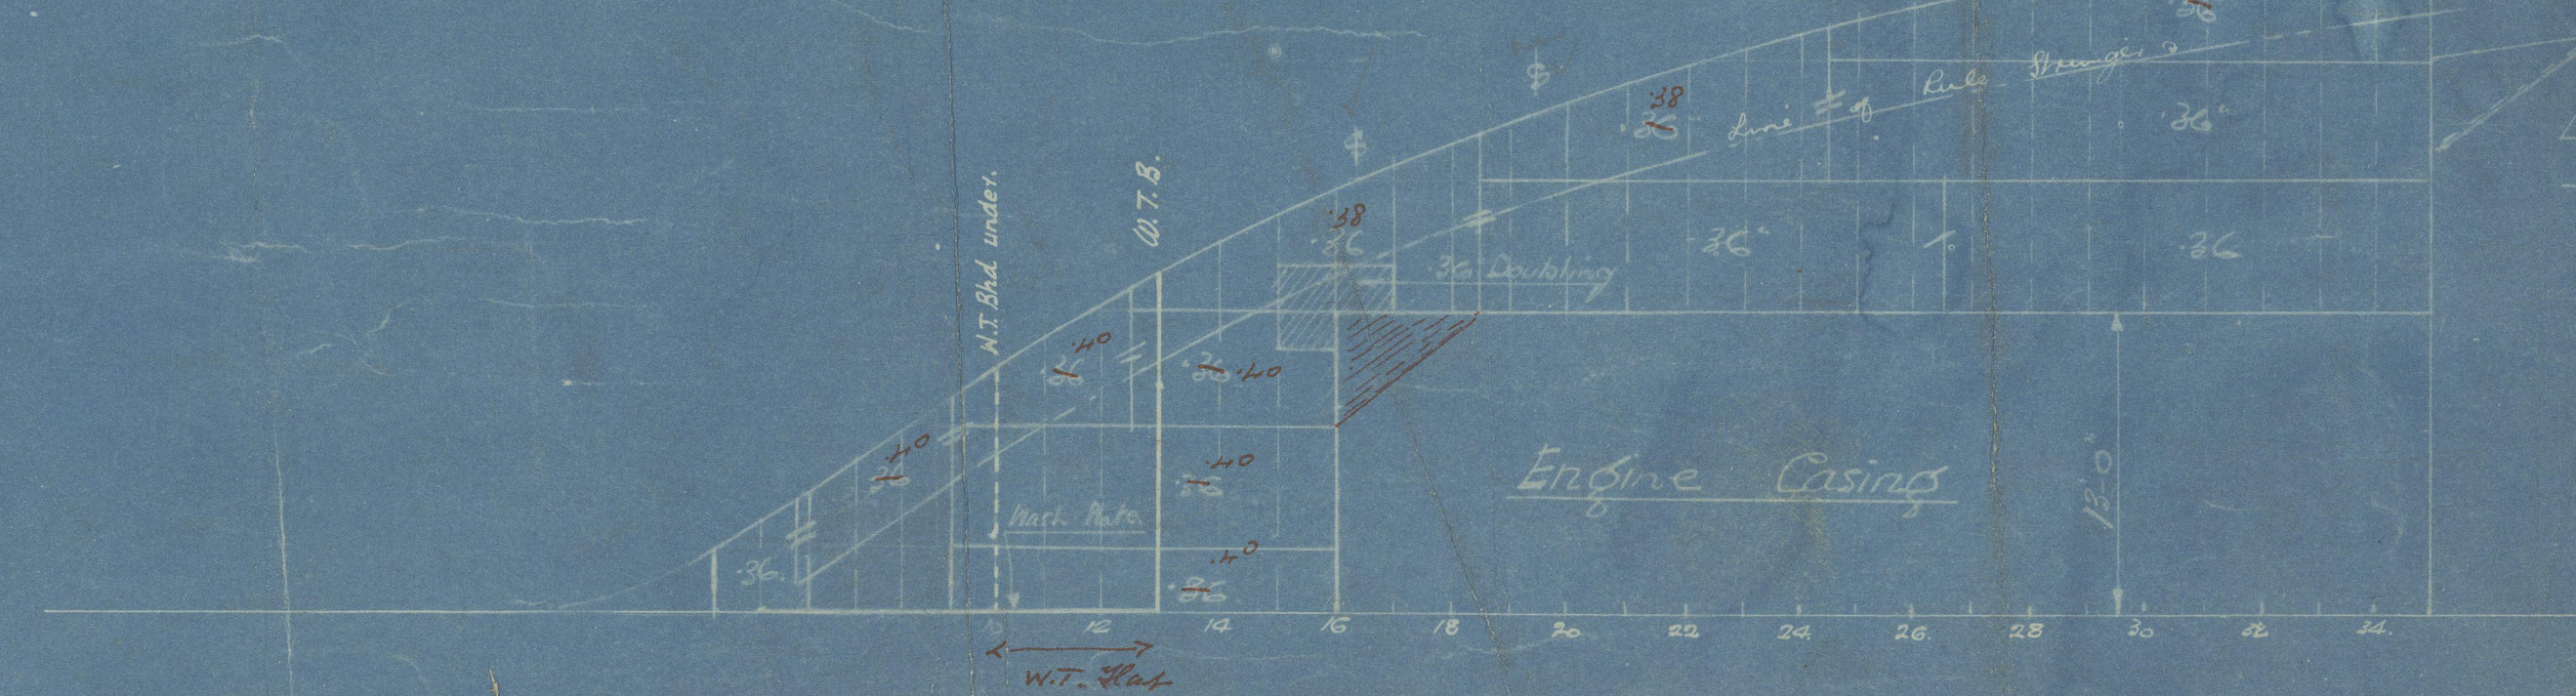


DYNAMO FLAT

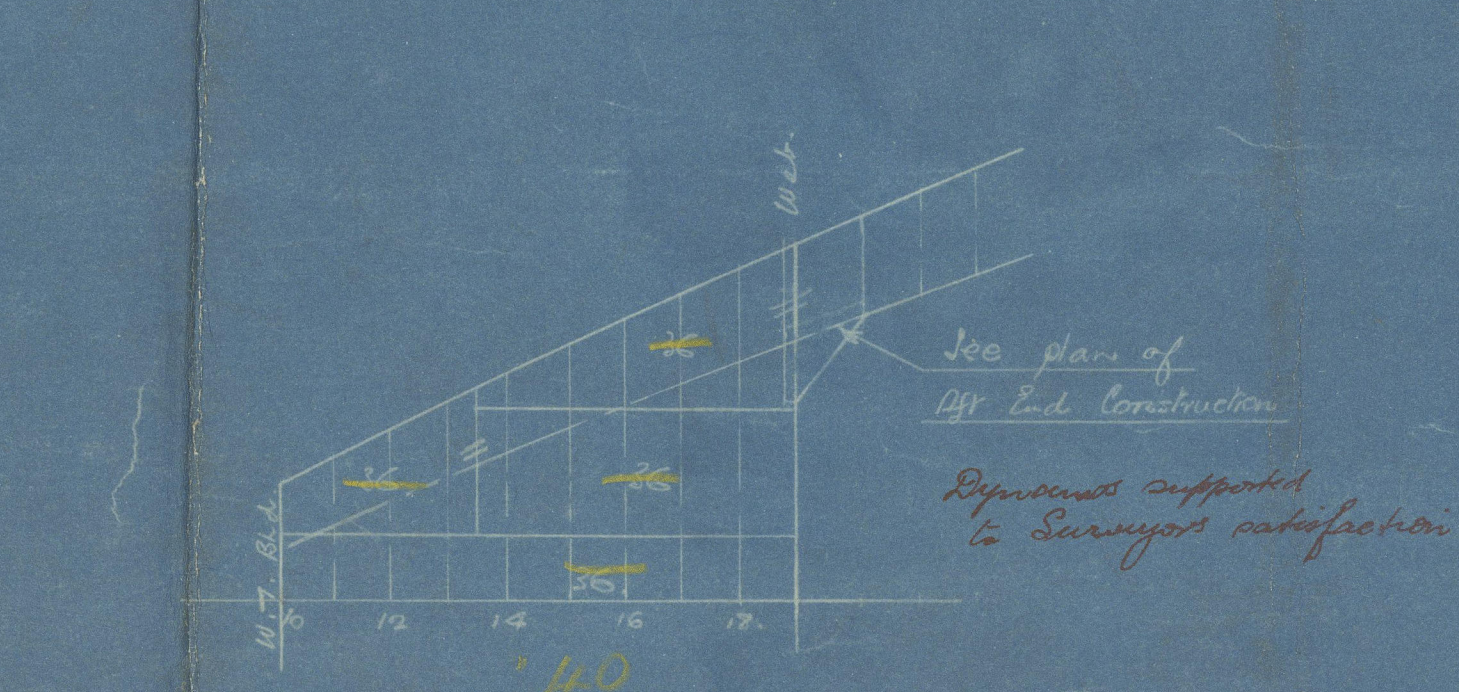


BRIDGE DECK

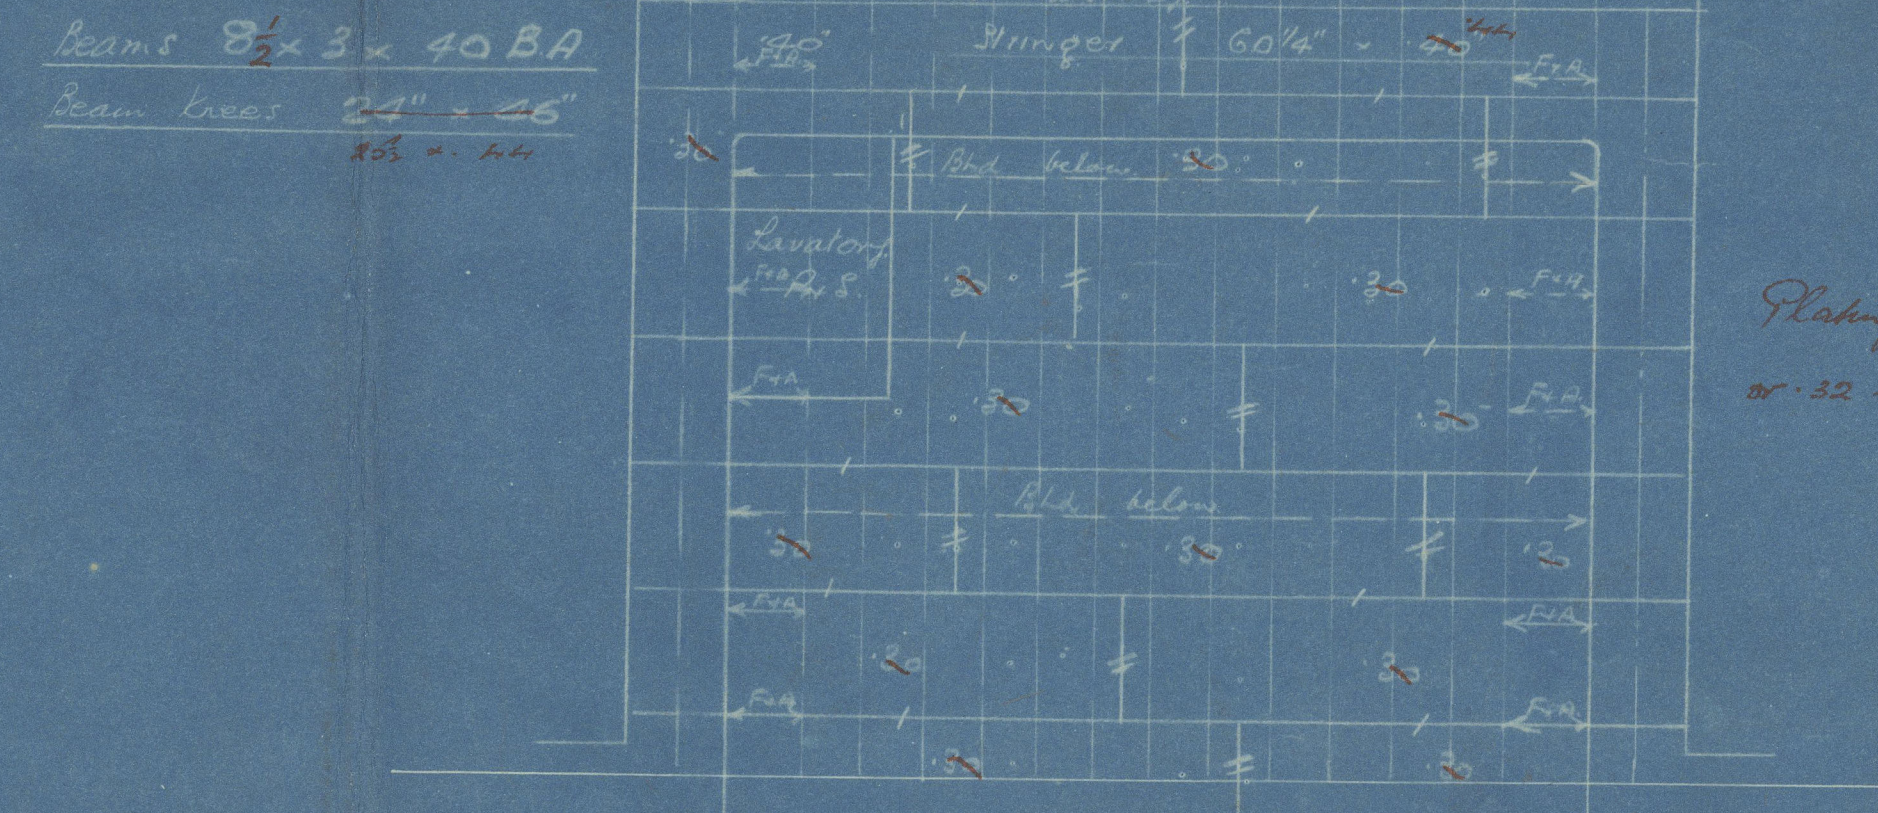


NO 1 TANK

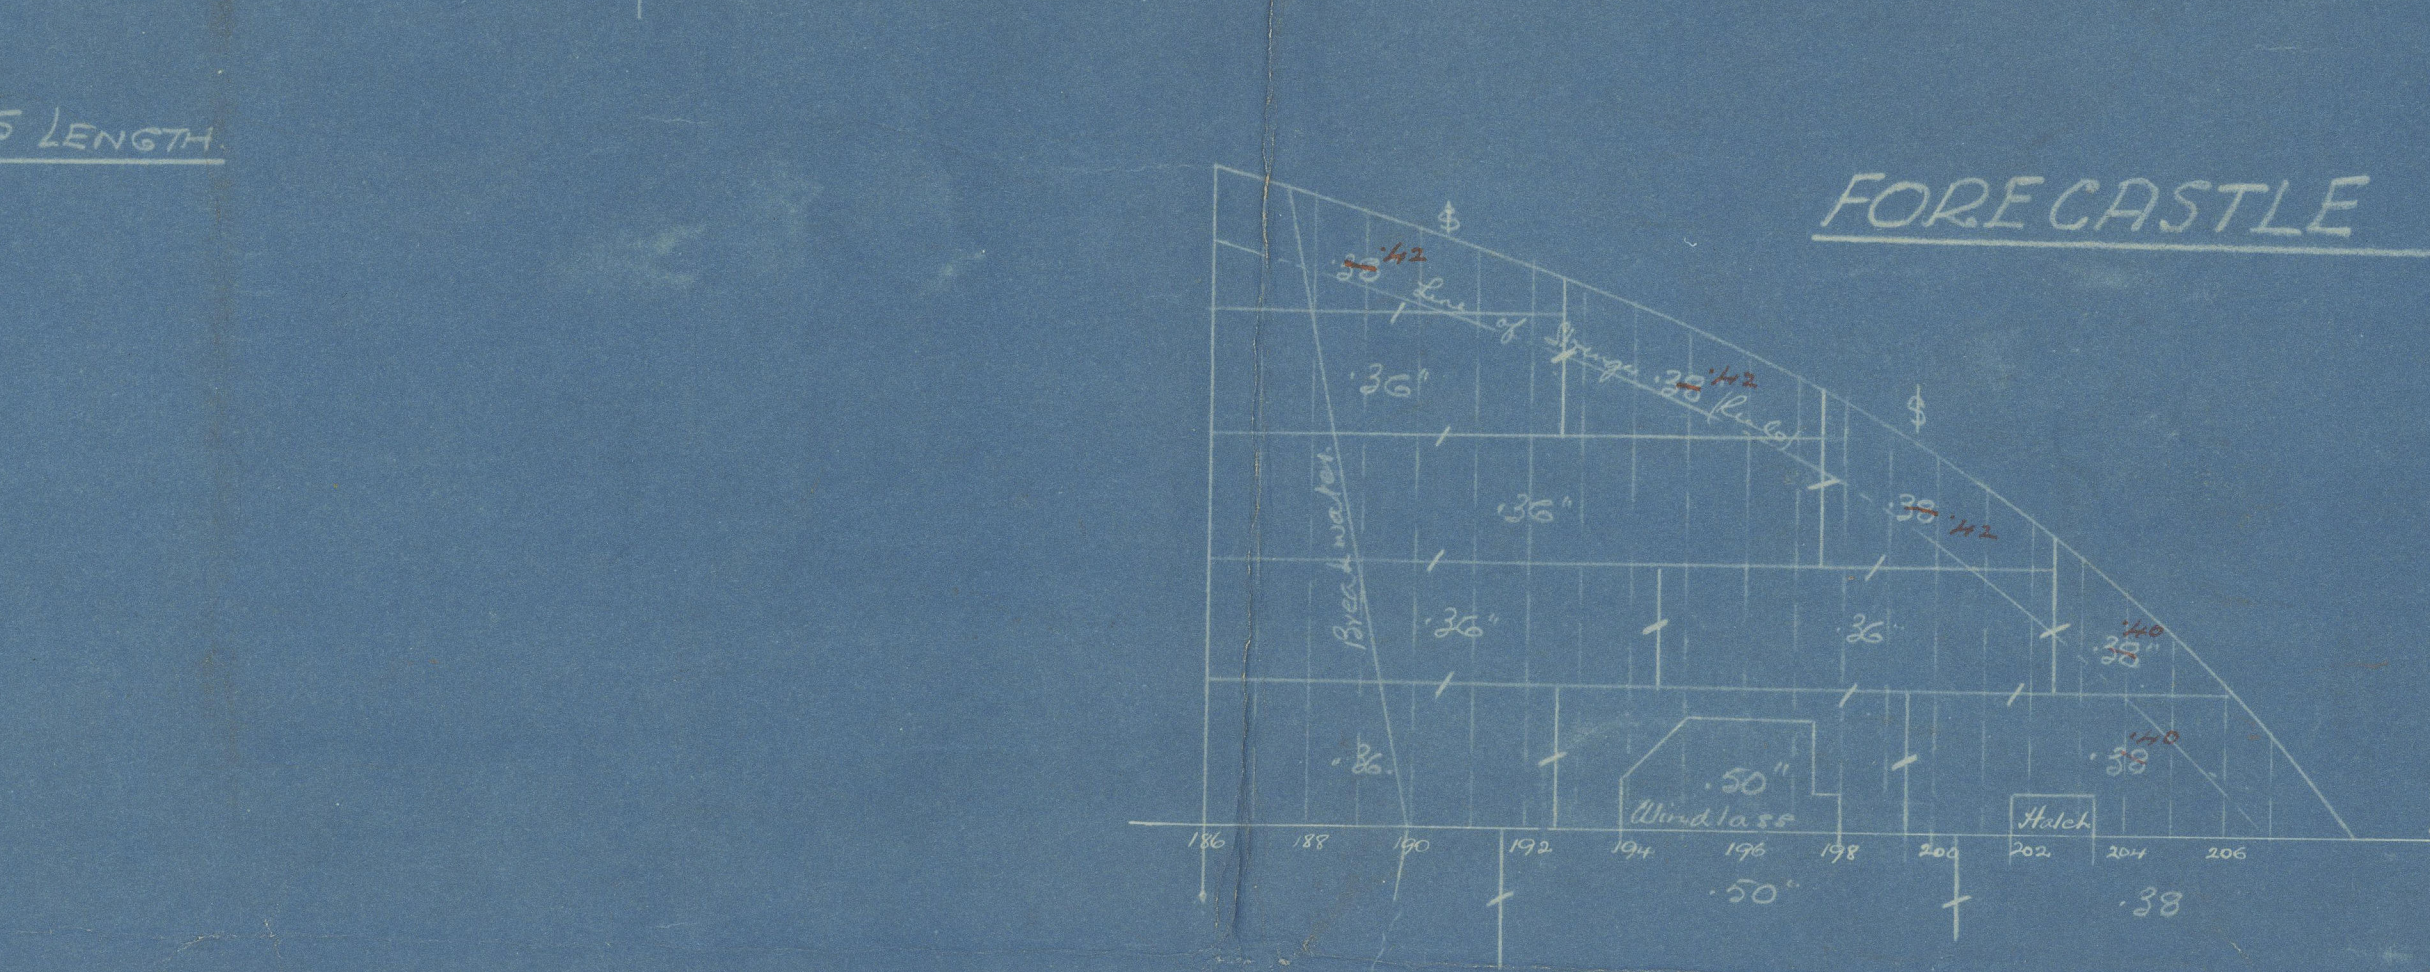


FORECASTLE DECK

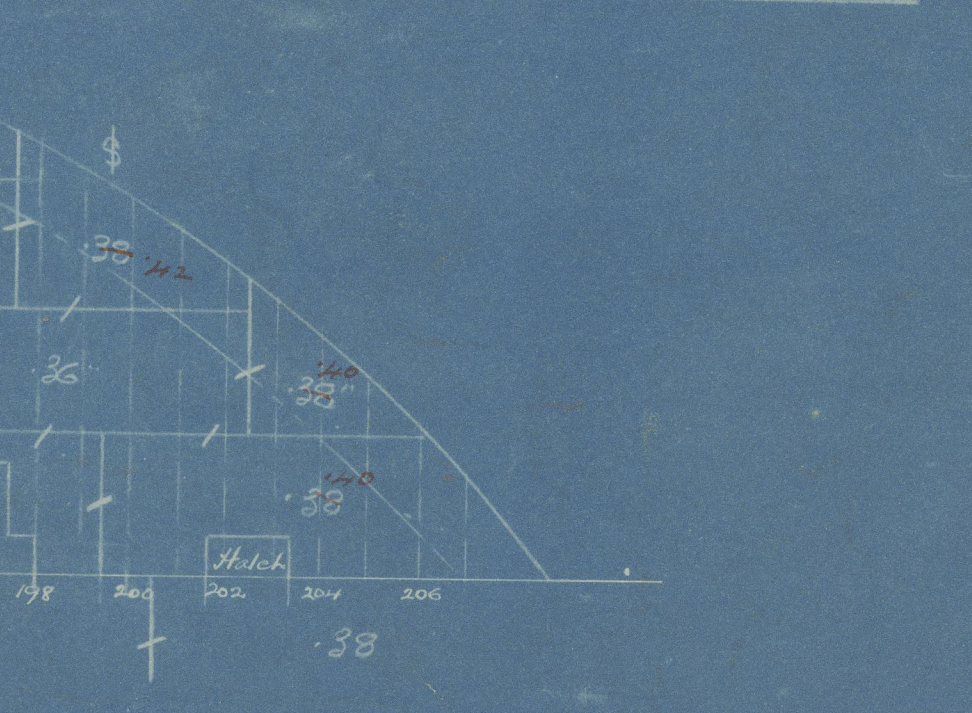

UPPER DECK

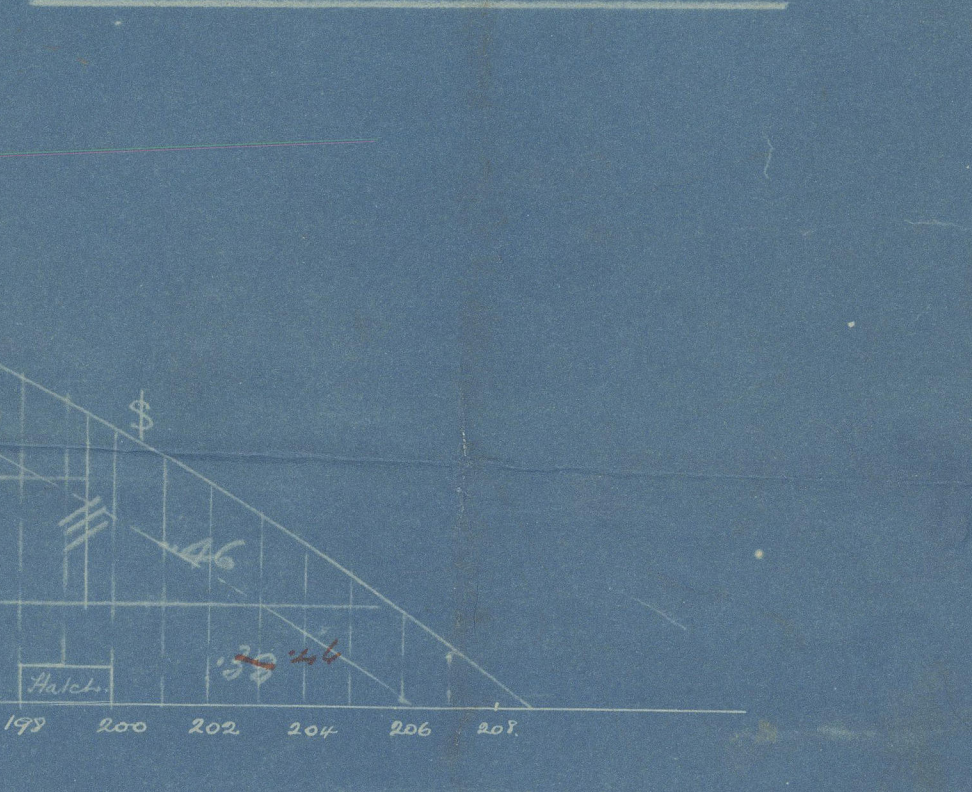

MAIN DECK

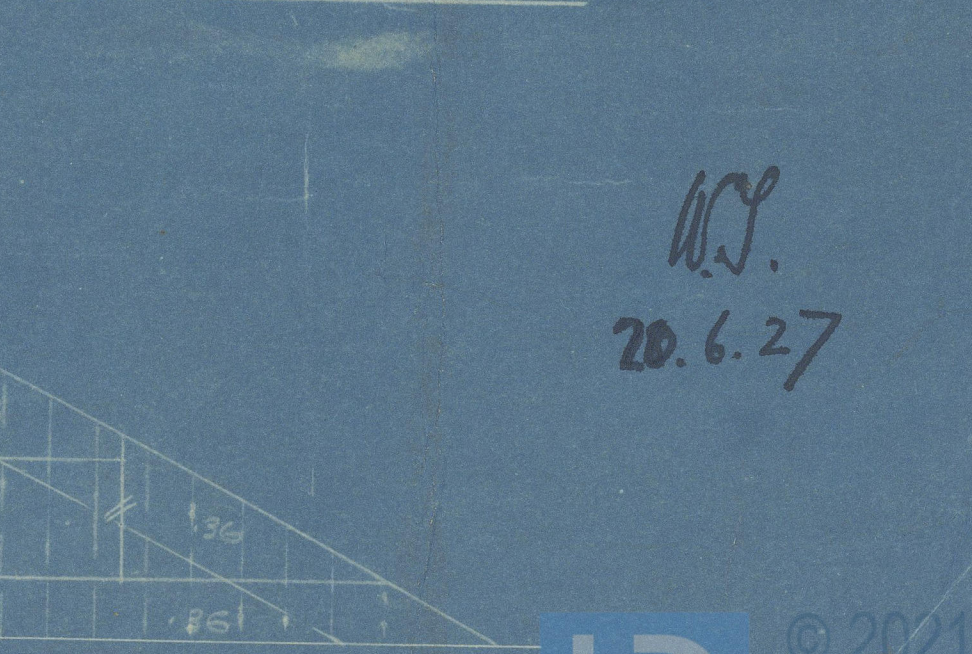

Note: Additions in black are in cases of possible increase depth to 28' 8" (shown in plan after approval by Lloyd's)

This strike +.06 in the 1st deck.  
This strike +.06 in the 2nd deck.

Nº 931.  
Cammell Laird & Co.  
Birkenhead

20.6.27



RETAIN



© 2021

Lloyd's Register  
Foundation



JUN 21 1927



© 2021

Lloyd's Register  
Foundation

W440-0268



Dec 15, ✓

S. S. Metfield

LIVERPOOL:

Report No. 9783

RETAIN

W440-0268



© 2021

Lloyd's Register  
Foundation