



OUTLINE PROFILE


OIL TANK STEAMER

498'-0" B.P. x 67'-6" M. x 37'-0" M.

SCALE 1/16" = 1 FOOT.

$498 \times 37 = 18,450$

CURCHIN & WATSON,  
59 MARK LANE,  
LONDON. E.C.3.

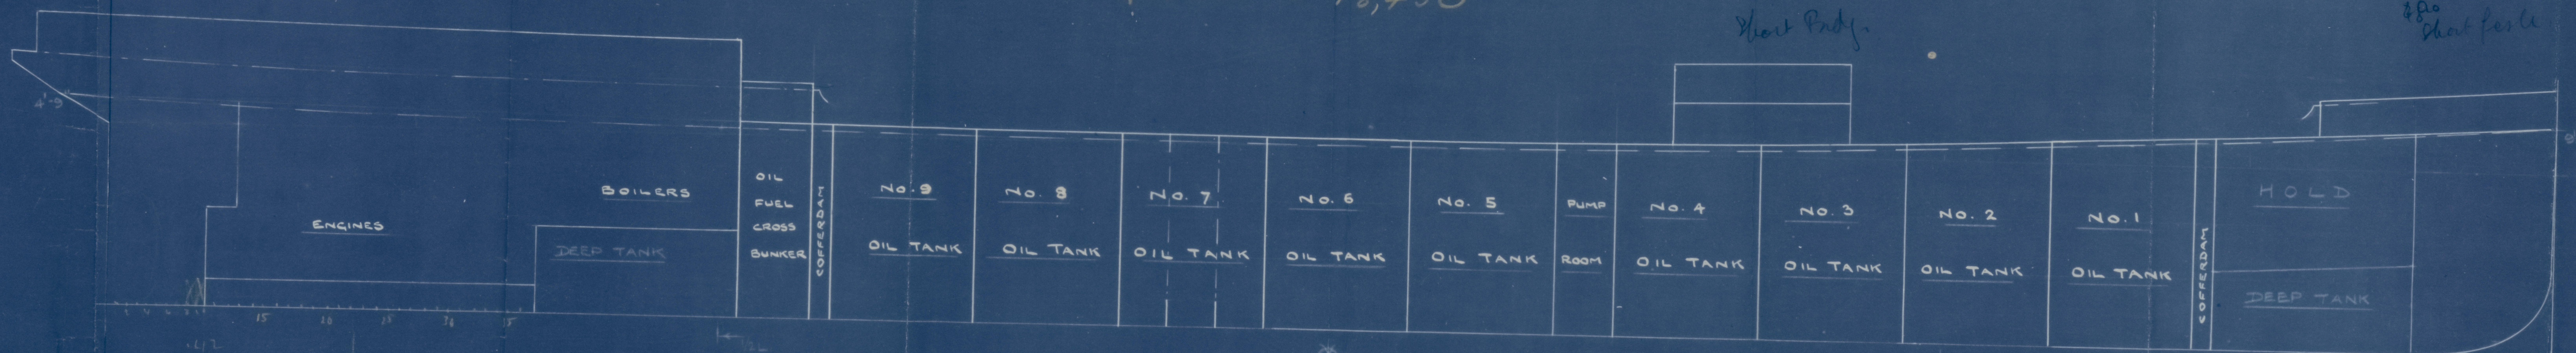

Planings - Arrangements Clear of  
Cargo Tanks to be Submitted



Cammell Rand  
931

Outline Profile ✓

"Gretafeld"  
Liv 93783

RETAIN

W660-0275



© 2021

Lloyd's Register  
Foundation



RETAIN

Phas to be Centred  
at Top & Bottom

See Rotterdam

12

17



© 2021

Lloyd's Register  
Foundation