

Lloyd's Register of Shipping.

MERCHANT SHIPPING (SAFETY AND LOAD LINE CONVENTIONS) ACT, 1932.

ANNUAL SURVEY IN ACCORDANCE WITH SECTION 48 (4) OF THE ABOVE ACT.

(Port) Dundee
(Date) 28th August 1933

I have to report that I have surveyed the S.S.
"GOWRIE" of Dundee O.N. 129243
on this date, in accordance with Paragraphs 114 to 117 of the "Instructions to Surveyors as to the Survey of Ships for Load Line Certificates" (Circular 1687), and I have endorsed the Freeboard Certificate as under:—

I have surveyed this ship for the purpose of seeing whether this certificate should remain in force, and the survey has been completed to my satisfaction.


J. Thomson
(Signature of Surveyor.)

Dundee
(Place.)

25th August 1933
(Date.)

REMARKS.

No. 1. Hatchway forward is now fitted with MACANKING steel hatch covers the size of hatchway inside is 11'-0" x 10'-5" having been reduced from 11'-0" square. Joint and arrangements.

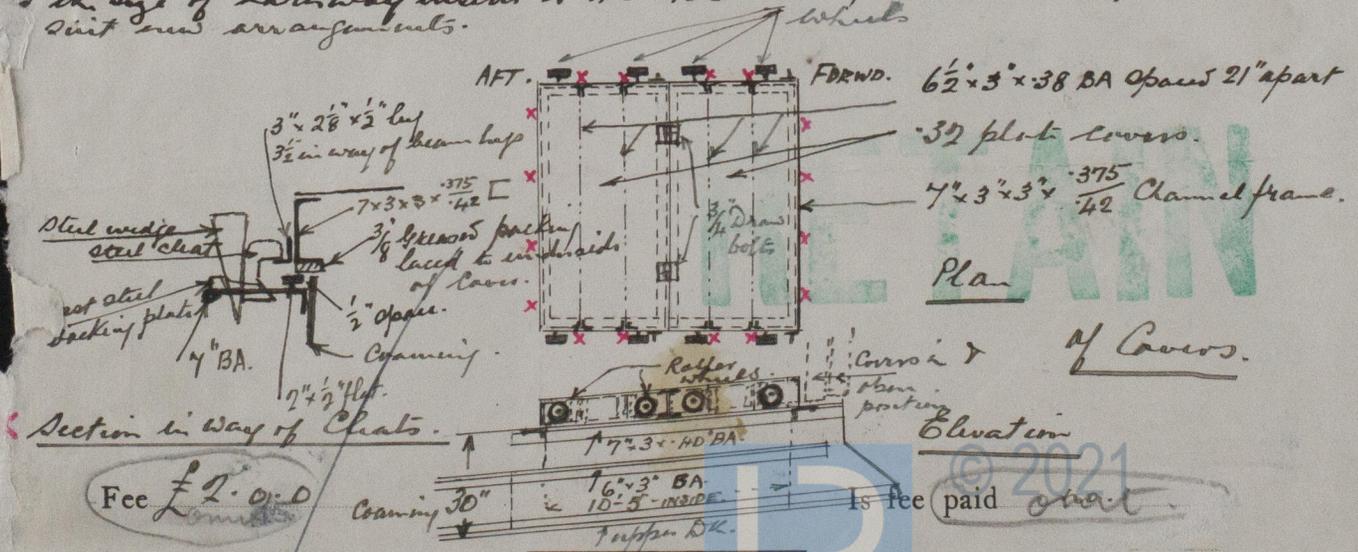

Fee £ 2.0.0

Surveyors should note that there is only one valid certificate, and the above endorsement should be made thereon. No entry should be made on a certified copy of the certificate unless the original certificate has been produced to and endorsed by the Surveyor.

Lloyd's Register of Shipping

MERCHANT SHIPPING (SAFETY AND LOAD LINE
CONVENTIONS) ACT 1932

ANNUAL SURVEY OF ACCORDANCE WITH
SECTION 14 OF THE ABOVE ACT







Handwritten notes:
20.8.33
Order 26/46/125



© 2021

Lloyd's Register
Foundation