
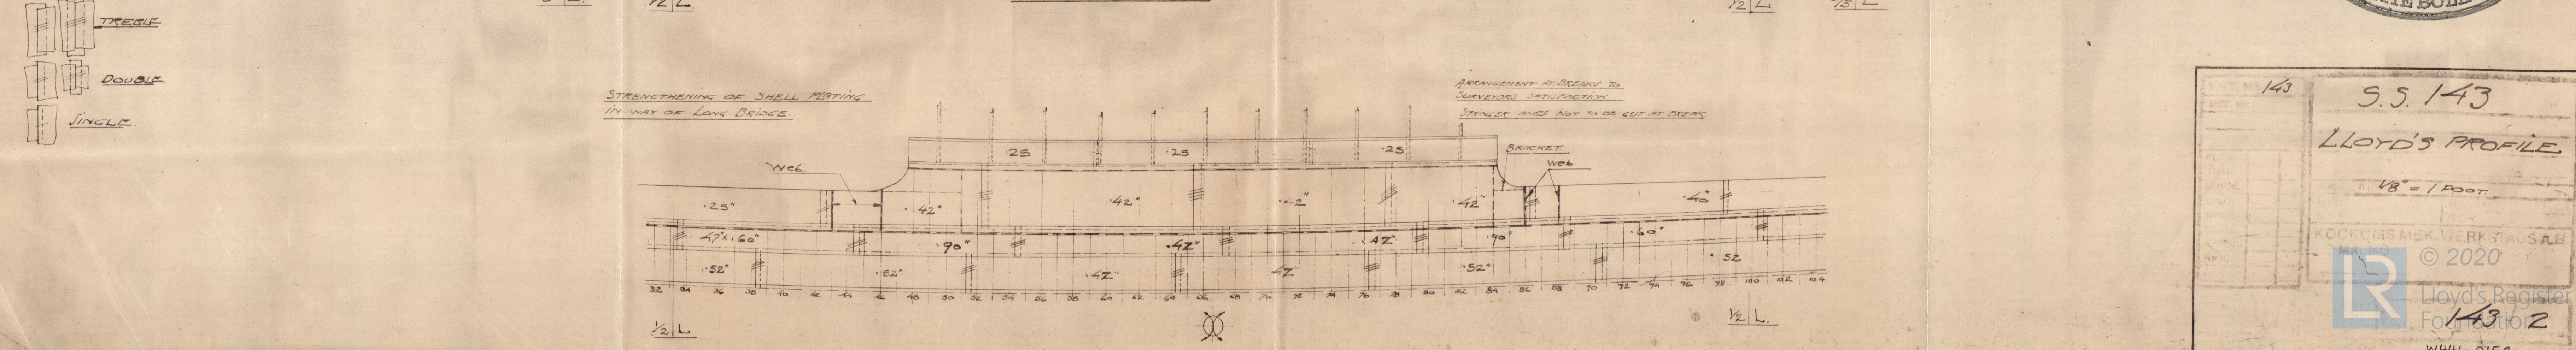
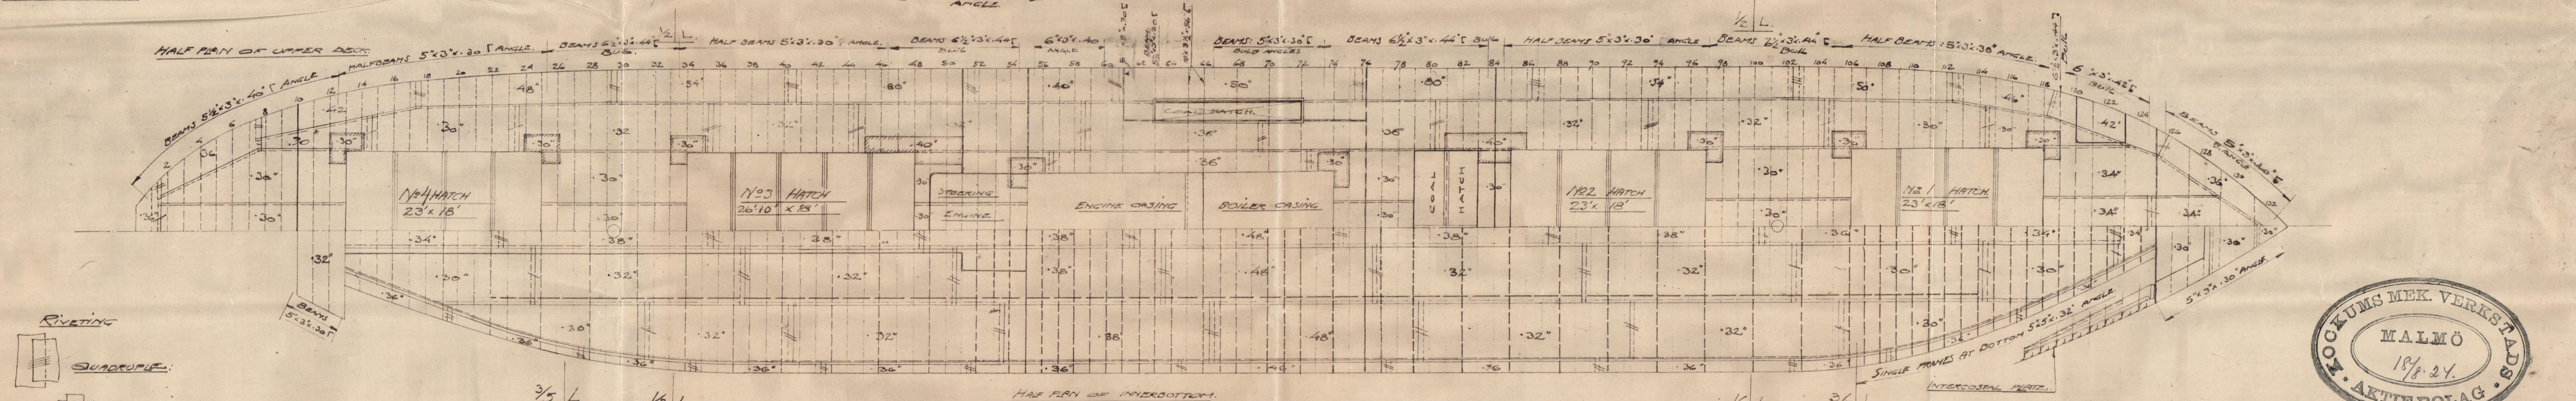
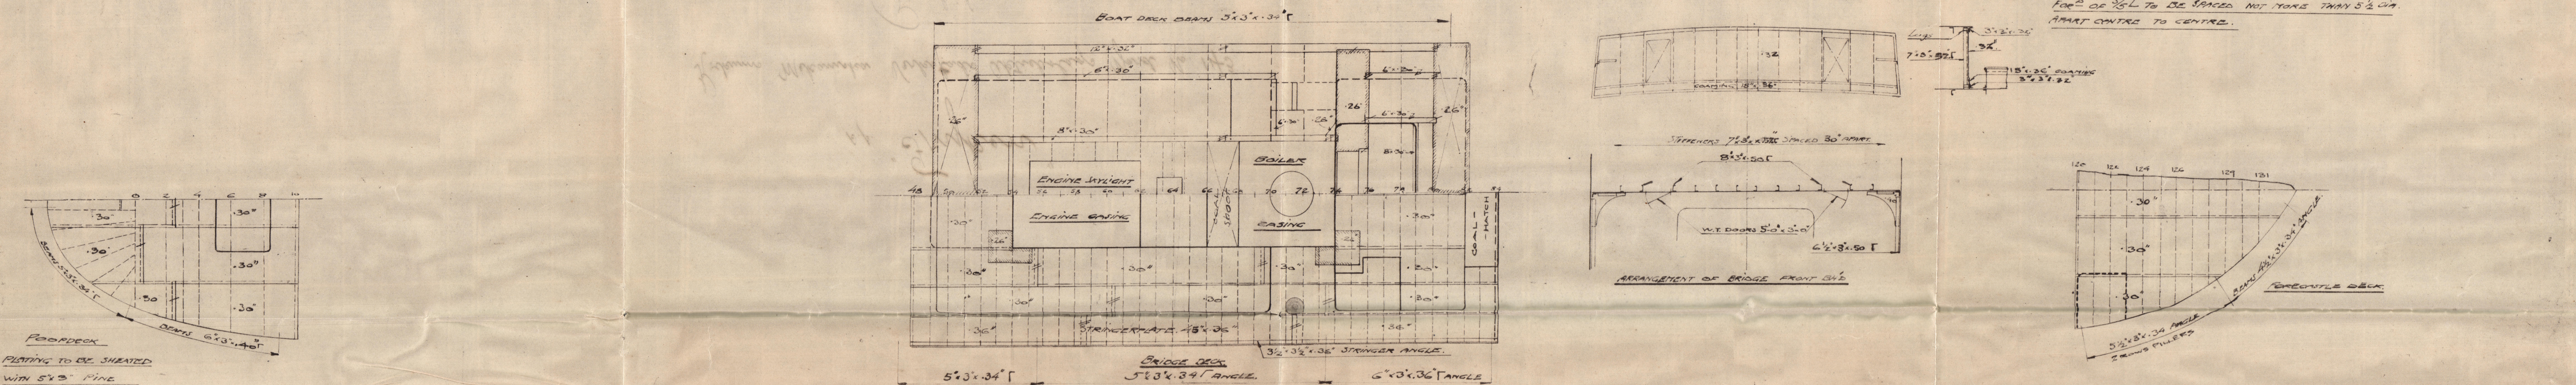


PROFILE OF A FREIGHT STEAMER.

TO CLASS LLOYDS 100 AI SINGLE DECK STEEL

SCALE: $\frac{1}{8}'' = 1 \text{ FOOT}$

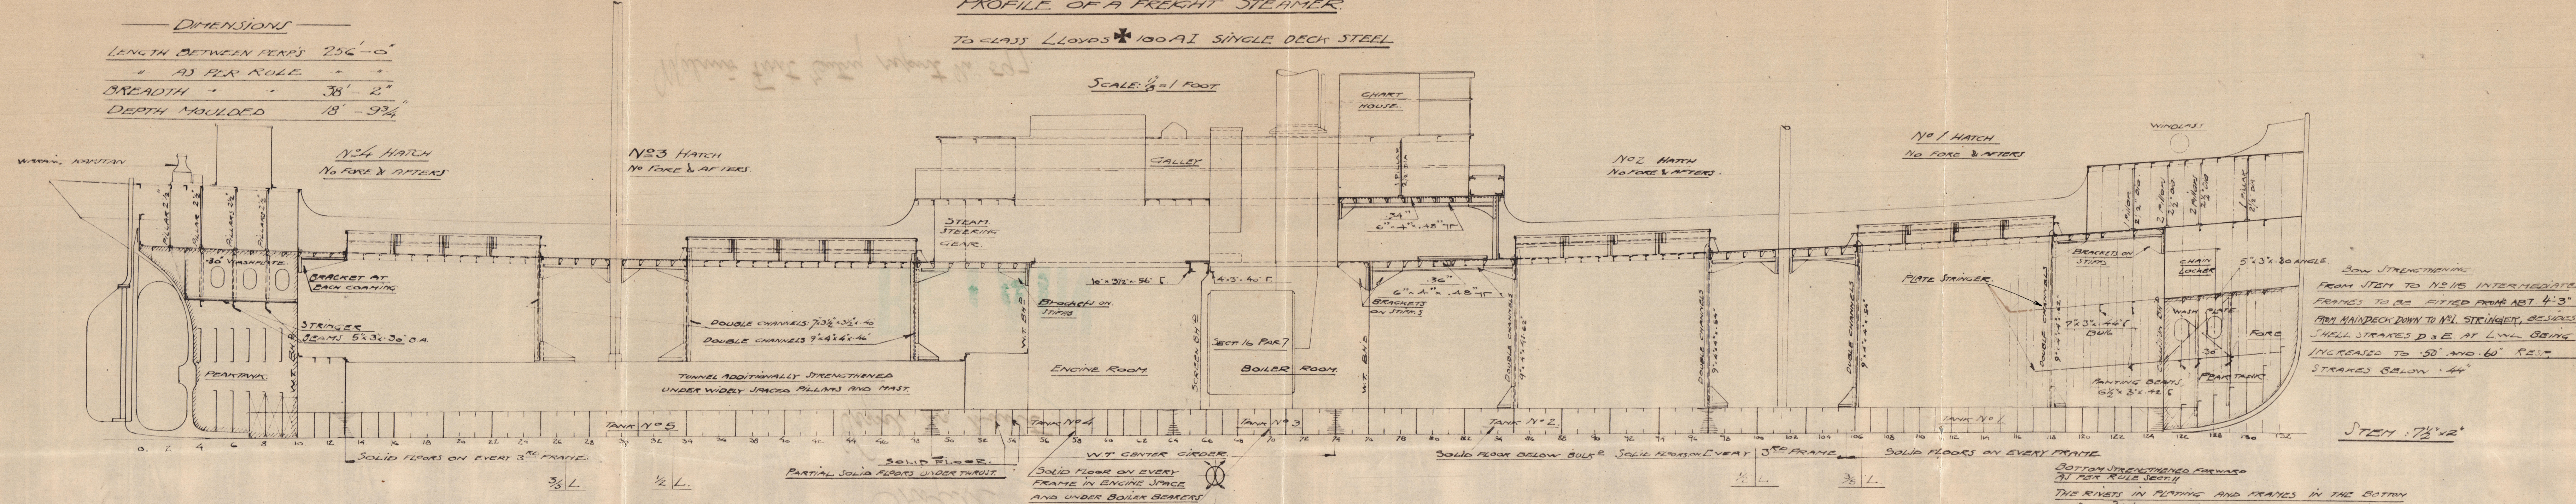

s.p. "Fryken"

Rockums Mekaniska Verkstads Aktiebolags Yard No. 143.

Profile.

Vessel as built.

RETAIN

Malmö First Entry report No. 597.



© 2020

Lloyd's Register
Foundation

W441-0158