

MIDSHIP SECTION OF A FREIGHT STEAMER

TO CLASS 100 A LLOYD'S SINGLE DECK STEEL

SCALE: 1/2"=1'00"


DIMENSIONS.		THE DEPTH		D	
LENGTH BETWEEN PERPS=L	256'-0"	FIRST LONGITUDINAL NUMERAL	D	=	18.81
BREADTH MOULDED =B	38'-2"	SECOND " "	LxD	=	4.816
DEPTH MOULDED TO UPPER DECK=D	18'-9 3/4"	THE PROPORTIONS	Lx(B+D)	=	14.587
HEIGHT FROM MARGIN PLATE TO UPPER DECK AT SIDE	16'-0"	THE FRAMING DEPTH	L/D	=	13.6
		THE PROPORTIONS	2	=	16.0
			L/D	=	9.9

UNDER DECK - Lx(B+D)=	14.587
POOP =	7.05+17.35+0.75 = 91
BRIDGE =	7.13+6.25+0.75 = 338
FORECASTLE =	7.05+25.00+0.75 = 135
DECKHOUSE =	7.05+22.00+0.5 = 221
NUMERAL =	15.372

EQUIPMENT.

2 BOWER ANCHORS STOCKLESS	33 CWTs EACH
1 STREAM "	EX STOCK 8 1/2 "
240 FATHOMS 1 1/8" STUD CHAIN CABLE OF A	
MINIMUM WEIGHT =	344 3/4 CWTs

75 FATHOMS 1 1/8" STREAM CHAIN OR 4" STEEL WIRE	
90 " TOWLINE 1 1/2" HEMP OR 3 1/2" "	
2 HAWKERS 90 FATHOMS OF 6" HEMP OR 2 1/4" STEEL WIRE	
2 WARPS 90 " " 5 " " 1 3/4 " "	

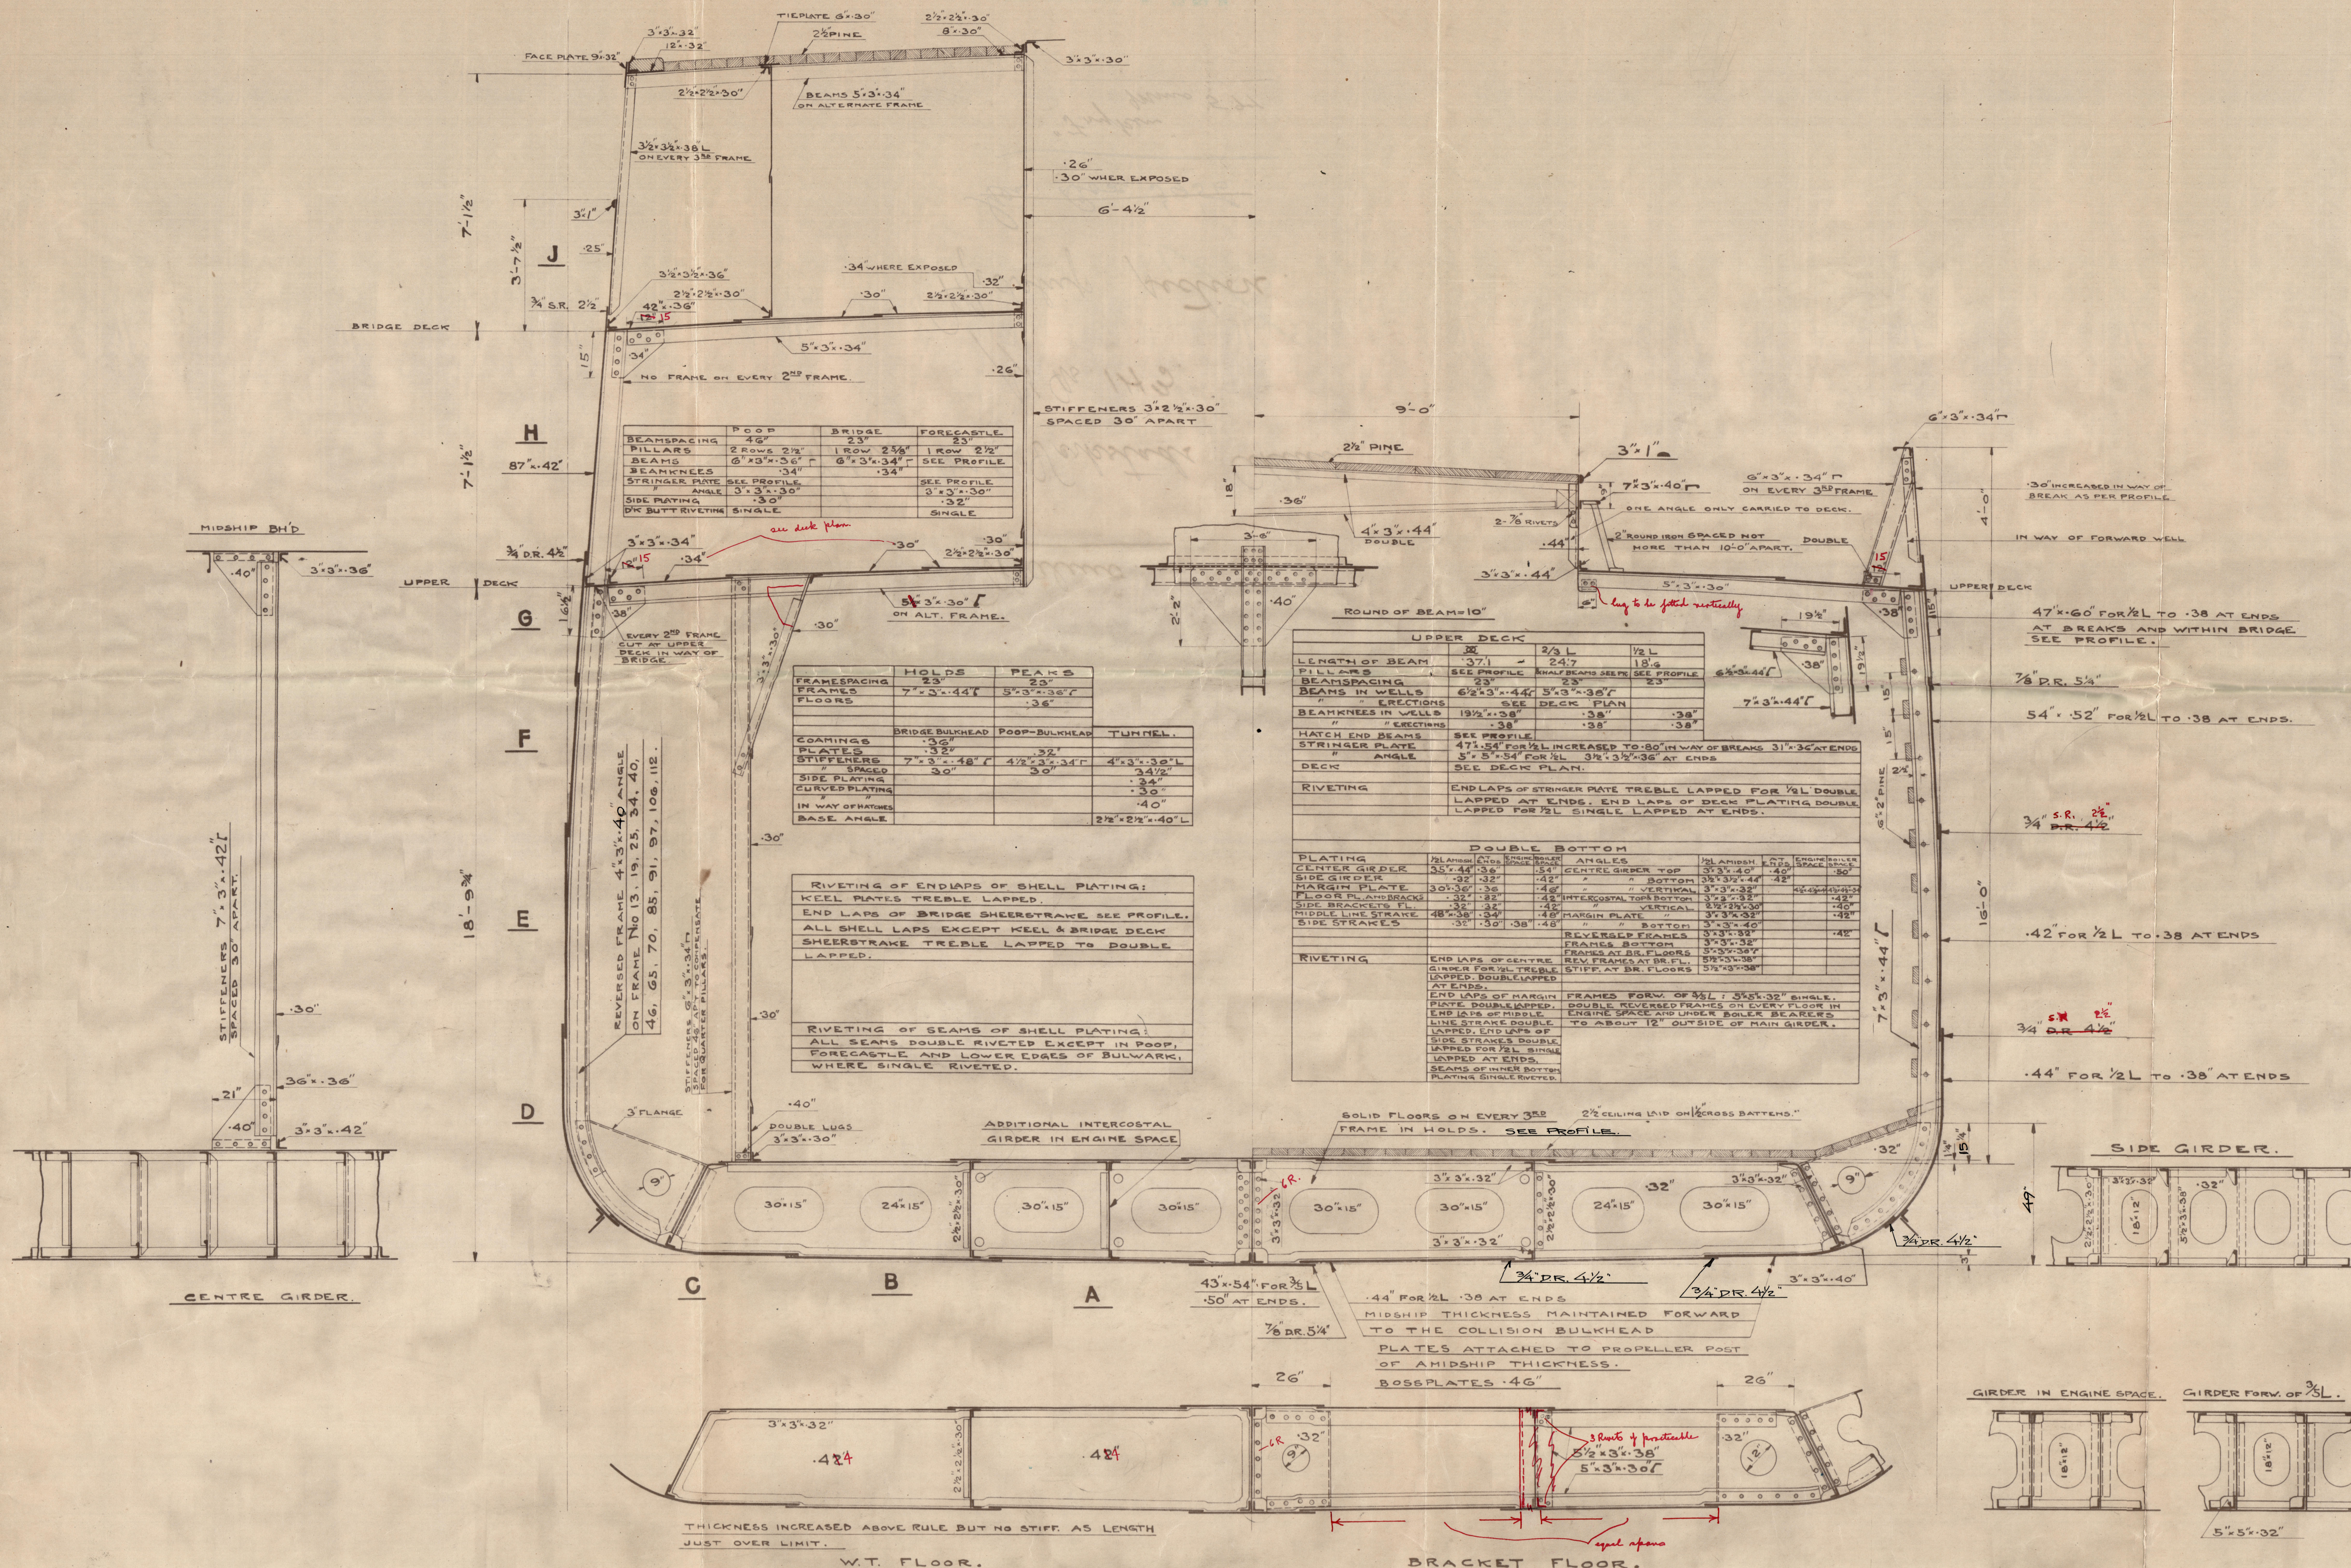

FRY. NO 143
DET. NO 1430

3/143.
MIDSHIP SECTION.

SCALE 1/2"=1'-0"

KOCKUMS MEK. VERKS. AB. MALMÖ

© 2020

Lloyd's Register Foundation

W441-0159

Malmö.

Hockums Mek. Verkstads Aktieb.


Nr. 143.

Midship section.

Gen. Box 3956.

"Fryken"
Mmo 597

RETAIN

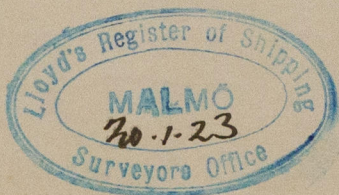

© 2020

Lloyd's Register
Foundation

W441-0159