
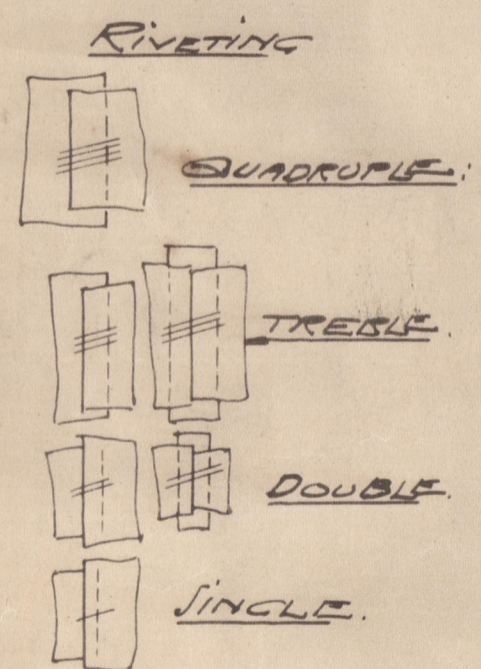
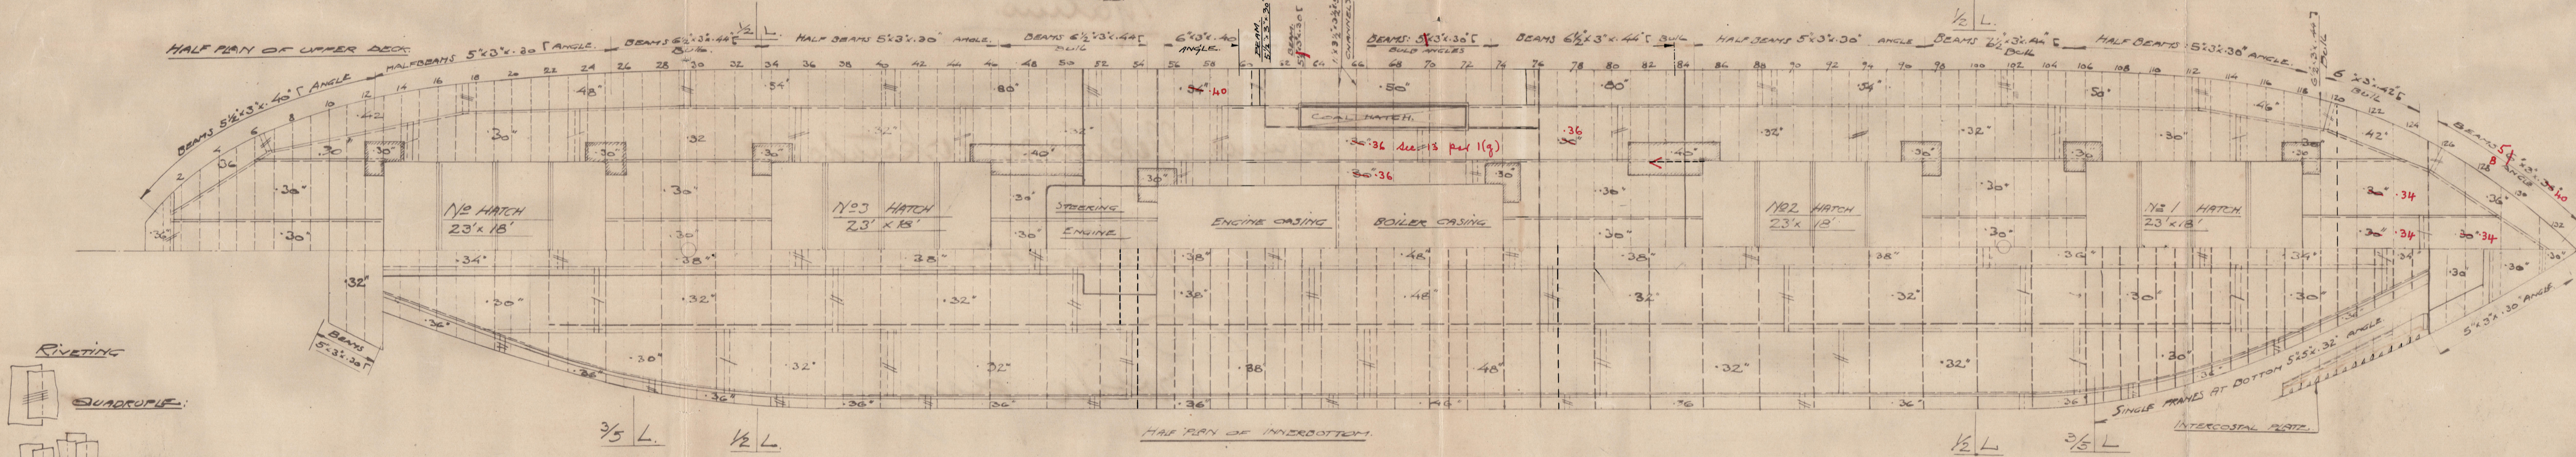
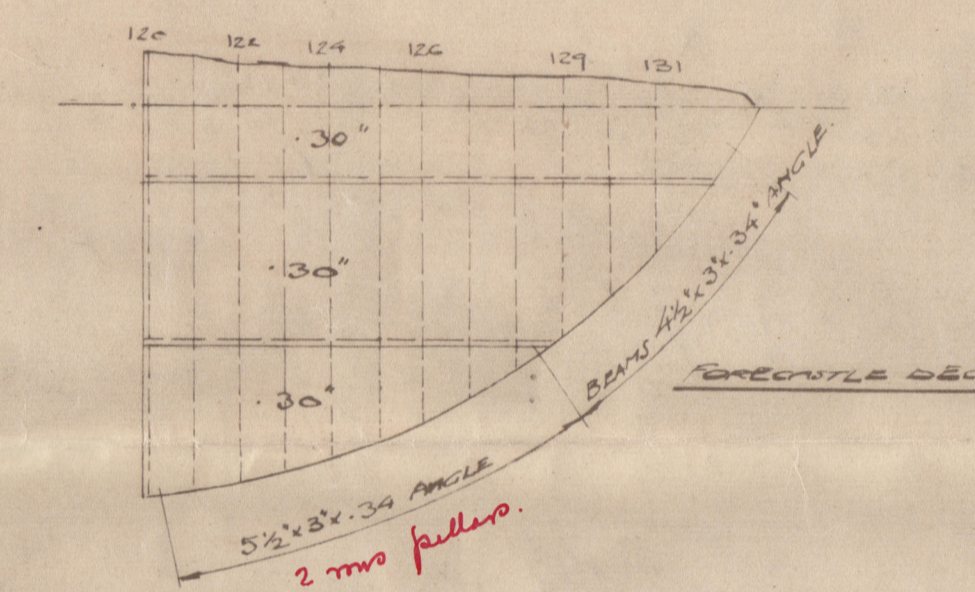
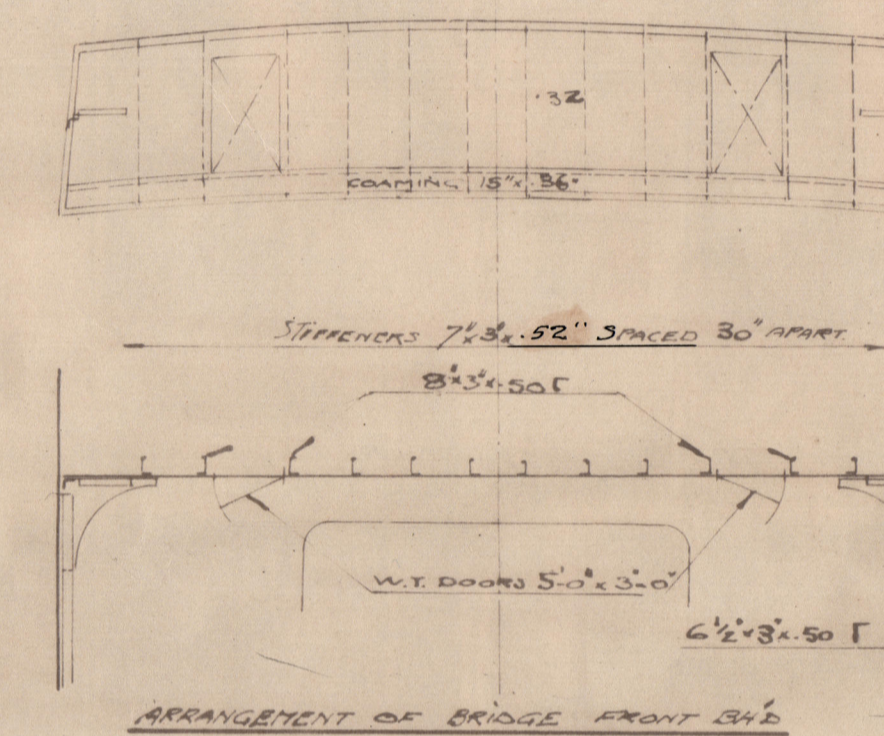
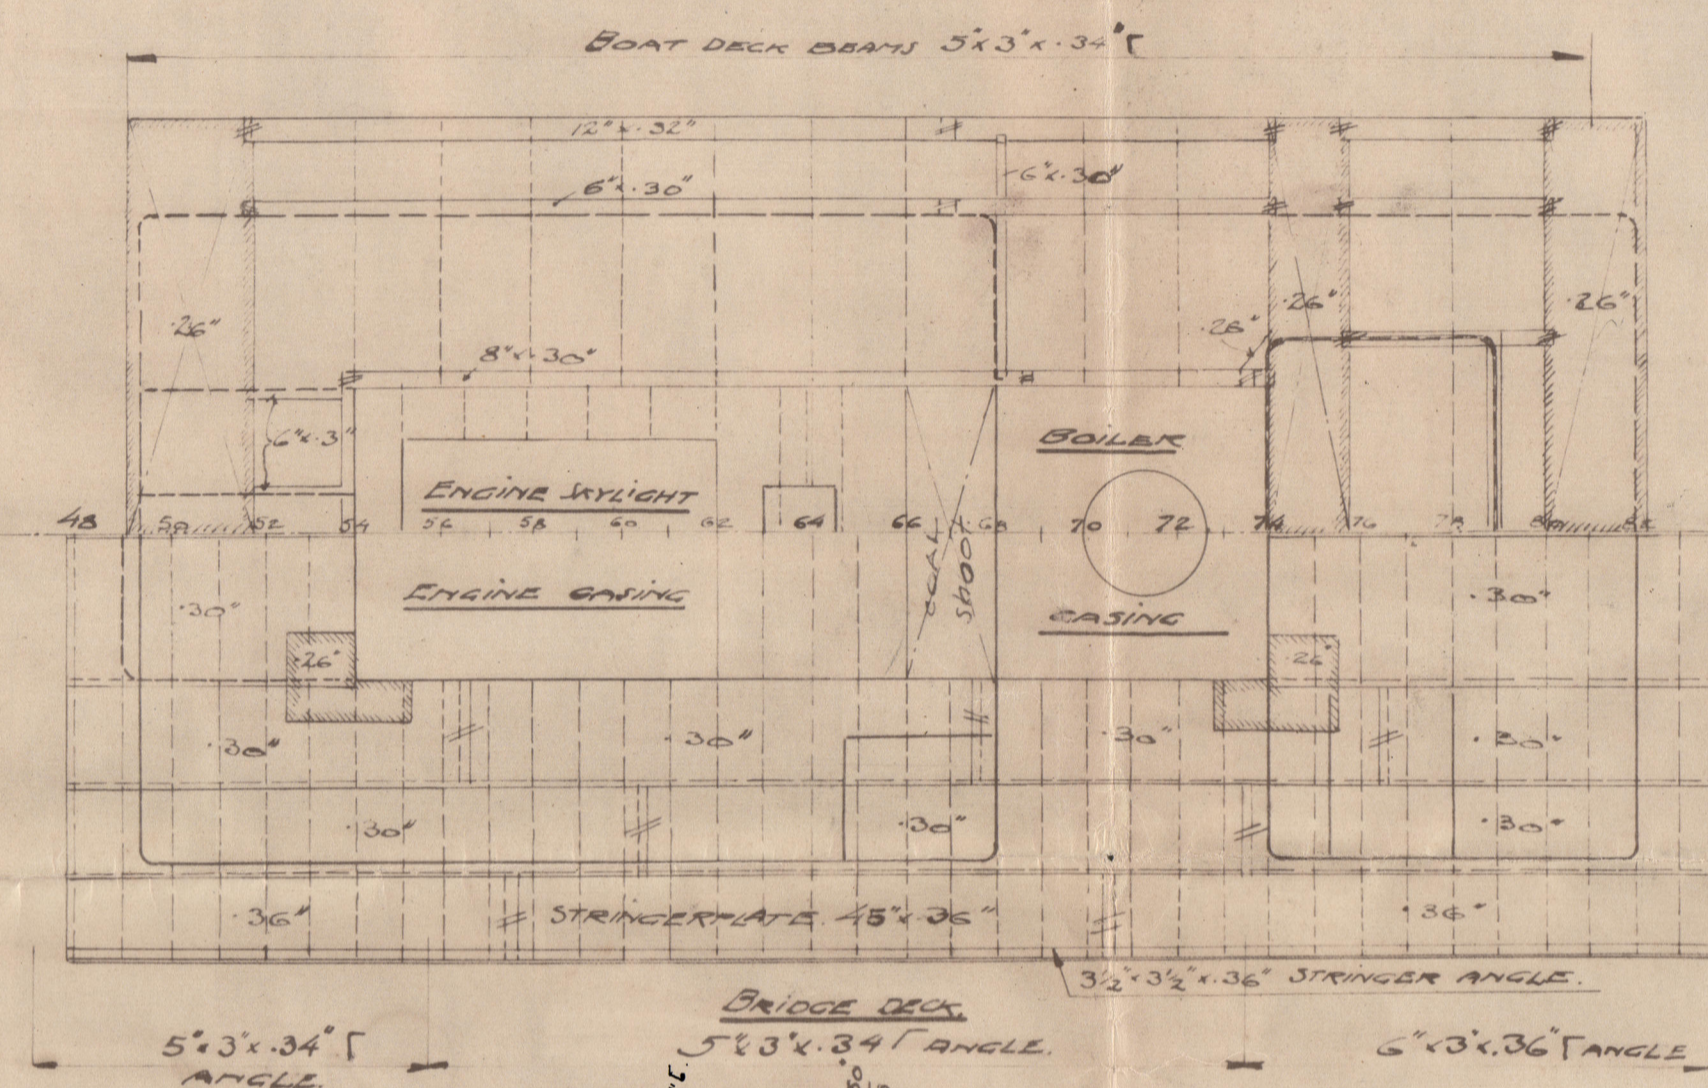
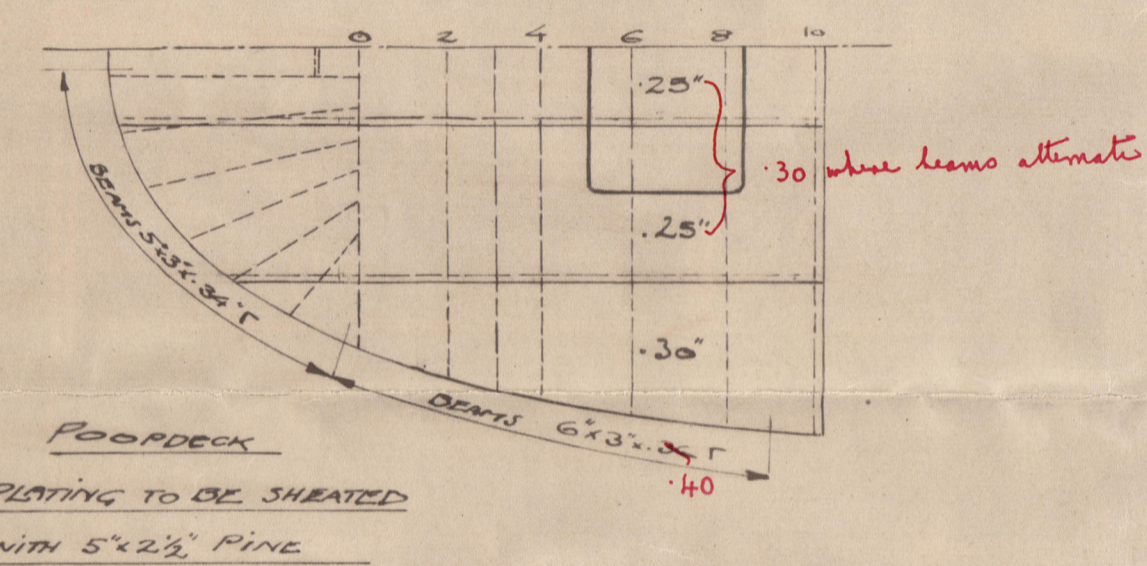



DIMENSIONS
 LENGTH BETWEEN PERPS 256'-0"
 AS PER RULE
 BREADTH 38'-2"
 DEPTH MOULDED 18'-9 3/4"

PROFILE OF A FREIGHT STEAMER
 TO CLASS LLOYD'S 100-A1 SINGLE DECK STEEL

SCALE: 1/8" = 1 FOOT

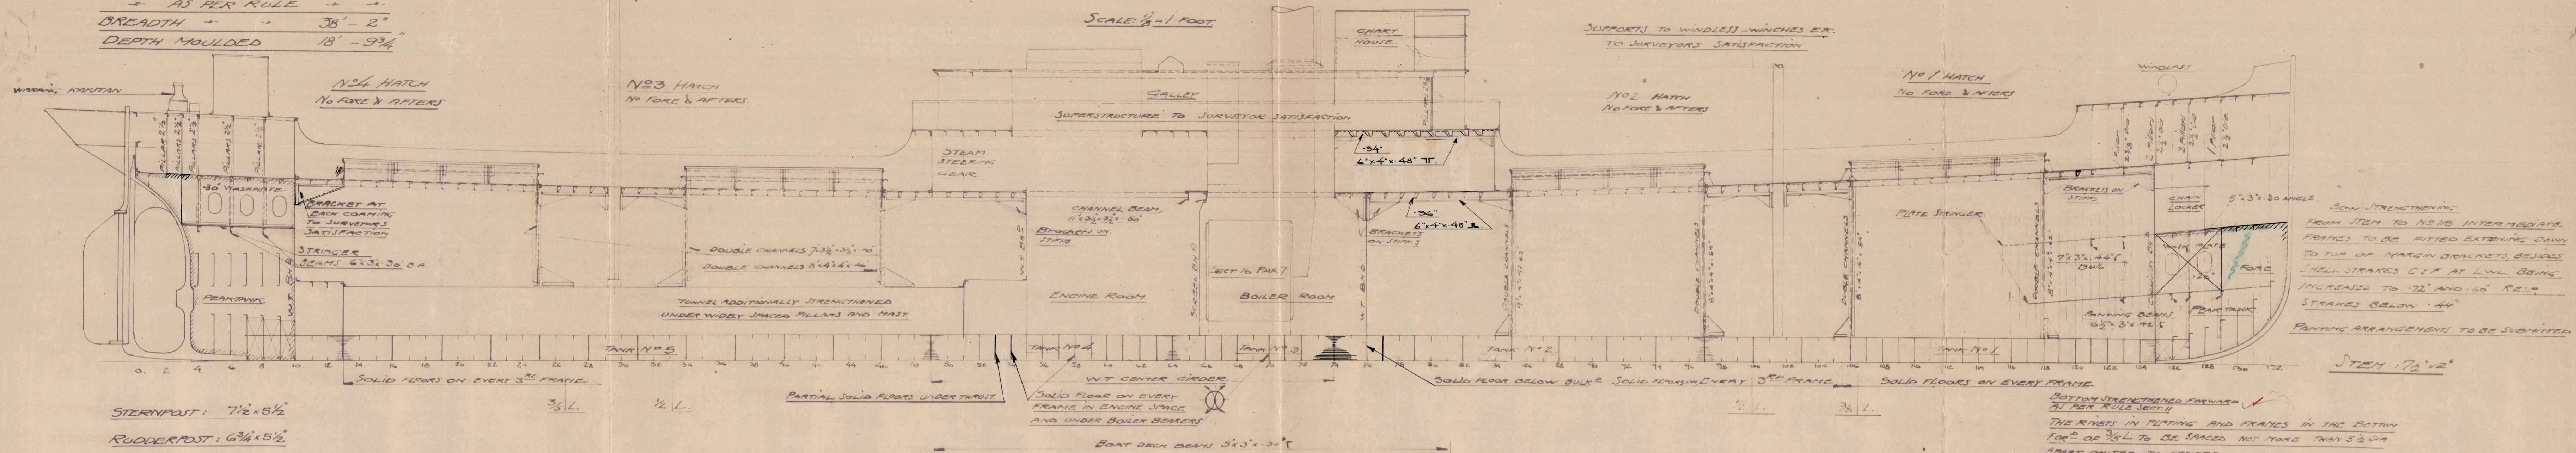

STRENGTHENING OF SHELL PLATING
 IN WAY OF LONG BRIDGE

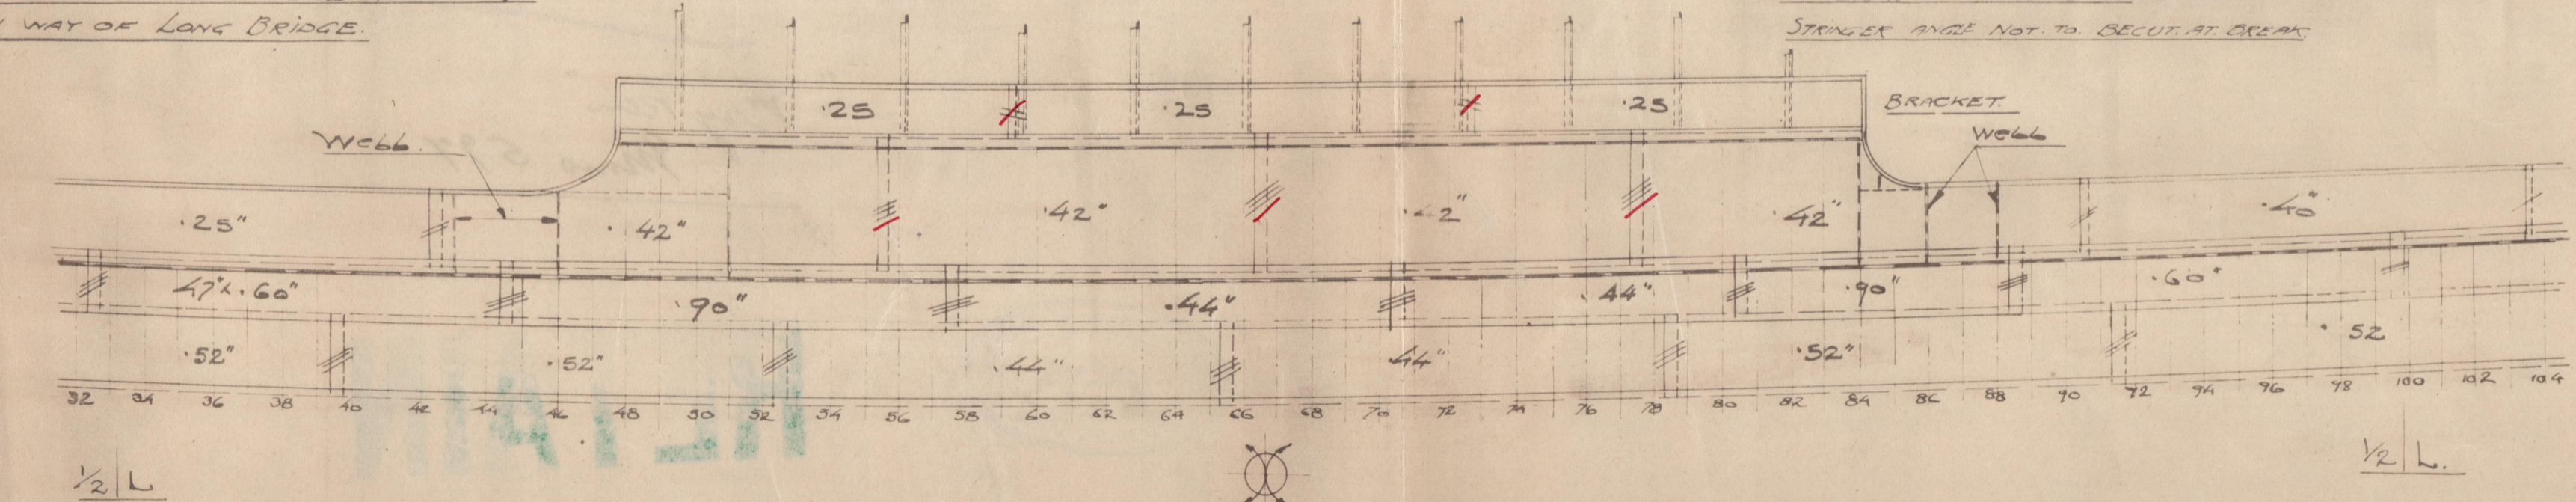

FILE NO 143
S.S. 143
LLOYD'S PROFILE
 SCALE 1/8" = 1 FOOT
 KOCKUMS MEK. VERKSTADS A.B. MALMÖ
 © 2020
 Lloyd's Register Foundation

J.Y.
 3-2-23

Malmö.



Fockerus Mekaniska Verkstads AB.

A.P. No. 143.

Profile plan ✓

Gen. Box 3956.

"Fryken"
Mmo 597

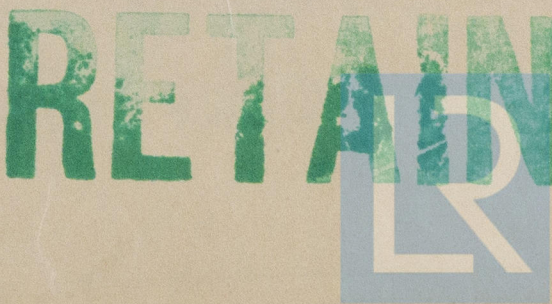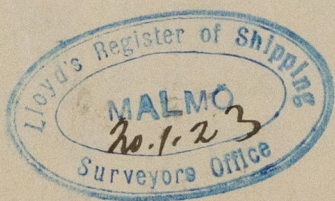

© 2020

Lloyd's Register
Foundation

W441-1060