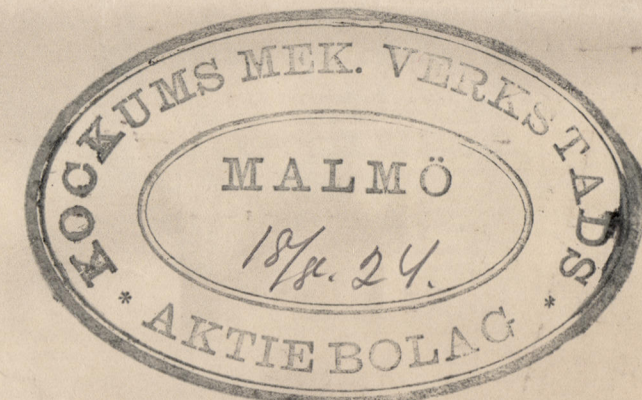


TO CLASS 100 A | LLOYD'S SINGLE DECK STEEL

SCALE: $\frac{1}{2}'' = 1 \text{ FOOT.}$

UNDER DECK = $L \times (B + D) =$	14.587
POOP = $7.05 \times 17.25 \times 0.75 =$	91
BRIDGE = $7.13 \times 63.25 \times 0.75 =$	338
FORECASTLE = $7.05 \times 25.5 \times 0.75 =$	135
DECKHOUSE = $713 \times 62 \times 0.5 =$	221
NUMERAL = 15.372	

2 BOWER ANCHORS STOCKLESS	33 CWTs EACH	75 FATHOMS $1\frac{1}{2}$ "	STREAM CHAIN OR 4" STEEL WIRE
1 " " " "	28 " "	90 " "	TOWLINE 11" HEMP OR 3" " "
1 STREAM " "	EX STOCK 8 $\frac{1}{2}$ "	2 HAWPERS	90 FATHOMS OF 6" HEMP OR 2 $\frac{1}{2}$ " STEEL WIRE
240 FATHOMS $1\frac{1}{2}$ "	STUD CHAIN CABLE OF A	2 WARPS	30 " " 5" " 13 $\frac{1}{2}$ " " "
MINIMUM WEIGHT = 344 $\frac{3}{4}$ CWTs			

 $\frac{1}{2}'' = 1' - 0''$

© 2020
Lloyd's Register
Foundation

W441-0161

sp. "Fryken"

Hockums Mekaniska Verkstads Aktiebolags Yard No. 143.

Midship Section.

Vessel as built.

RETAIN

Malmo First Entry report No. 597.



© 2020

Lloyd's Register
Foundation

W441-0161