

PARTICULARS FOR FREERCARD		
TENNAGE COEFFICIENT ABOUT		82
LENGTH OF FORECASTLE		35.56
" " BRIDGE (ALL ENCLOSED)		162.56
" " POOP FOR ^D OF A.P.		26.75
LOWEST POINT OF SHEER		AMIDSHIPS
SHEER AT STEM AT UPPER DECK		6'-0"
" " 1/8 L. FROM STEM		3'-9"
" " 3/8 L. " "		0'-5 1/2"
" " STERNPOST AT U D		2'-0"
" " 1/8 L. FROM STERNPOST		1'-5 1/2"
" " 1/4 L. " "		0'-8"
" " 3/8 L. " "		0'-2"

→ TO CLASS 100. A.I. AT LLOYDS →

<u>DIMENSIONS</u>		
LENGTH	B.P.	370'-0"
BREADTH	M.L.D.	53'-0"
DEPTH	M.L.D. TO UPPER DECK	30'-0"
DEPTH	"d"	17'-0"
L/D	TO UPPER DECK	12.3
L/D	TO BRIDGE DECK	9.8

TRANSVERSE	N° = {53 + 30}	= 83
LONGITUDINAL	N° = {83 + 370}	= 30710
EQUIPMENT	N°	= 31970


— EQUIPMENT LETTER "X" —

2	BOWER ANCHORS	STOCKLESS	56 1/2	CWTS. EACH
1	"	"	4 1/2	"
1	STREAM	" EX. STOCK	15	"
1	KEDGE	" "	6 1/2	"
270	FMS.	2 1/2" STUD CHAIN	CABLE	
90	"	4 1/2" S.W.R.	STREAM	
120	"	4 1/2" S.W.R.	TOWLINE	
4	MANILLA HAWKERS	7"	EACH	90 FMS.

<i>95 "HULLINDIES"</i>	
THE NEWPORT NEWS SHIPPING CO. 601 FIVE EX NEWPORT NEWS VA. HULL DEPT.	
HULL N° 206	
TYPE SECTIONS {LLOYDS}	
FREIGHTER FOR MUNSON S.S.LINE	
½ INCH	DATE <i>1/27/46</i>
<i>J.R.</i> <i>J.R.C.</i>	<i>Willis</i>
APPROVED	DIRECTOR
1-28-1946	
74390	<i>W. Galewood</i>
SIGNED AND DELIVERED BY THE DIRECTOR	

6-28-17
R. LLOYDS

W442-0247

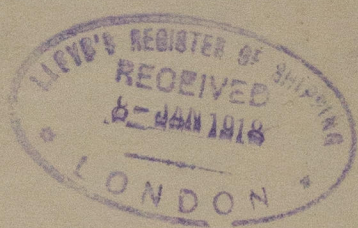

LENG
BREA
DEPT
DEPT
L/D
L/D
TRA
LONG
EQU

TO C

"
"
"
"
"
"
SHEET
LOWE
"
"
LENG
TCNA

NC .25"

2.5"
T
3.375"
3.75 SGL
2.7" x 3.0"
9'-0"



© 2020

Lloyd's Register
Foundation