




W.T. BULKHEAD No 5
PLATING .36" TO .26"
STIFFENERS 7 x 3 x .36 B.A.
SPACED 24" APART BRACKETS AT TOP
FRAME 4 1/2 x 4 1/2 x .46"
BEAM 3 x 3 x .36"

NON. W.T. BULKHEAD No 30
PLATING .36" TO .28"
STIFFENERS 6 x 3 x .34 O.A.
SPACED 36" APART
TOP PLATING .26"

W.T. BULKHEAD No 34
PLATING .40" TO .26"
STIFFENERS 7 x 3 x .36 B.A.
SPACED 30" APART BRACKETS TOP & BOTTOM
FRAME 3 x 3 x .40"
BEAM 3 x 3 x .36"

— No. 252. —
— PROFILE & DECK. —
— Dims 200'-0" x 32'-0" MLD x 14'-0" MLD. —
— SCALE 1/8" = 1 FOOT —

W.T. BULKHEAD No 95.
PLATING .35" TO .30"
STIFFENERS BELOW FLAT 6 1/2 x 3 x .40" B.A. (BRACKETS TO FLAT) }
" ABOVE " 4 1/2 x 3 x .32 O.A. (NO BRACKETS) } SPACED 34" APART.
DECK ANGLE 3 1/2 x 3 1/2 x .36"
FRAME ANGLE 4 1/2 x 4 1/2 x .42"

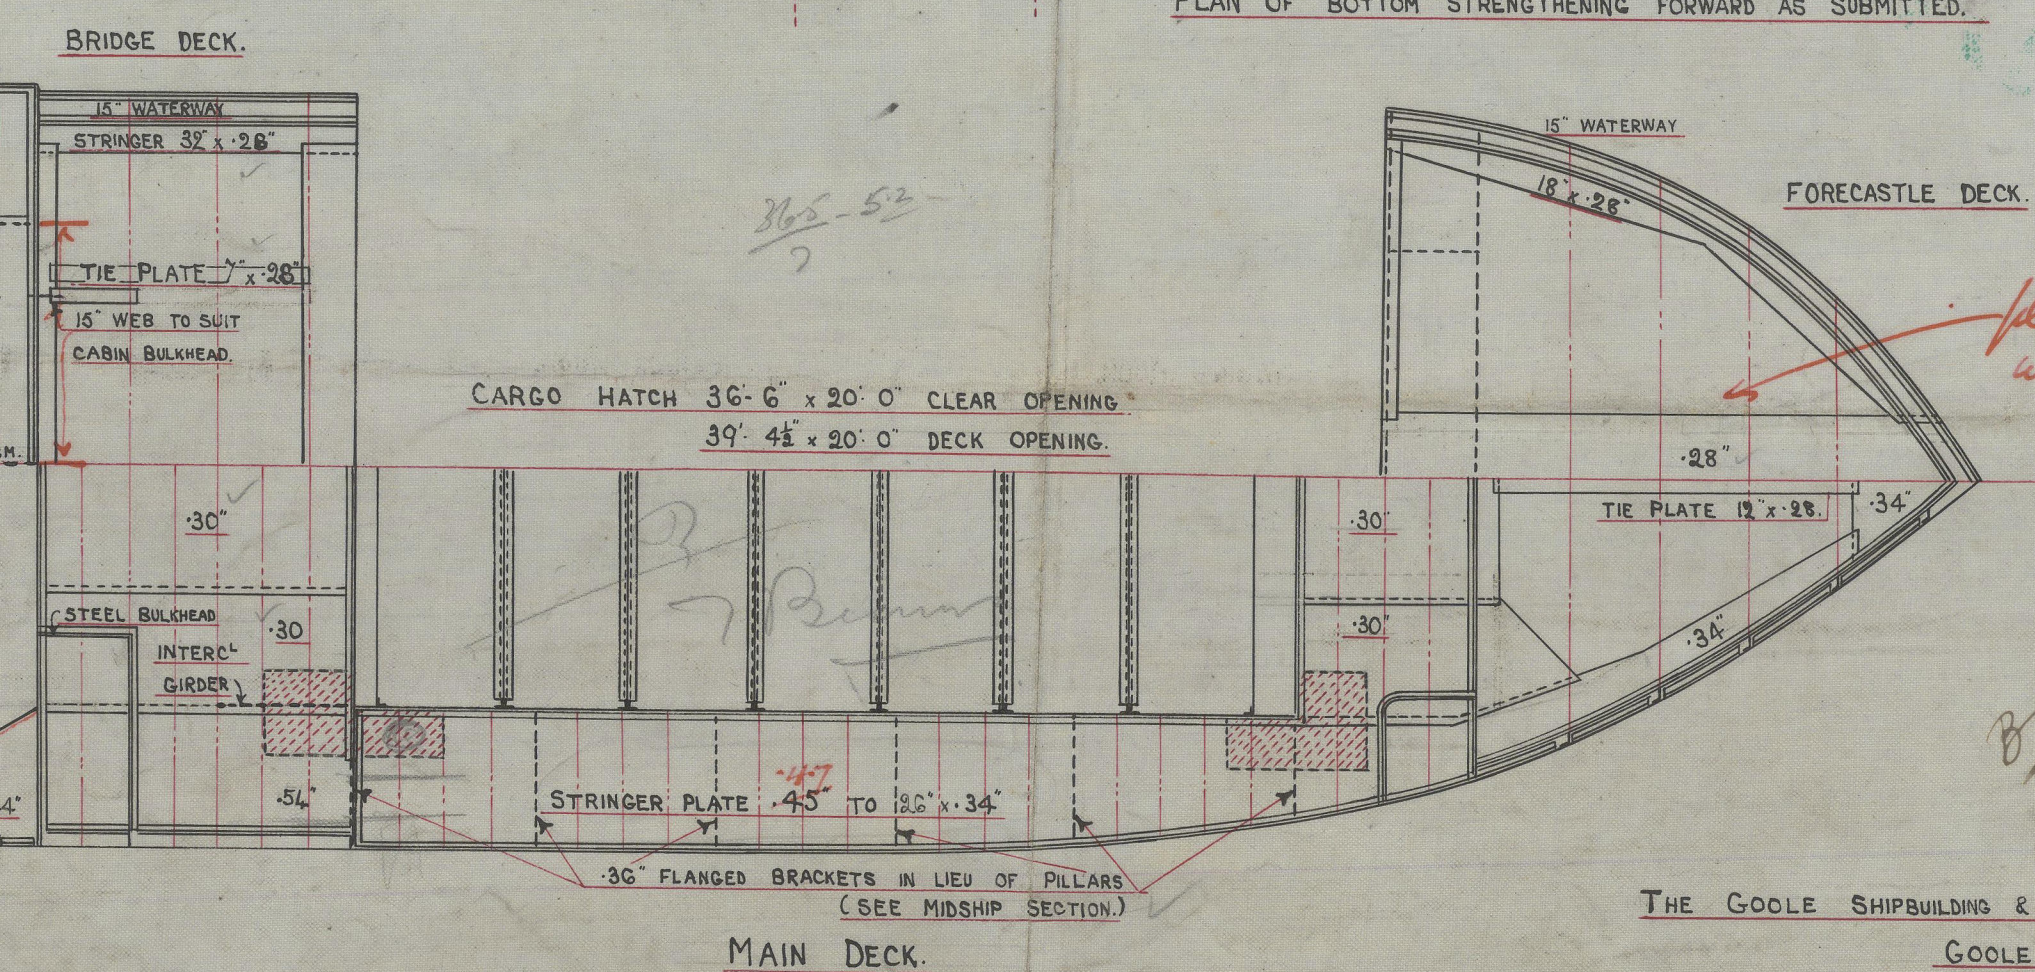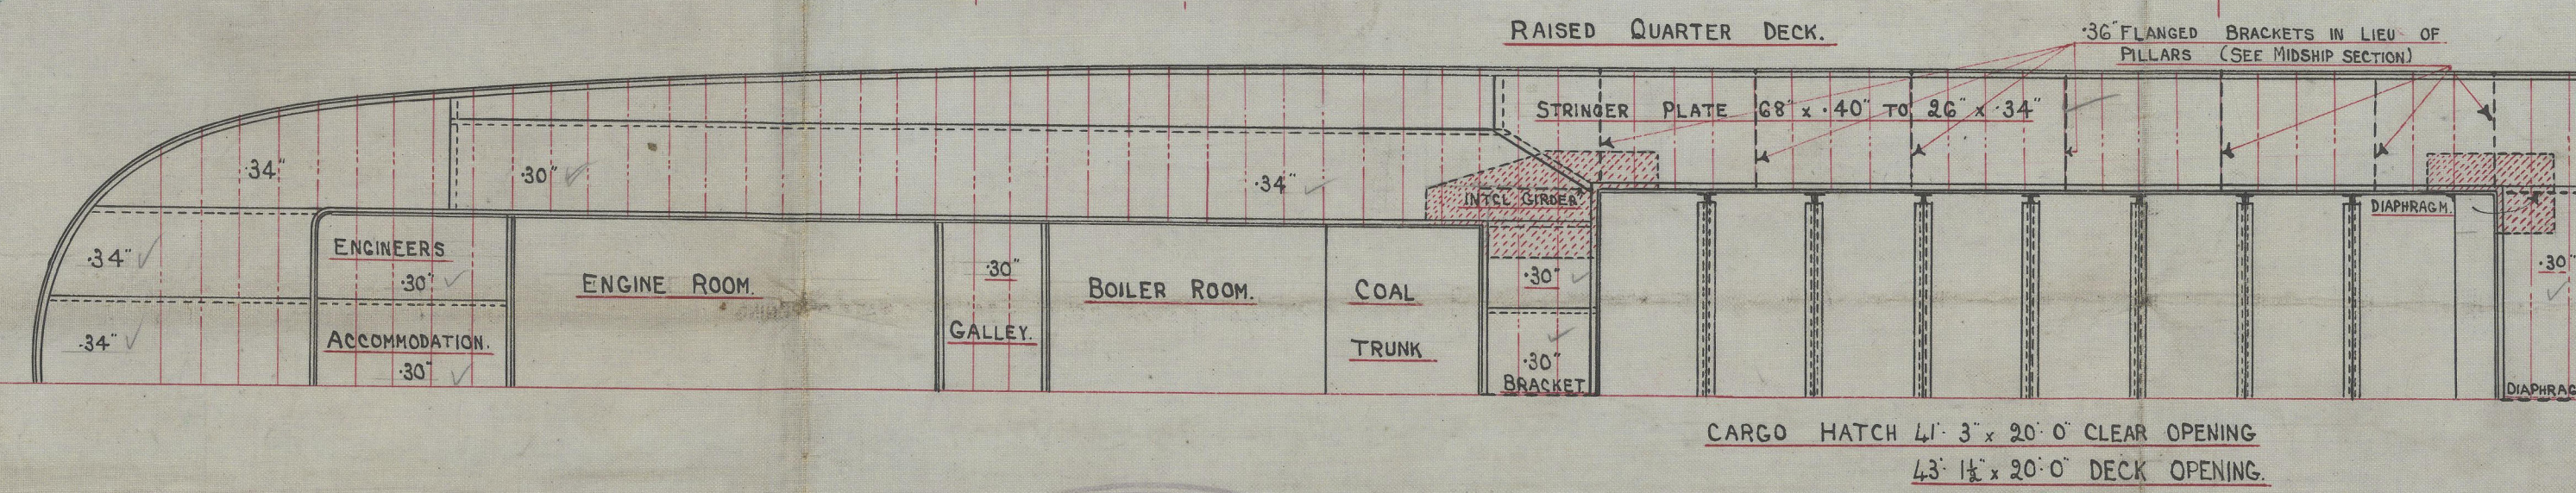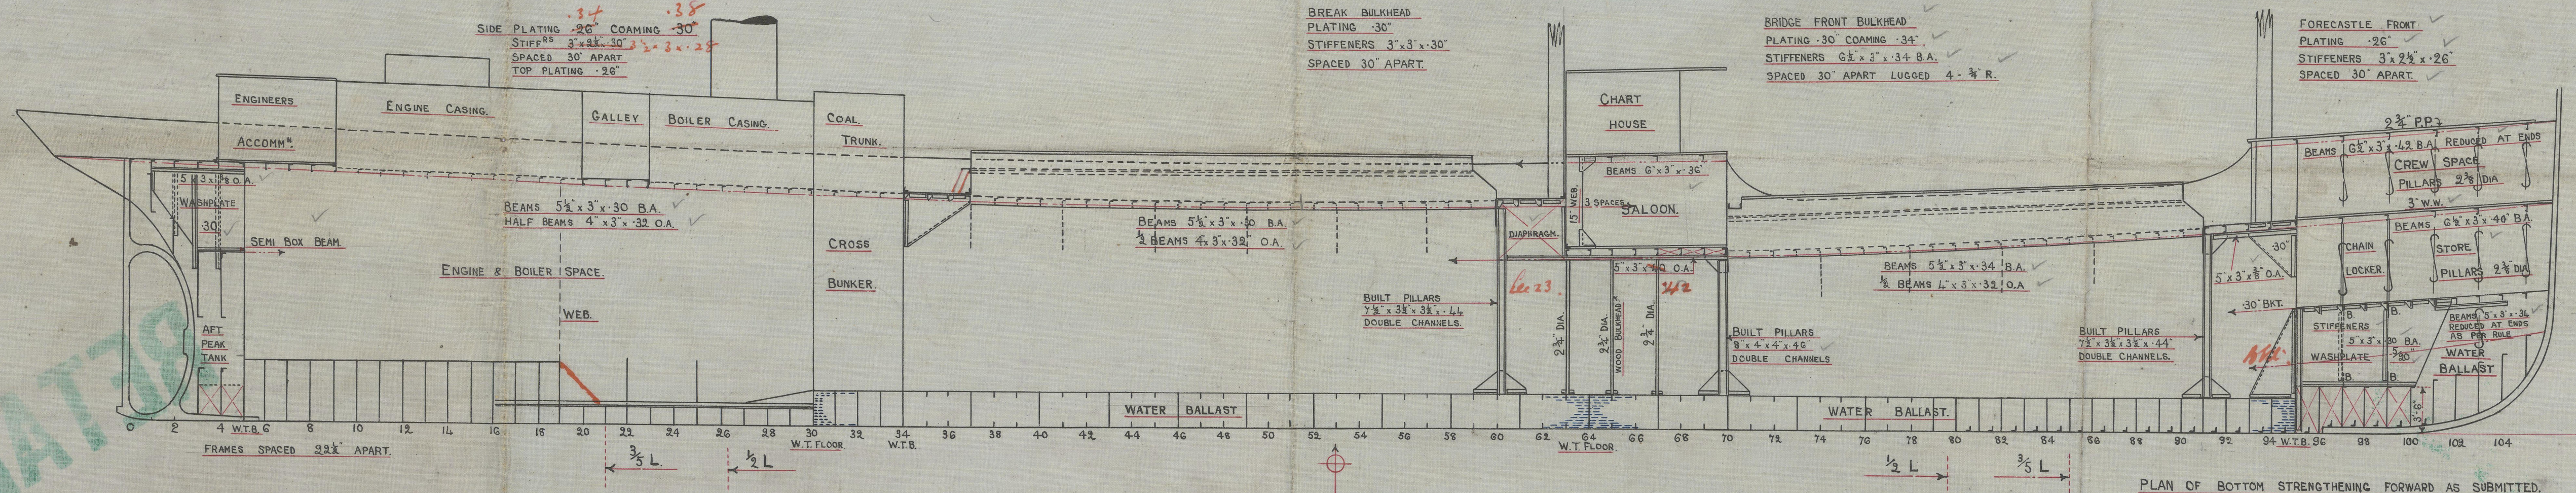

GOOLE SHIPBUILDING & REPAIRING CO. LTD.
DR. No. 1 A.
SS. No. 252
DEC 18TH 22
GOOLE

THE GOOLE SHIPBUILDING & REPAIRING CO. LTD.
GOOLE.

W443-9161

Crook & R Co

Amended
Profile & Decks

No 252

1/2 Harbry
Hull Rpt. No. 34998

RETAINED



© 2020

Lloyd's Register
Foundation