
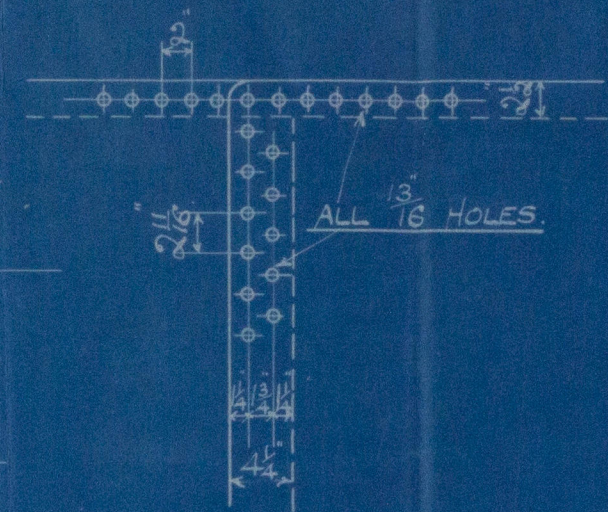




30/12/22

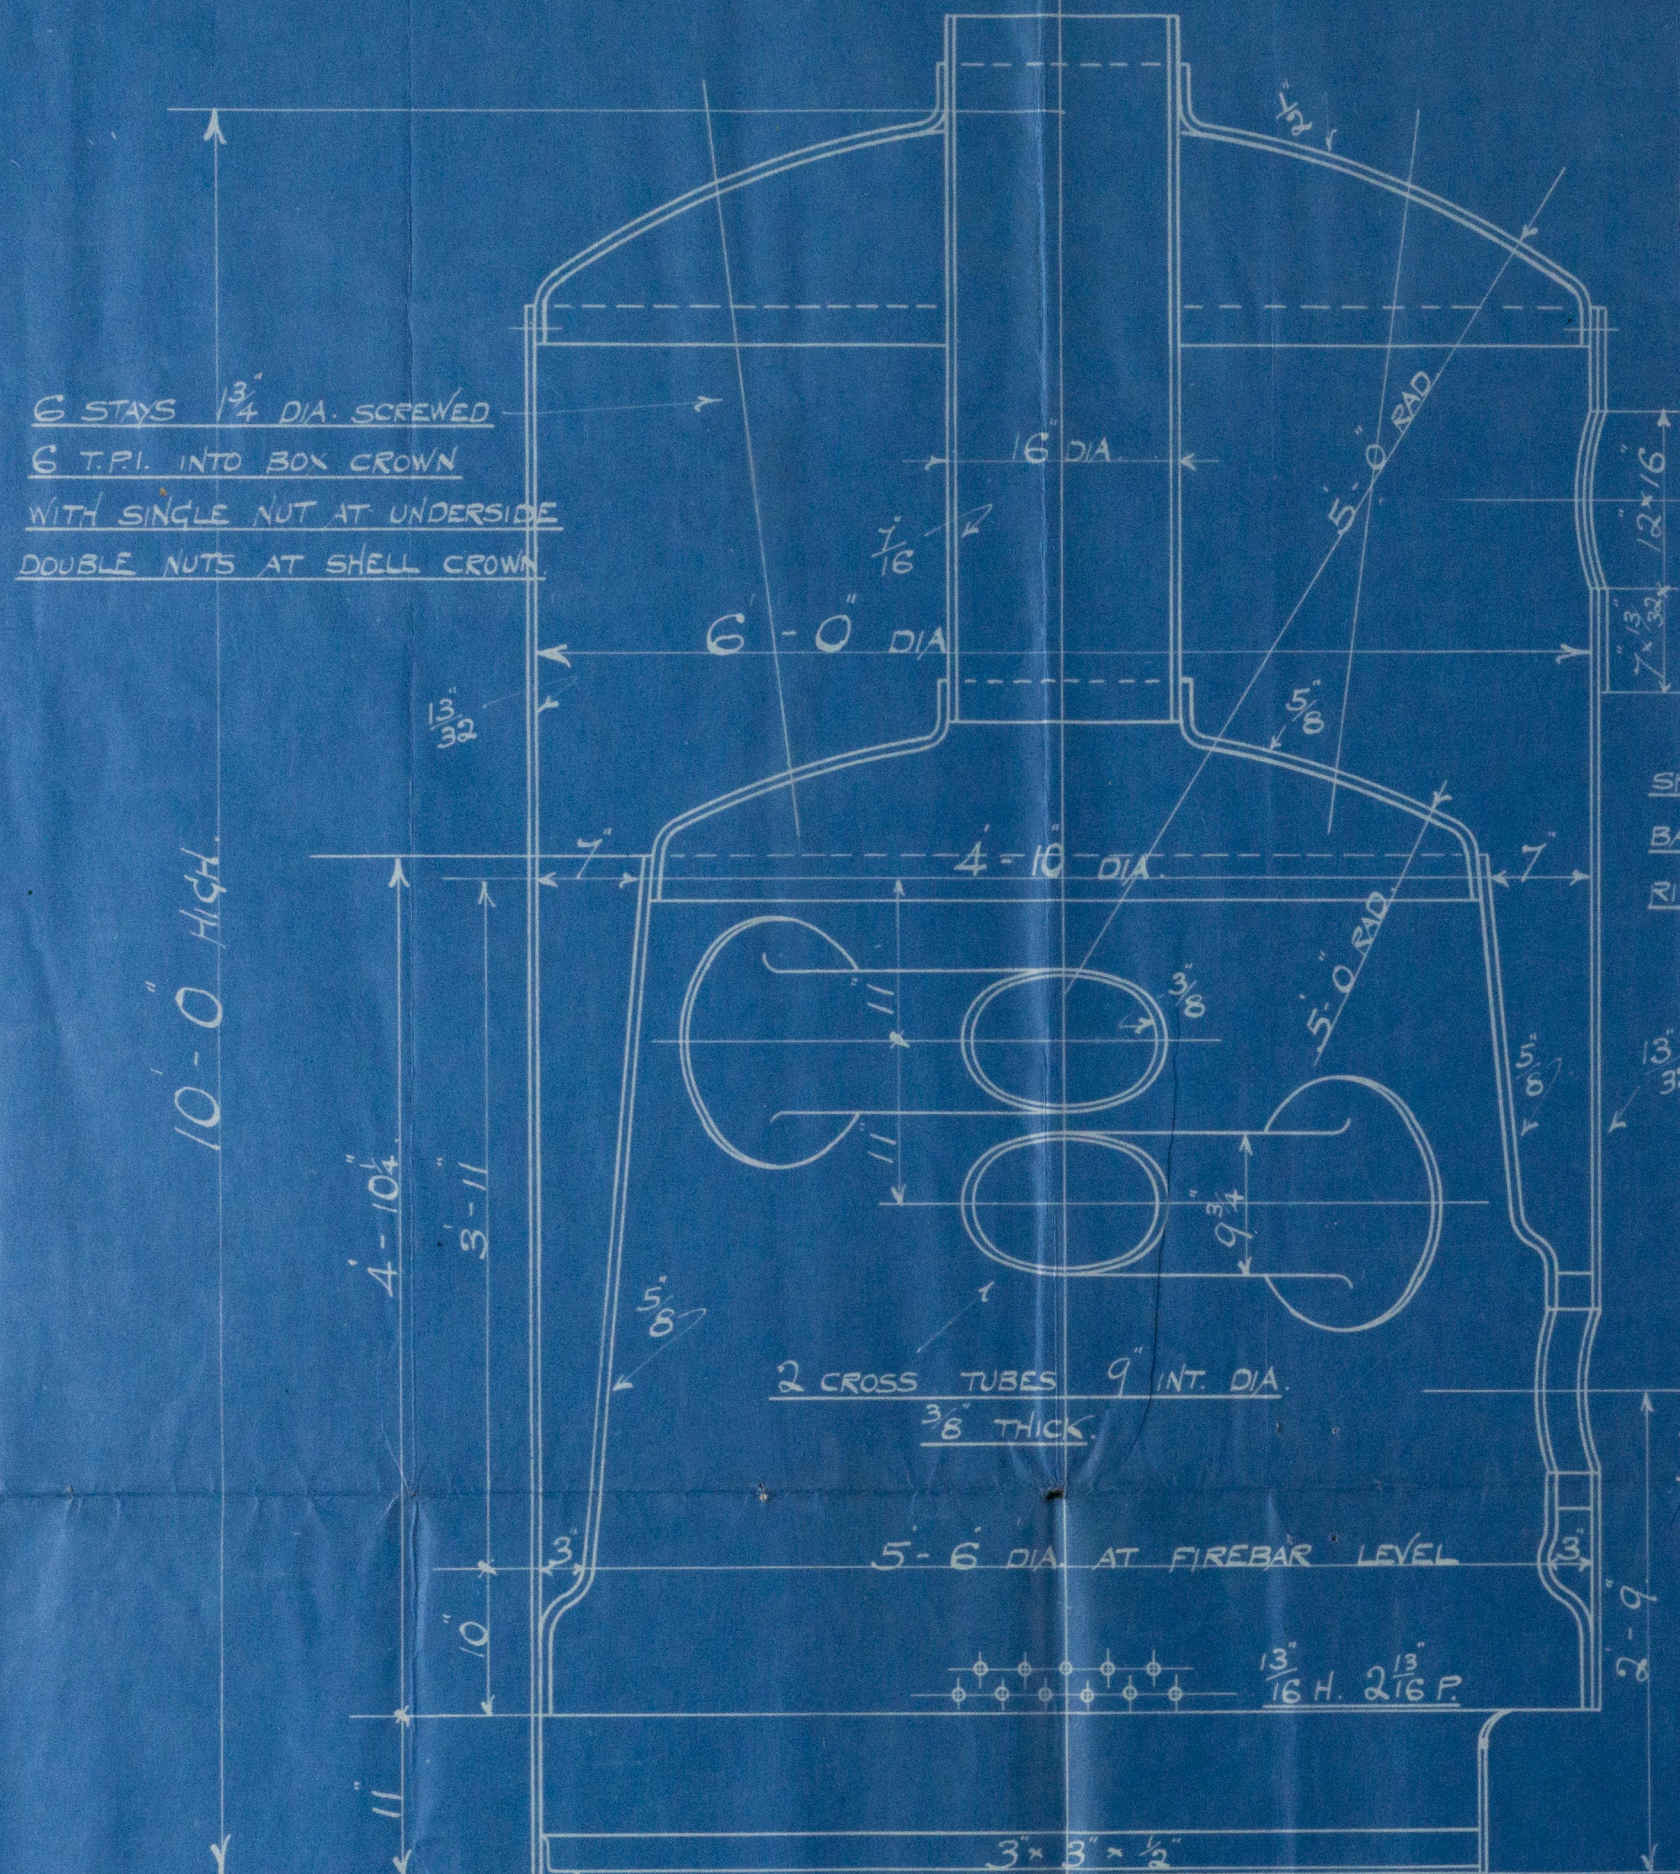

SHELL & COMPS RING	28 TO 32 TONS.
BALANCE OF PLATES	26 - 30 "
RIVETS & STAYS	" " " "

15x11 FIREHOLE
RING $2\frac{1}{2}$ x $2\frac{1}{2}$

HEATING SURFACE 106 #
CRATE AREA 22.5 #

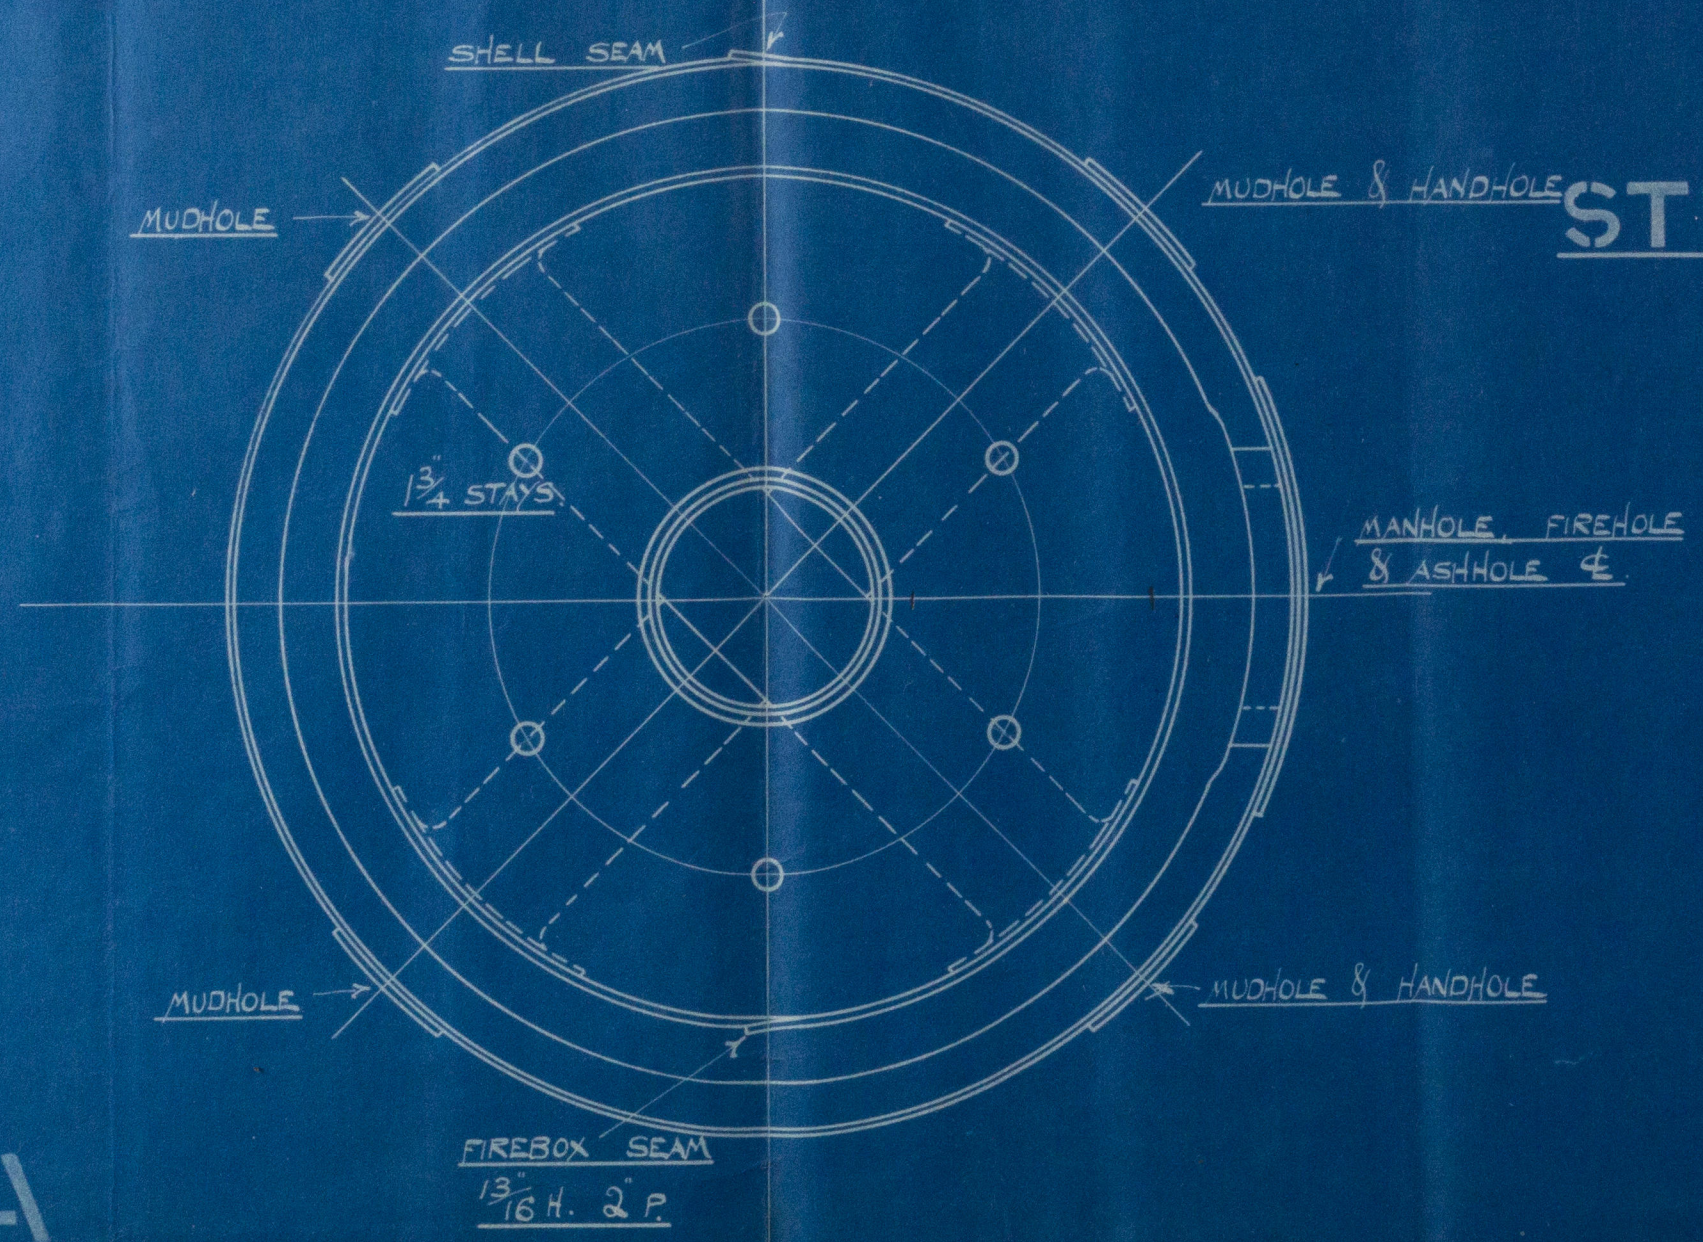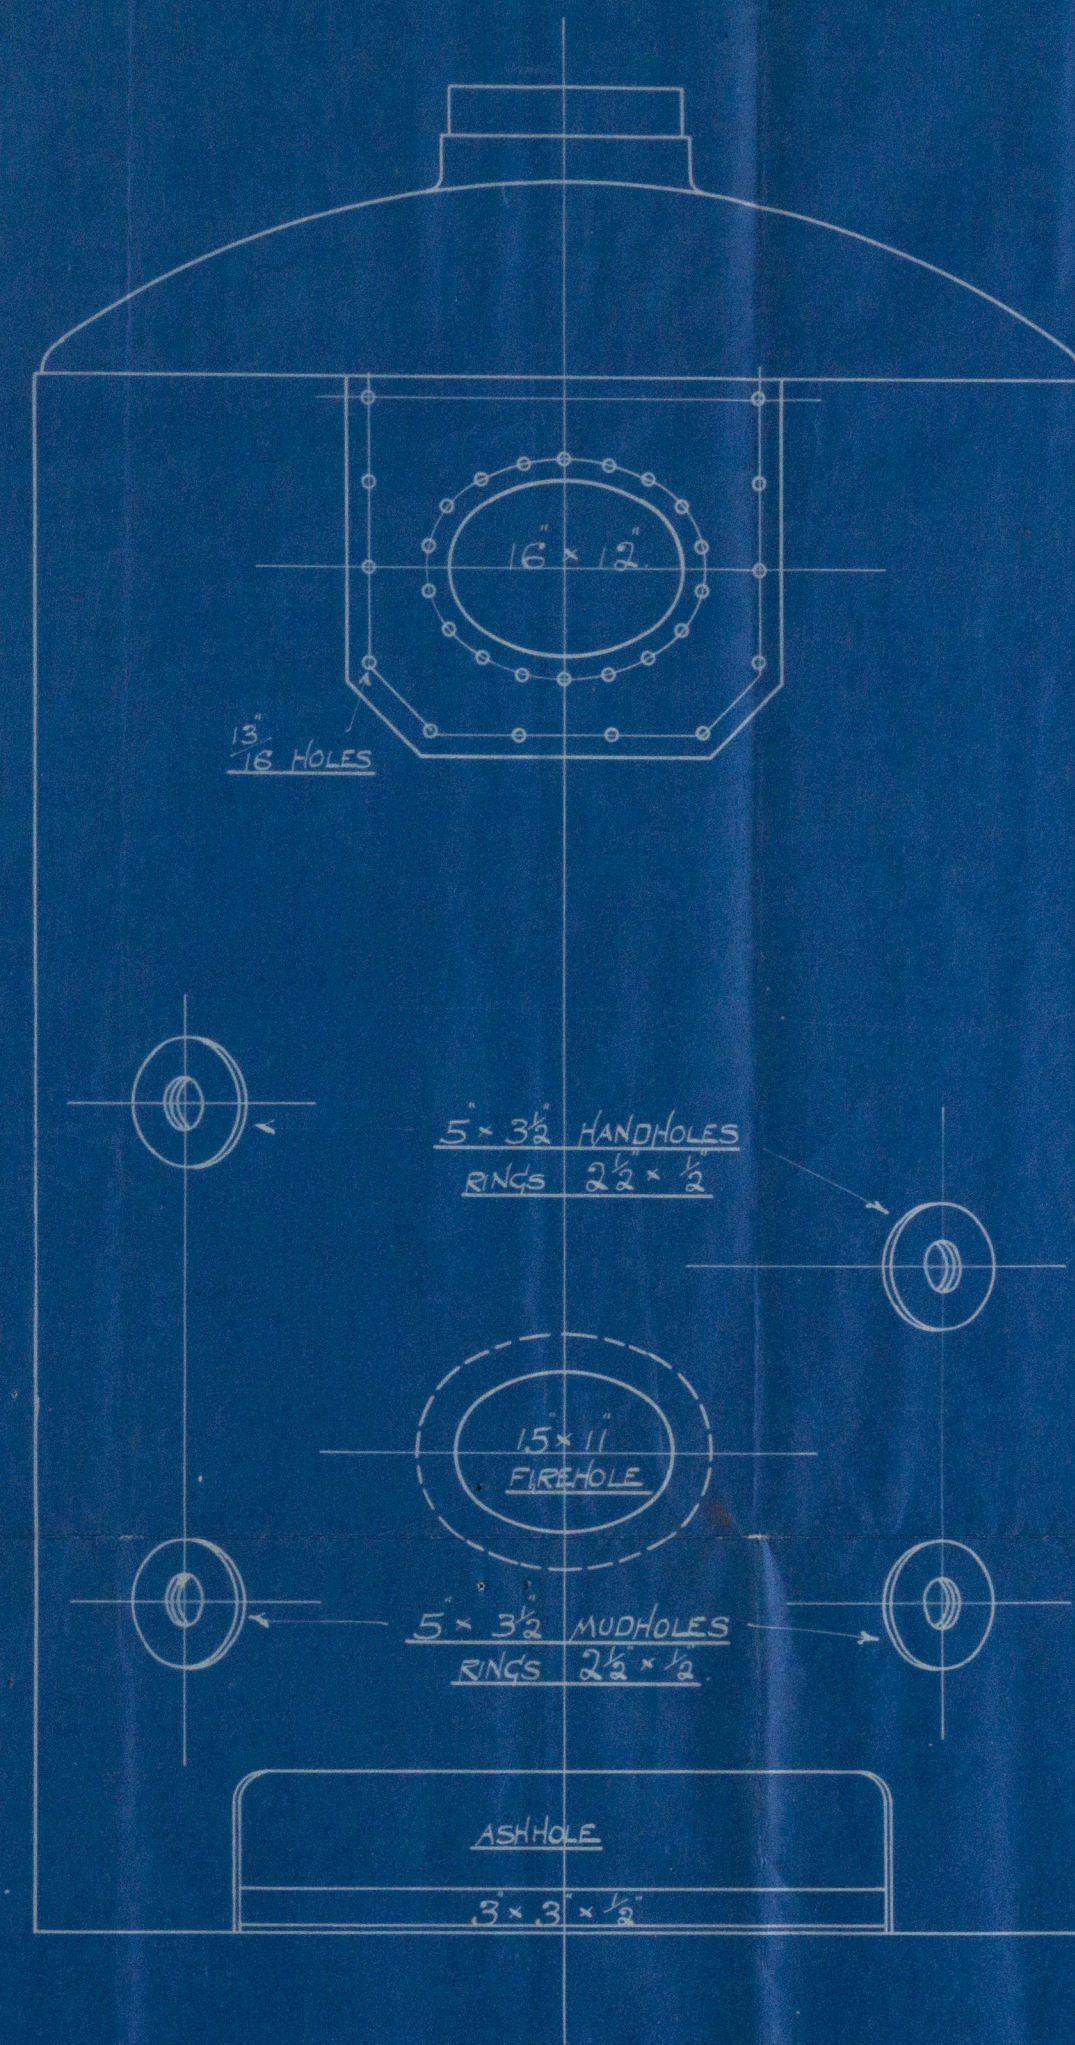

STEEL BOILER 6-0 DIA 10-0 HIGH

100 LBS W.P. LLOYDS

5440

RILEY BROS. (BOILERMAKERS) LTD.
STOCKTON ON TEES.

30-12-22

201A

LR

Messrs Riley Bros Firm

Binder No. 5440

for

Messrs The Goods S. B. Co's

S.S. No. 252

Working Press 100 lbs

No.	6295
LLOYD'S TEST	
200	lbs.
WP 100	
4.4.23-W.M.	

Middlebrough Report No.

11526

St. "Hardy"

Sub. 34998.

RETAIN



© 2020

Lloyd's Register
Foundation

W443-0163