


N°1451

PROFILE & DECK PLANS. -SS. "SEA VENTURE"-

SCALE 1/8" = ONE FOOT

LENGTH 290'-0" * BREADTH MOULDED 42'-10" * DEPTH MLD 20'-10" TO UPPER DEK.
CLASS * 100 A.I. LLOYDS.

L * D = 6040
L * (B + D) = 18461

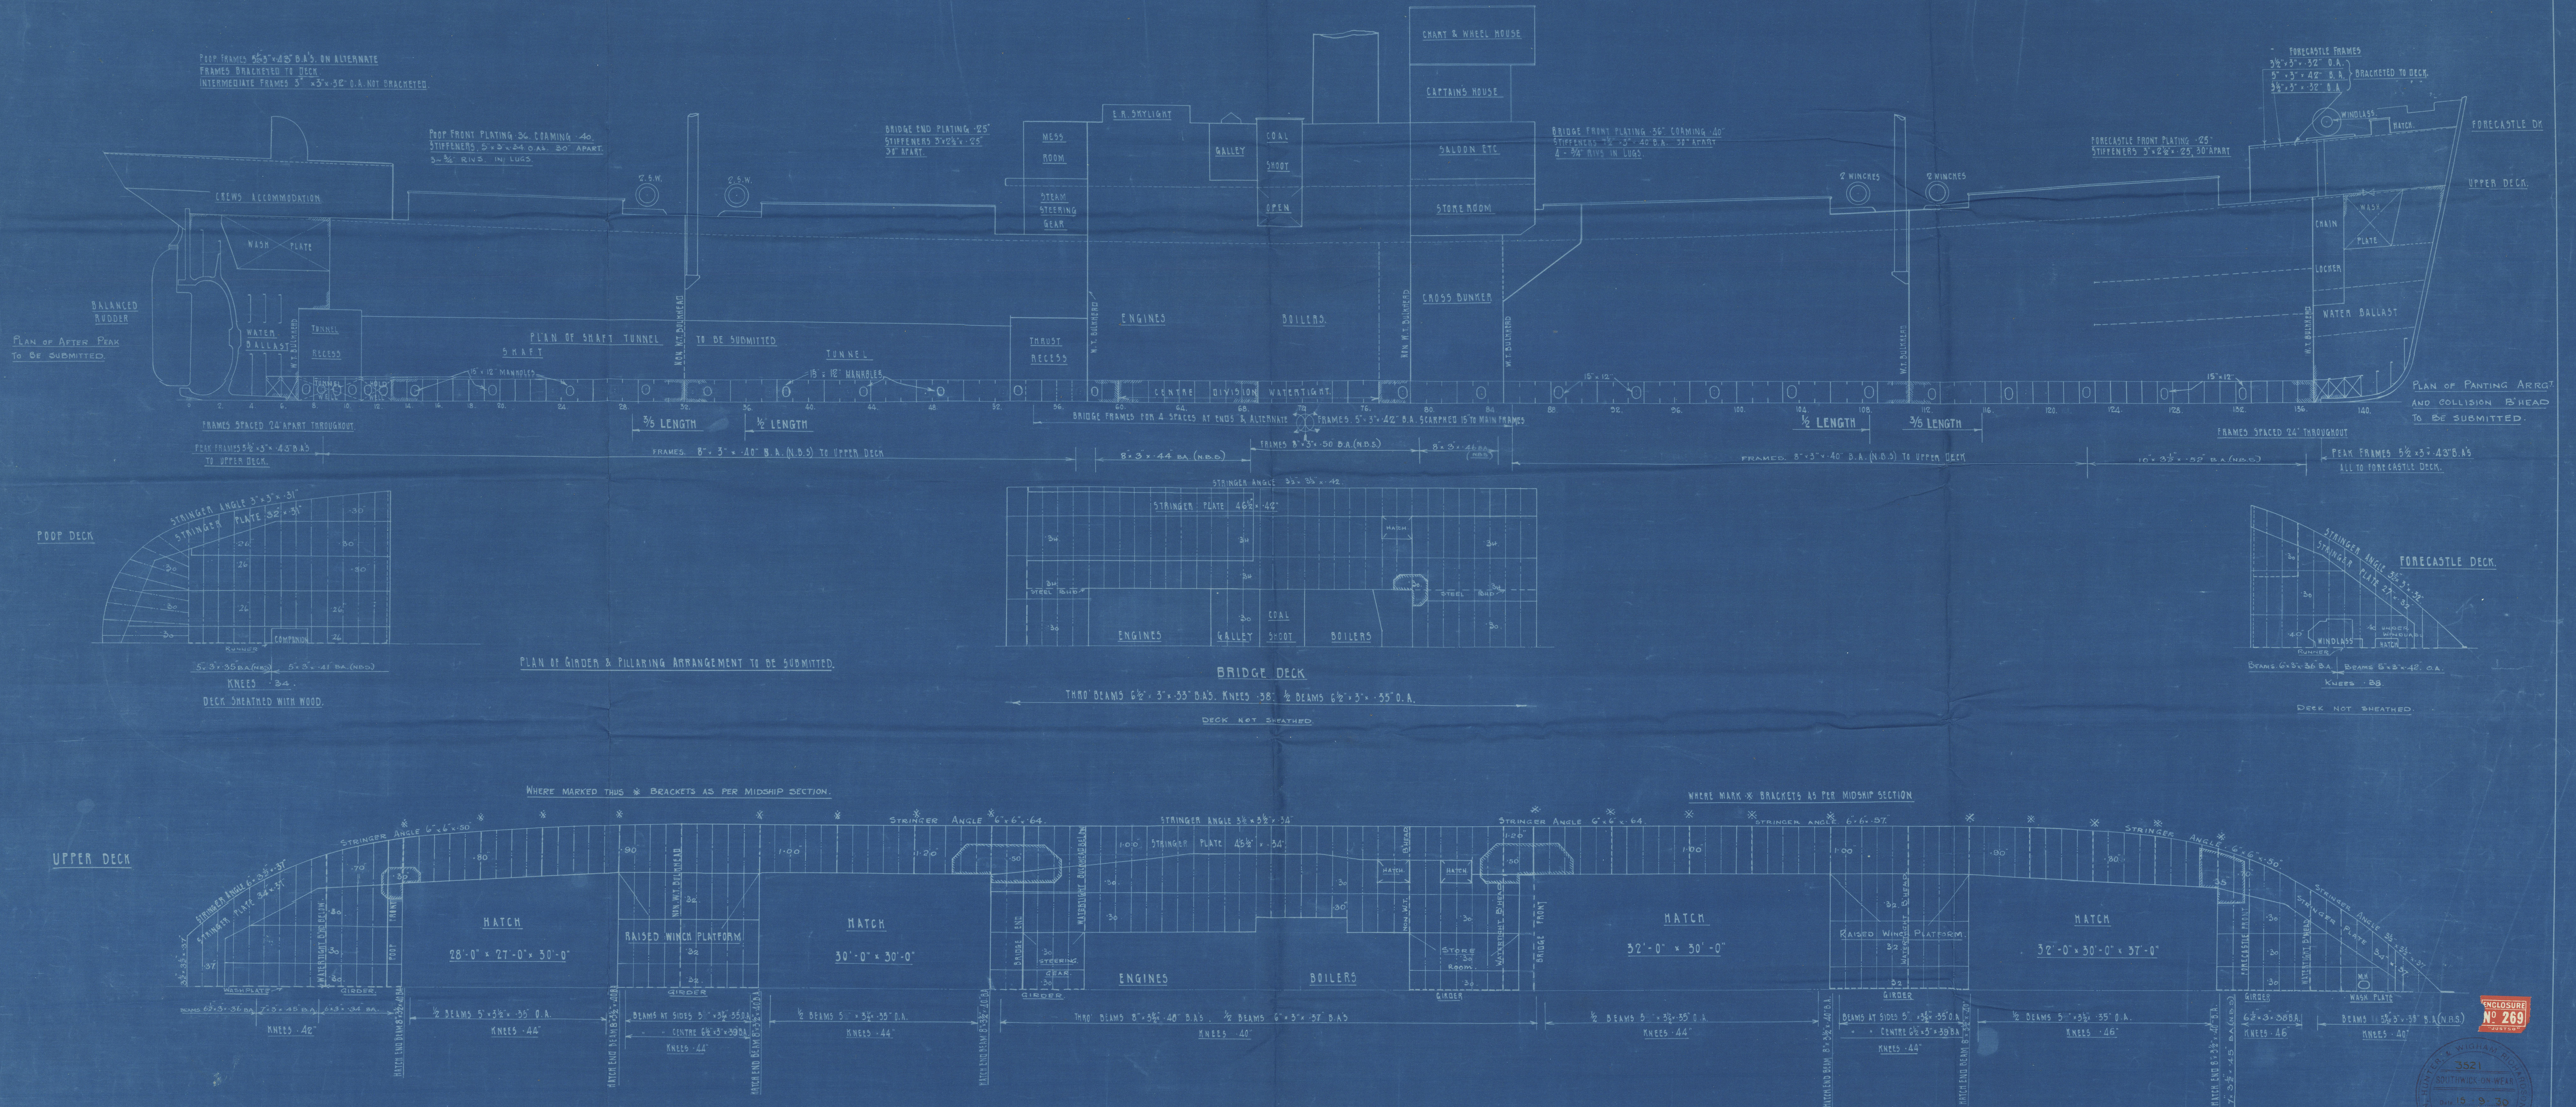

ENCLOSURE
N° 269

3521
SOUTHERN OIL WEAR
15-9-30

SUNDERLAND

SWAN HUNTER & W. R. L^D

YARD N^o 1451

S/S. SEA VENTURE

PROFILE & DECKS (AS BUILT)

SUNDERLAND PRT. NO: 30464

REMAIN



© 2020

Lloyd's Register
Foundation

W443-0224