




19.1.18

N.V. Machinefabriek
v/h Schipper & van Dongen.
Geerthuizenberg (Holland)

Afleiding voor Machine N^o 50. Schaal 1:10.
Met Attest ~~Bureau~~

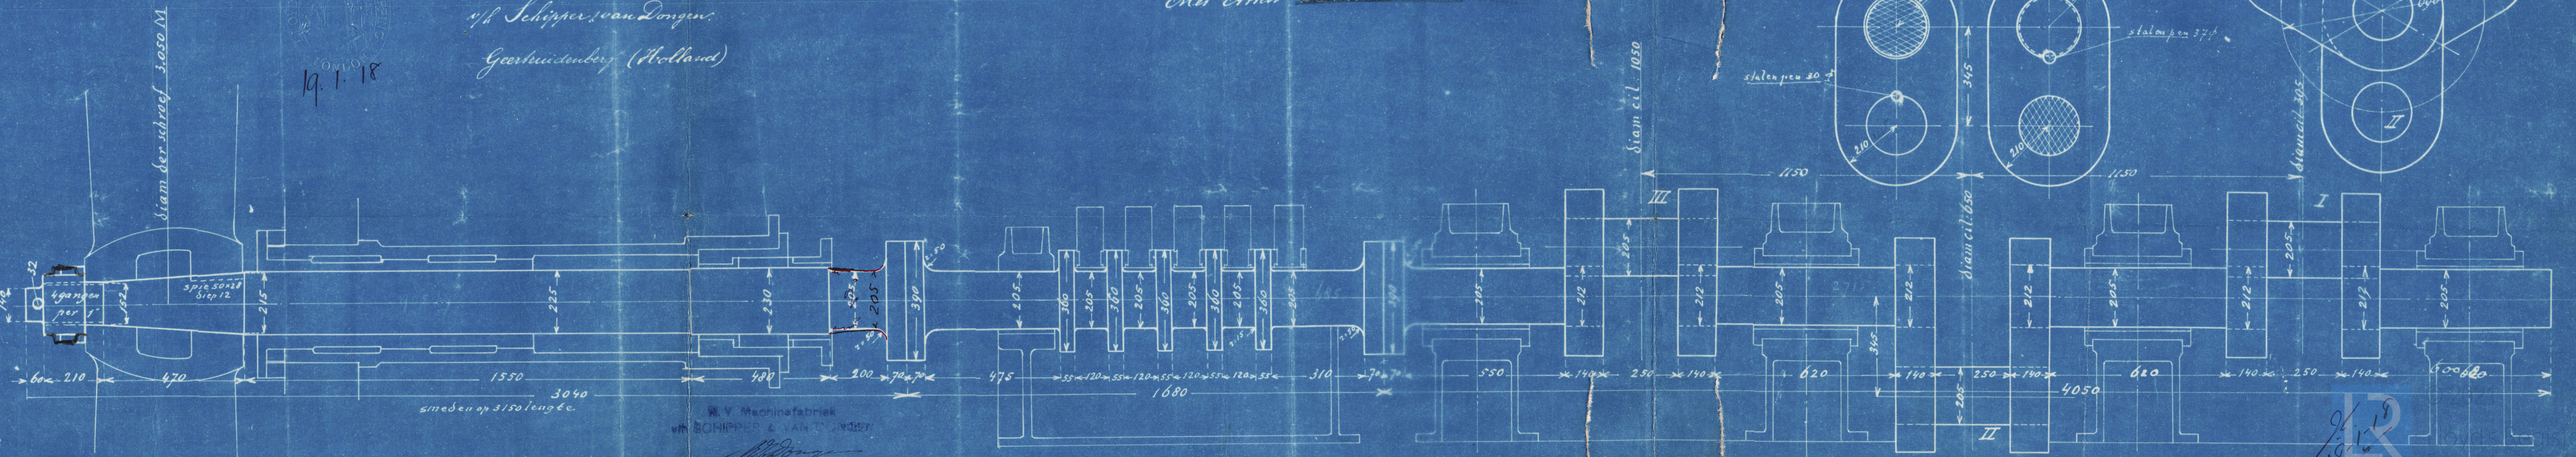

W. V. Machinefabriek
v/h SCHIPPER & VAN DONGEN

19.1.18

Lloyd's Register
Foundation

W445-0033

Amended plan of
SHAFTS
Album Schippers & Drogen
Eng n^o 50
for
Album Scheepbouwerij
de Elberwed's Yards n^o 129
Rep N 10957 ⁶



RECEIVED

W665-0033



© 2021

Lloyd's Register
Foundation