

# MIDSHIP SECTION.

Dim: 180'-0" B.P.P x 28'-0" x 14'-6" M<sup>2</sup>

TO CLASS 100 A1, LLOYDS.

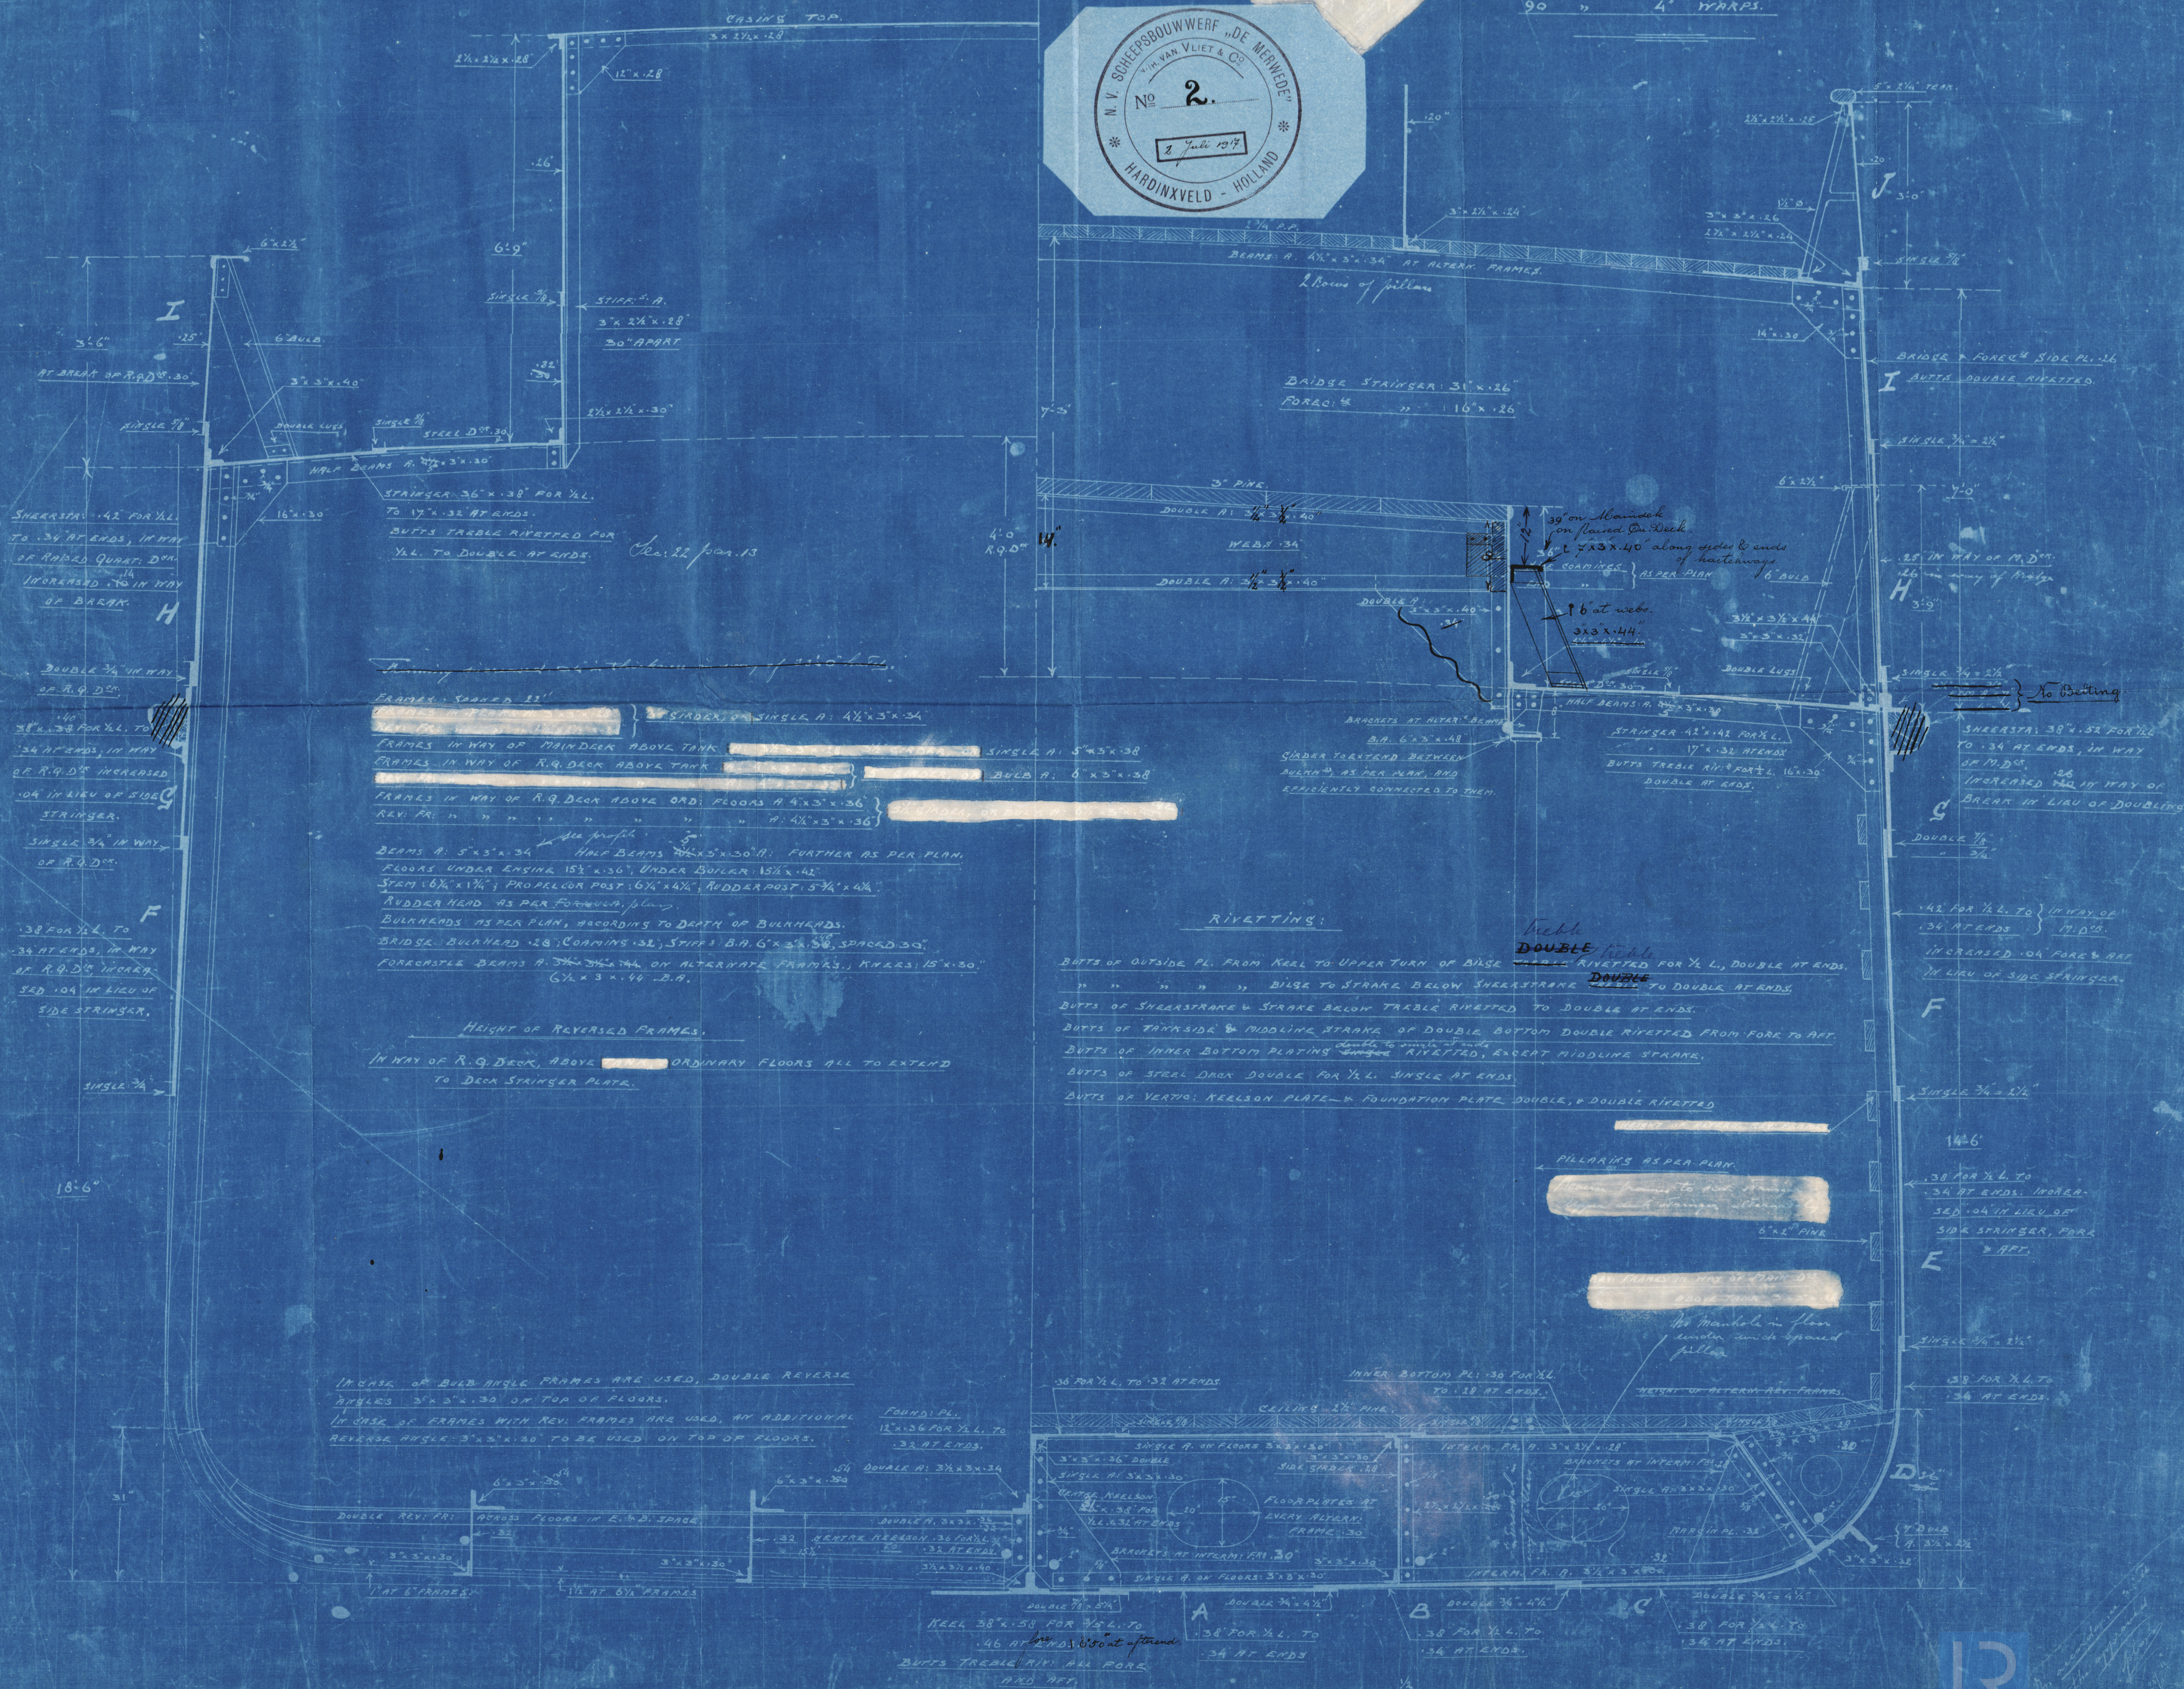
-SCALE  $\frac{3}{4}"=1 \text{ FT.}$

EQUIPMENT № 8379.

$$Lx(B+D) = 7650 + R.Q. DECA = 104,6 \times 4 + FORCEC^4 = \frac{3}{4}(17,75 \times 6,75) +$$

$$BRIPSC = \frac{3}{4}(11,1 \times 7,1) + CASINGS \frac{1}{2}(18,6 \times 6,75) = 8379,5$$

## NUMERALS:

$$\beta + \Delta = 42,5$$
$$L/D \text{ to } \eta_{\text{min}} O^{\text{st}} = 12,4$$






For London Office

Gen Box 2286.

*Begonia*

Vol. 10957.

RETAIL

WHL5-0035

© 2021



Lloyd's Register  
Foundation