
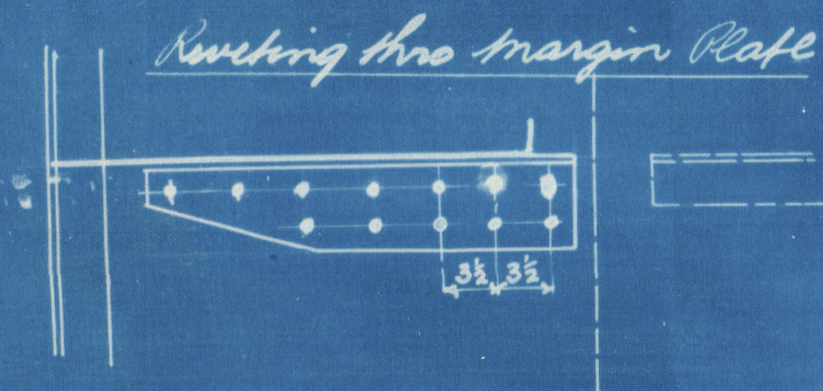
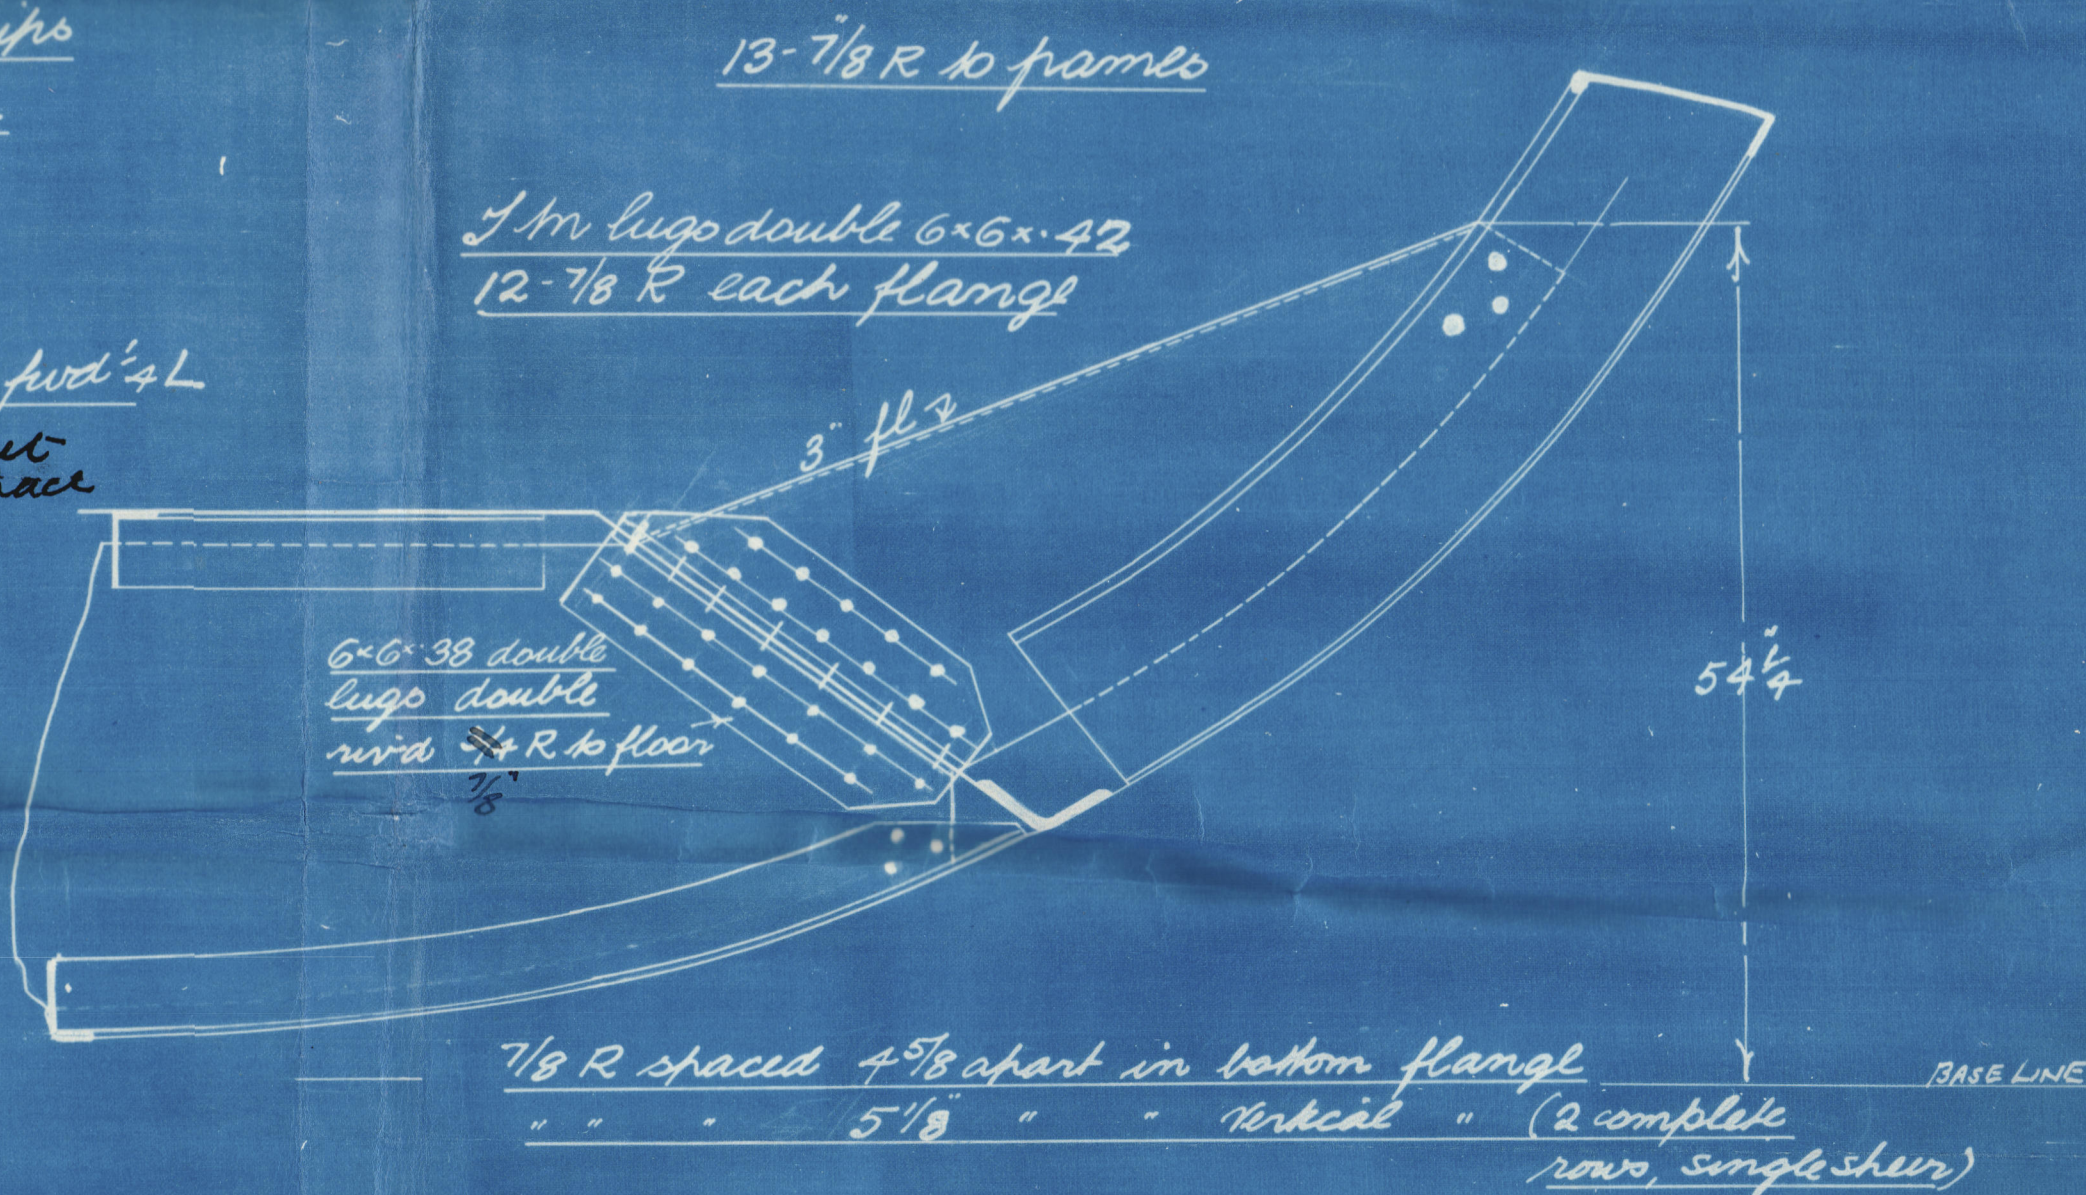


Tank Brackets No 148
as in shop
Scale 1" = 1F'

Midship tank knees

Lanting frame knees

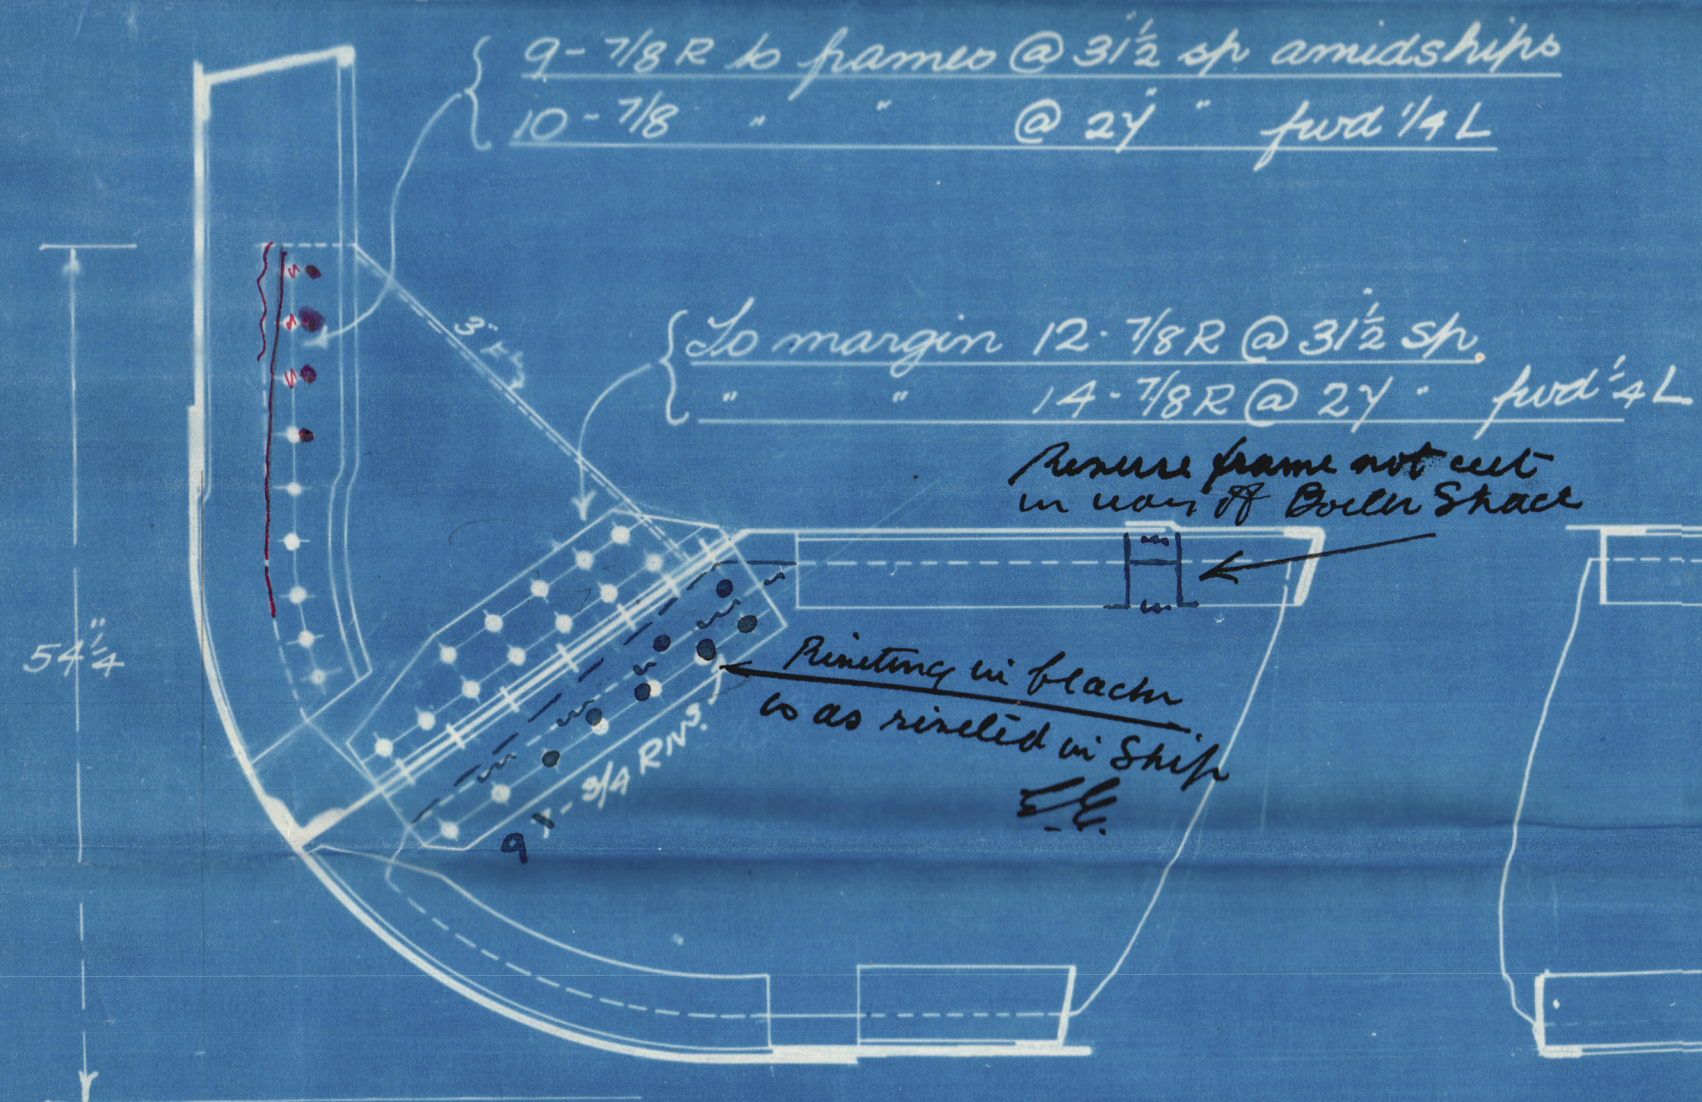

Nº 1956 PRINT Nº 6019

APPROVED
LOYD'S REGISTER OF SHIPPING

Montgomery - 29.11.201

