


17-6-08
24-6-08
30-6-08
7-7-08

AMENDED
PROFILE S.S. 125.

SCALE $\frac{1}{8}$ " = ONE FOOT.

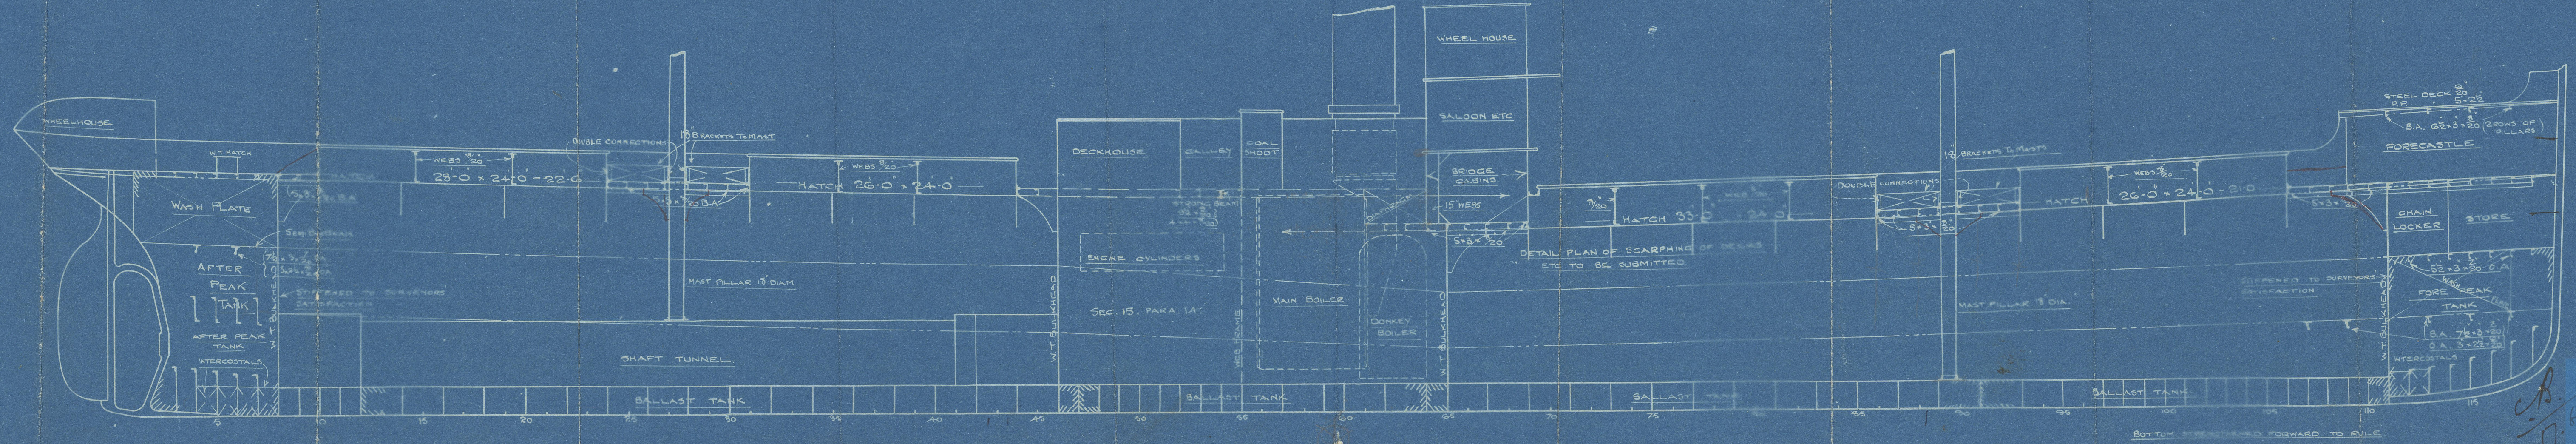

16-6-08

17-6-08

RETAIN



© 2020

Lloyd's Register
Foundation

J Priestman & Co

Bastillo Almanza, ex


No 125-1

* Greenbatt



Further amended

Profile

led 23901.

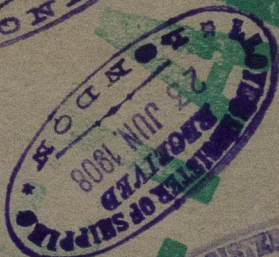

W.144-1

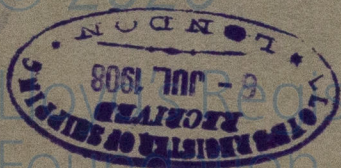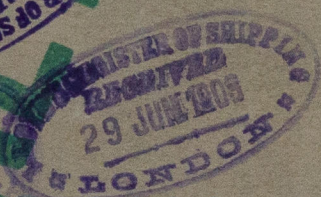

W446-0059