


LOIDS REGISTER

176.08.
24.6.08
7.7.08

AMENDED DECK PLAN N^o 125 ⁵/₈

SCALE ¹/₈ = ONE FOOT.

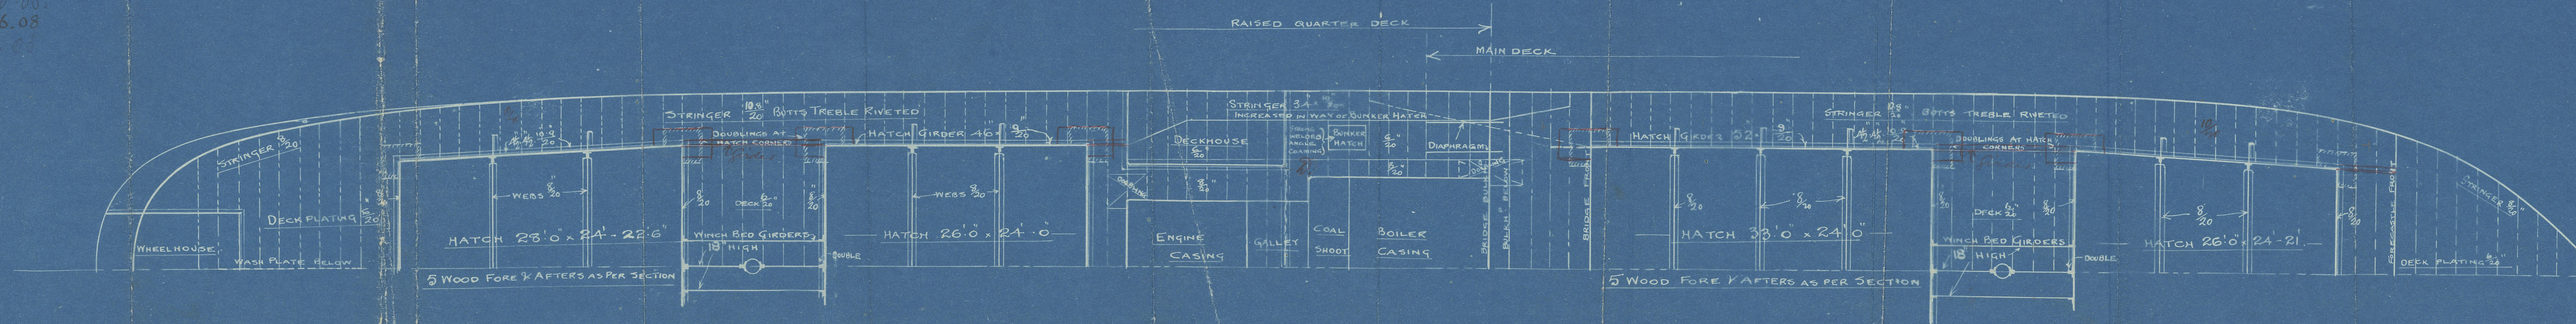

RETAIN
© 2020
Lloyd's Register
Foundation


J Priestman & Co

No 125

Further amended
Deck Plan



S/s "Greenbatt".
Sed 23901.

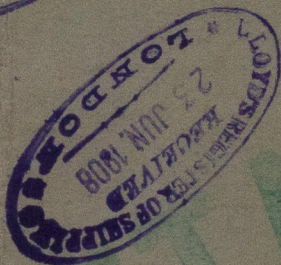

RELIABLE

© 2020

Lloyd's Register
Foundation

W446-0061